


12. 8. 97
10. 11. 97


500-2282-0105

*Proposed
lengthening
of
S.S. Angelo*

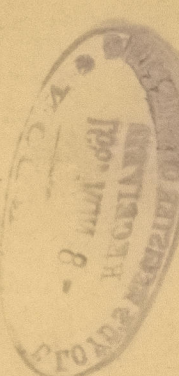



Present Rule dimensions 64'8" x 18'0" x 8'0 1/2"

Midship Section
of
S.S. Angelo
Lengthened by 20 feet amidships.

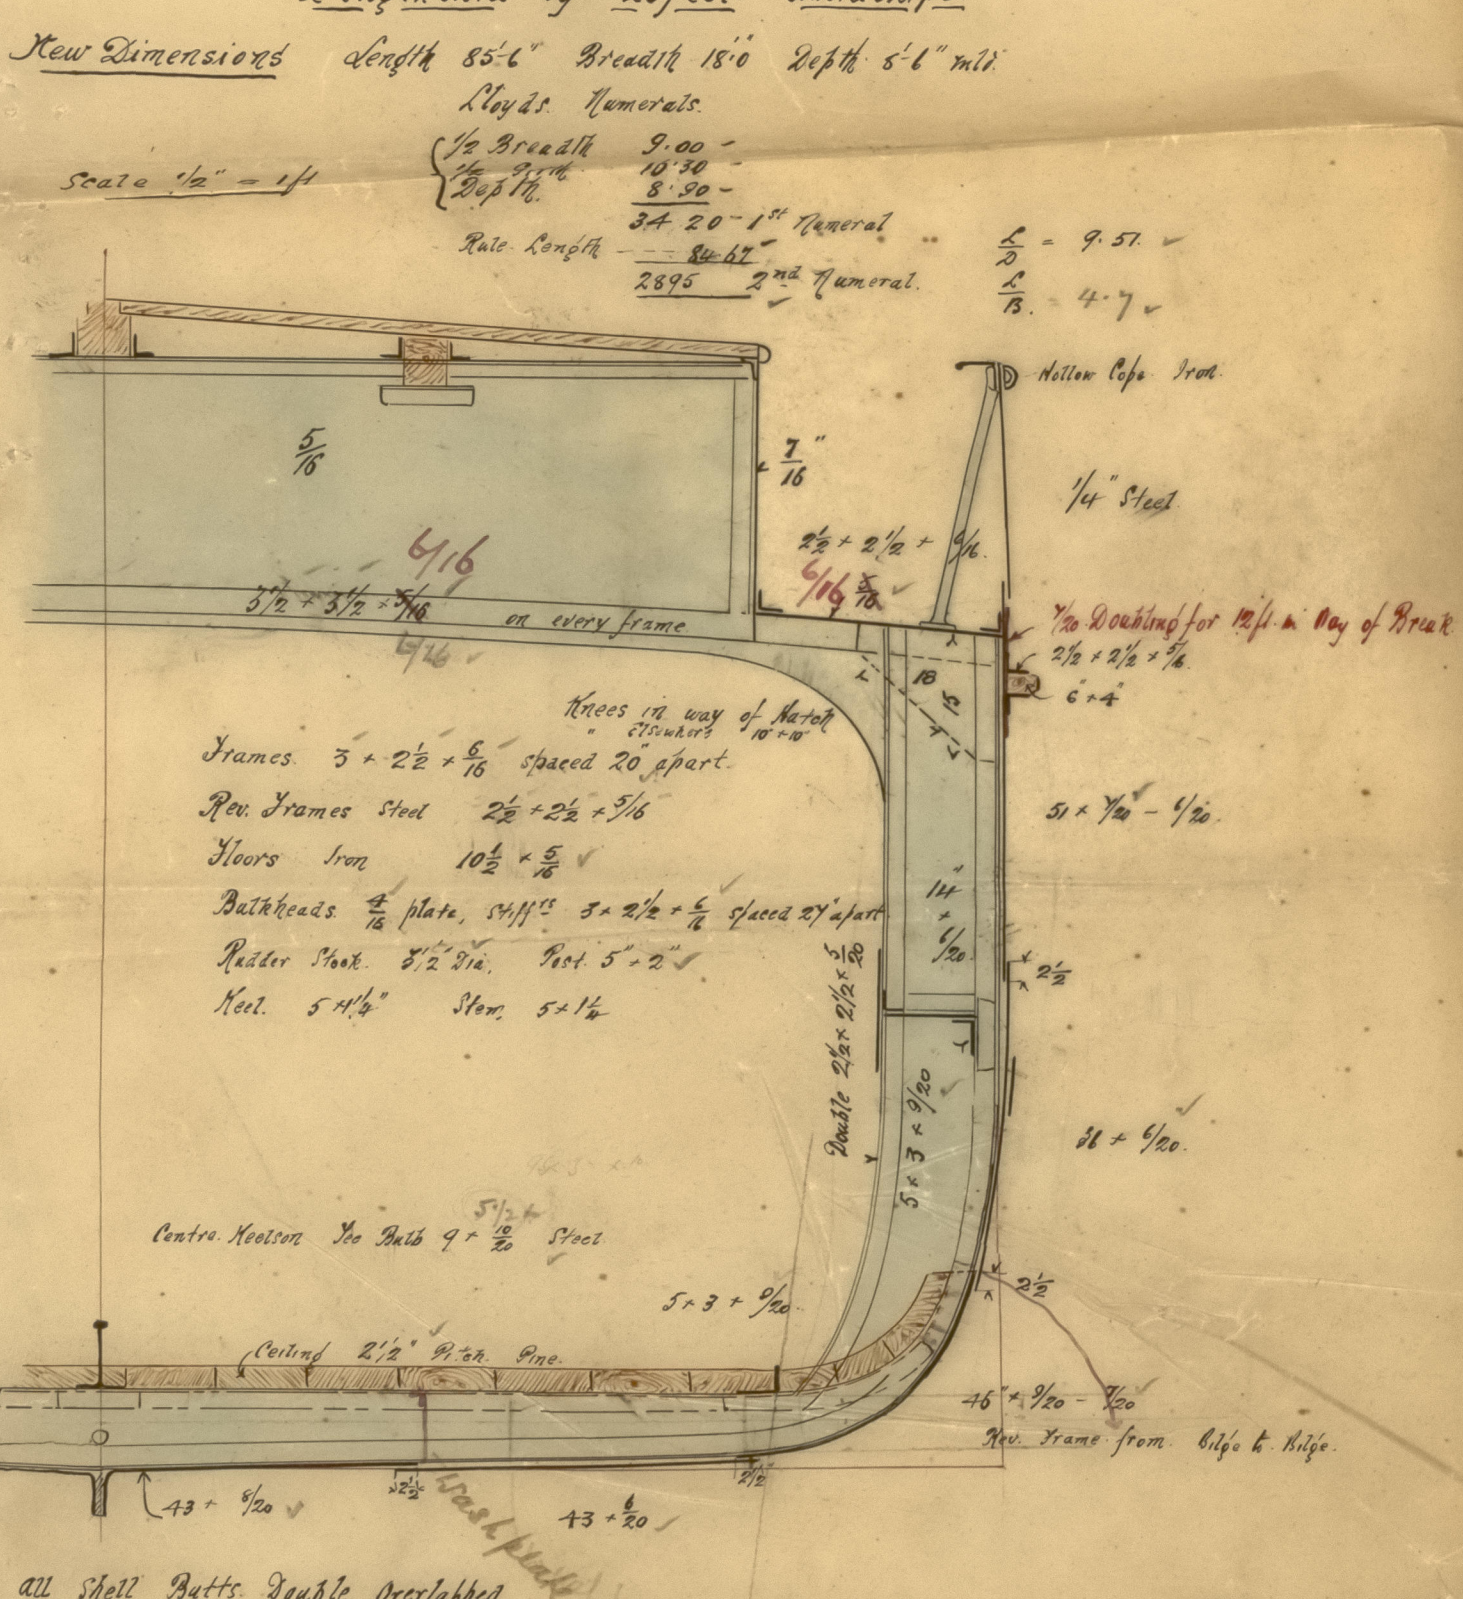

S. WAINWRIGHT & CO., LIMITED.
4/8/97.

PROPOSED ARRANGEMENT
OF
S.S. ANGELO
LENGTHENED BY 20 FEET
SCALE 1/4" = 1 FOOT.

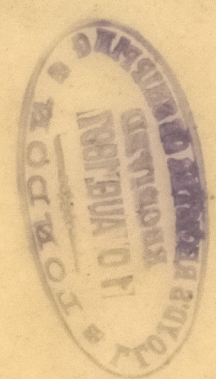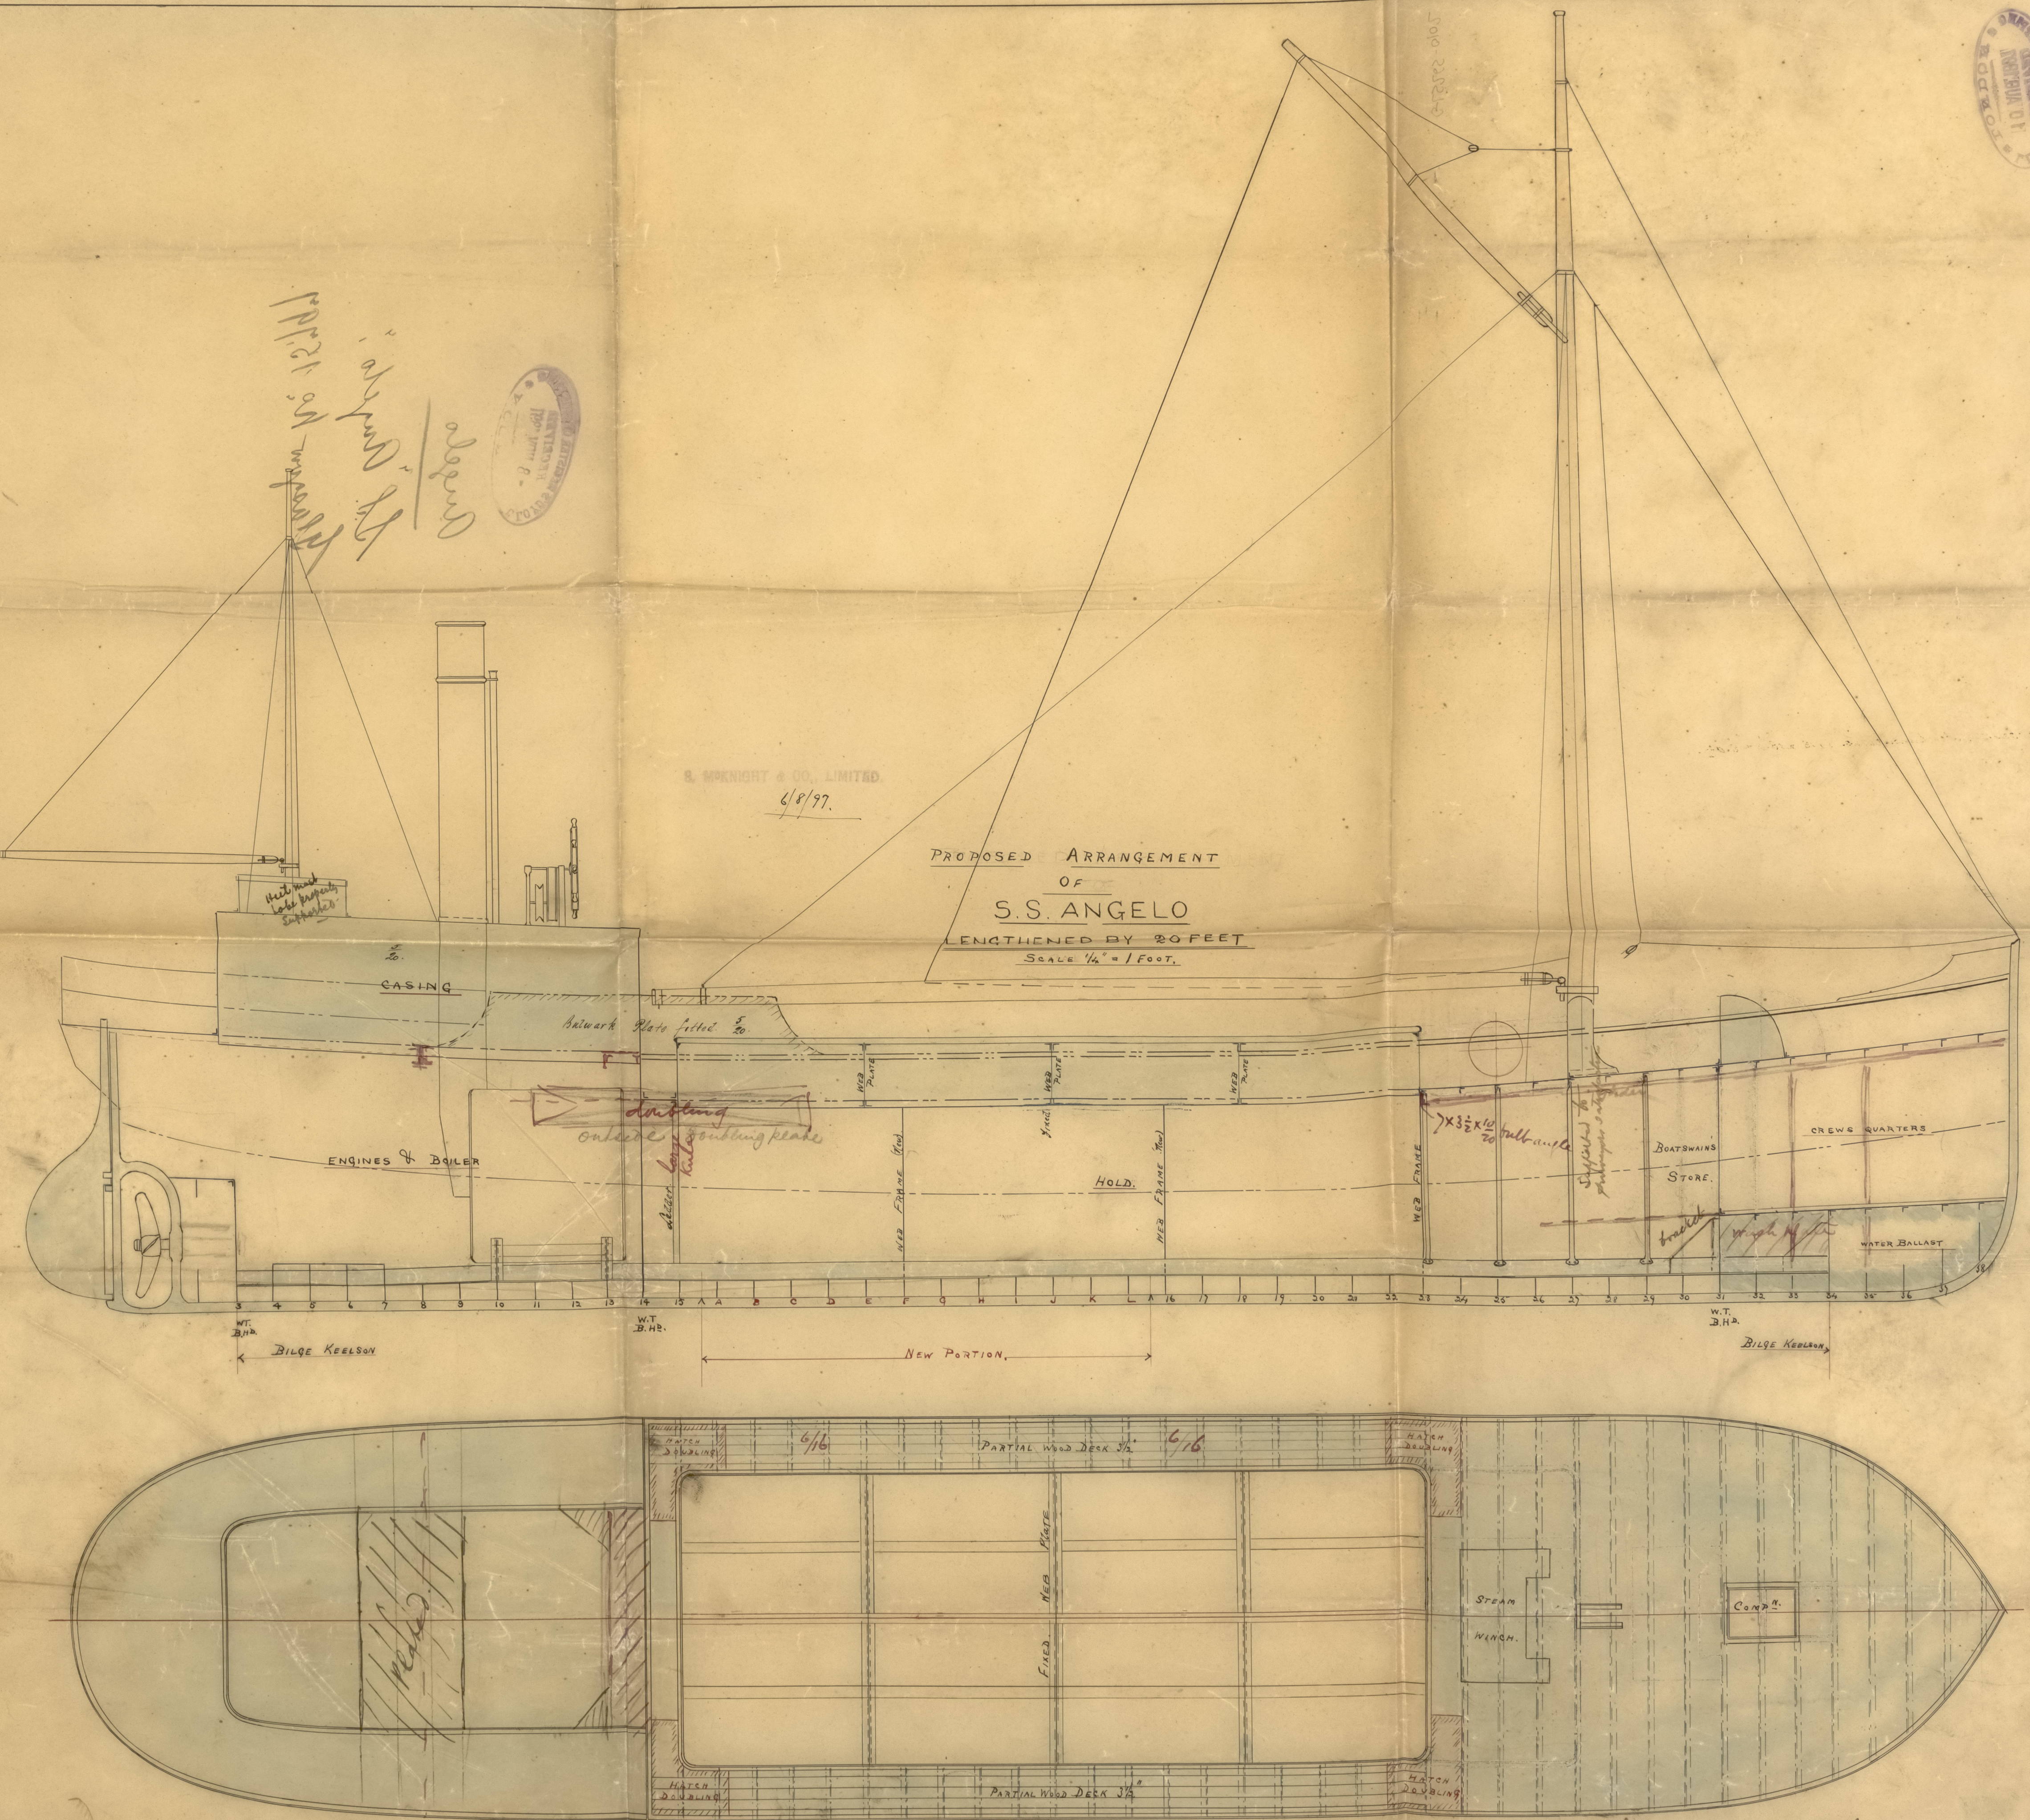

12/8/97



12/8/97

RECEIVED
10 AUGUST
LONDON



Bridge Mast

TH

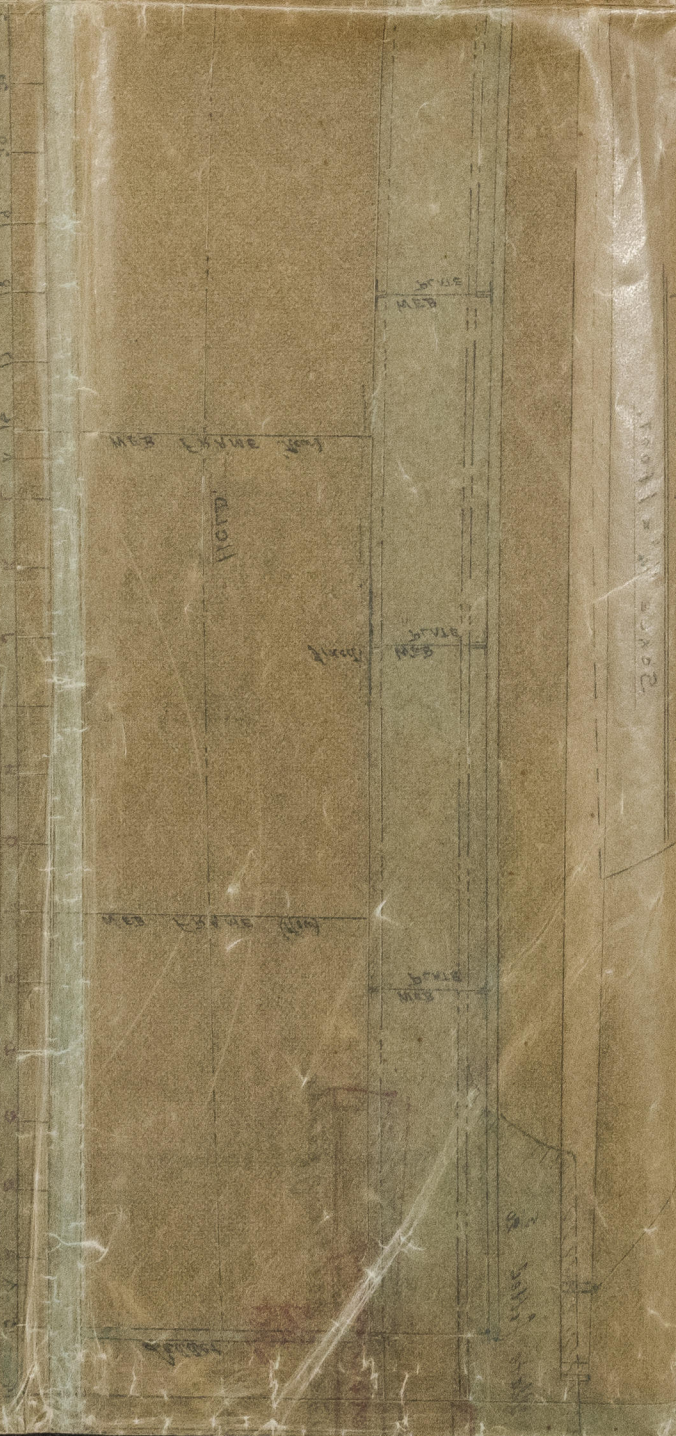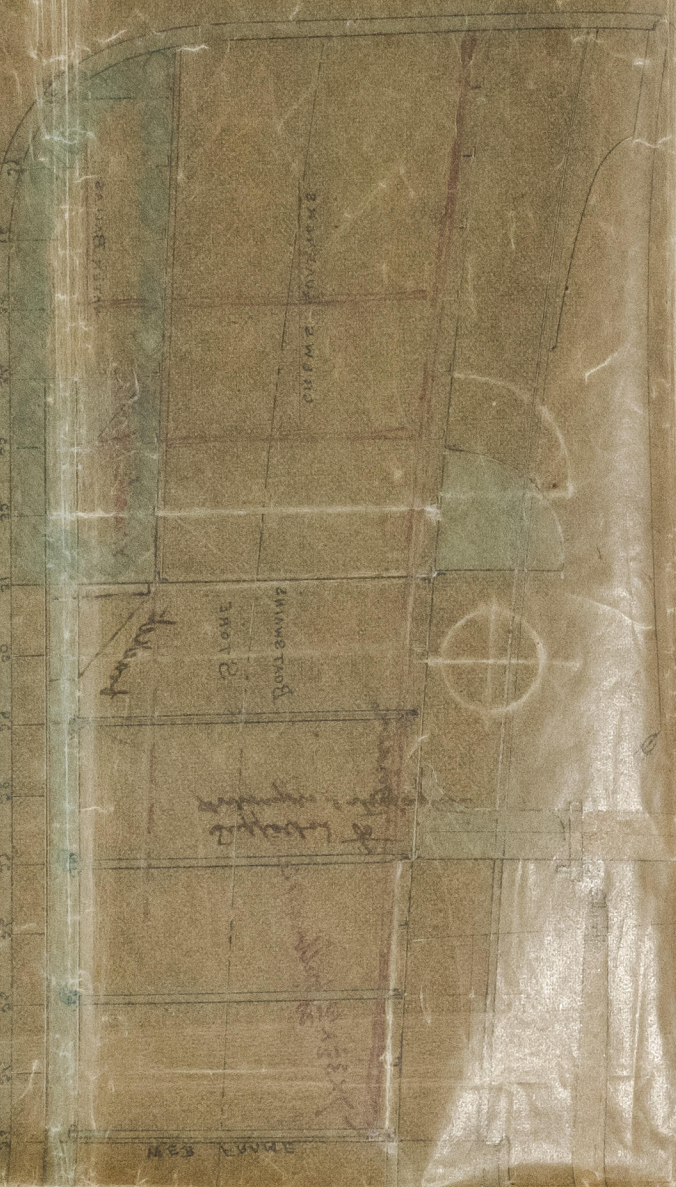

22 AUGUST
ON
BY ORDER ARRANGEMENT

1811



© 2021
Lloyd's Register
Foundation