

5.9.43

6. 10. 93

6.11.93

Equipment as per Rules

EQUIPMENT 62-2344

1 ANCHOR 5 cwt (INCLUDING STOCK)

1 " 2 av

75 FATHOMS  $\frac{7}{8}$ " SHORT LINK CHAIN

~~100 FEET  $\frac{1}{2}$ " TESTED CHAIN (FOR WINCH)~~

~~60 FATHOMS 5½" MANILLA~~

20 " HEADING LINE

MIDSHIP  
SECTION.

SCALE  $\frac{3}{4}'' = 1 \text{ FT.}$

Note. ALL SHELL BUTTS TO BE LAPPED  
AND <sup>double</sup> SINGLE RIVETED.

### DIMENSIONS


HALF MOULDED BREADTH --- = 9.0

DEPTH FROM TOP OF KEEL - = 8.91


LENGTH AS PER RULE -- = 64.6'

---

## NUMERALS
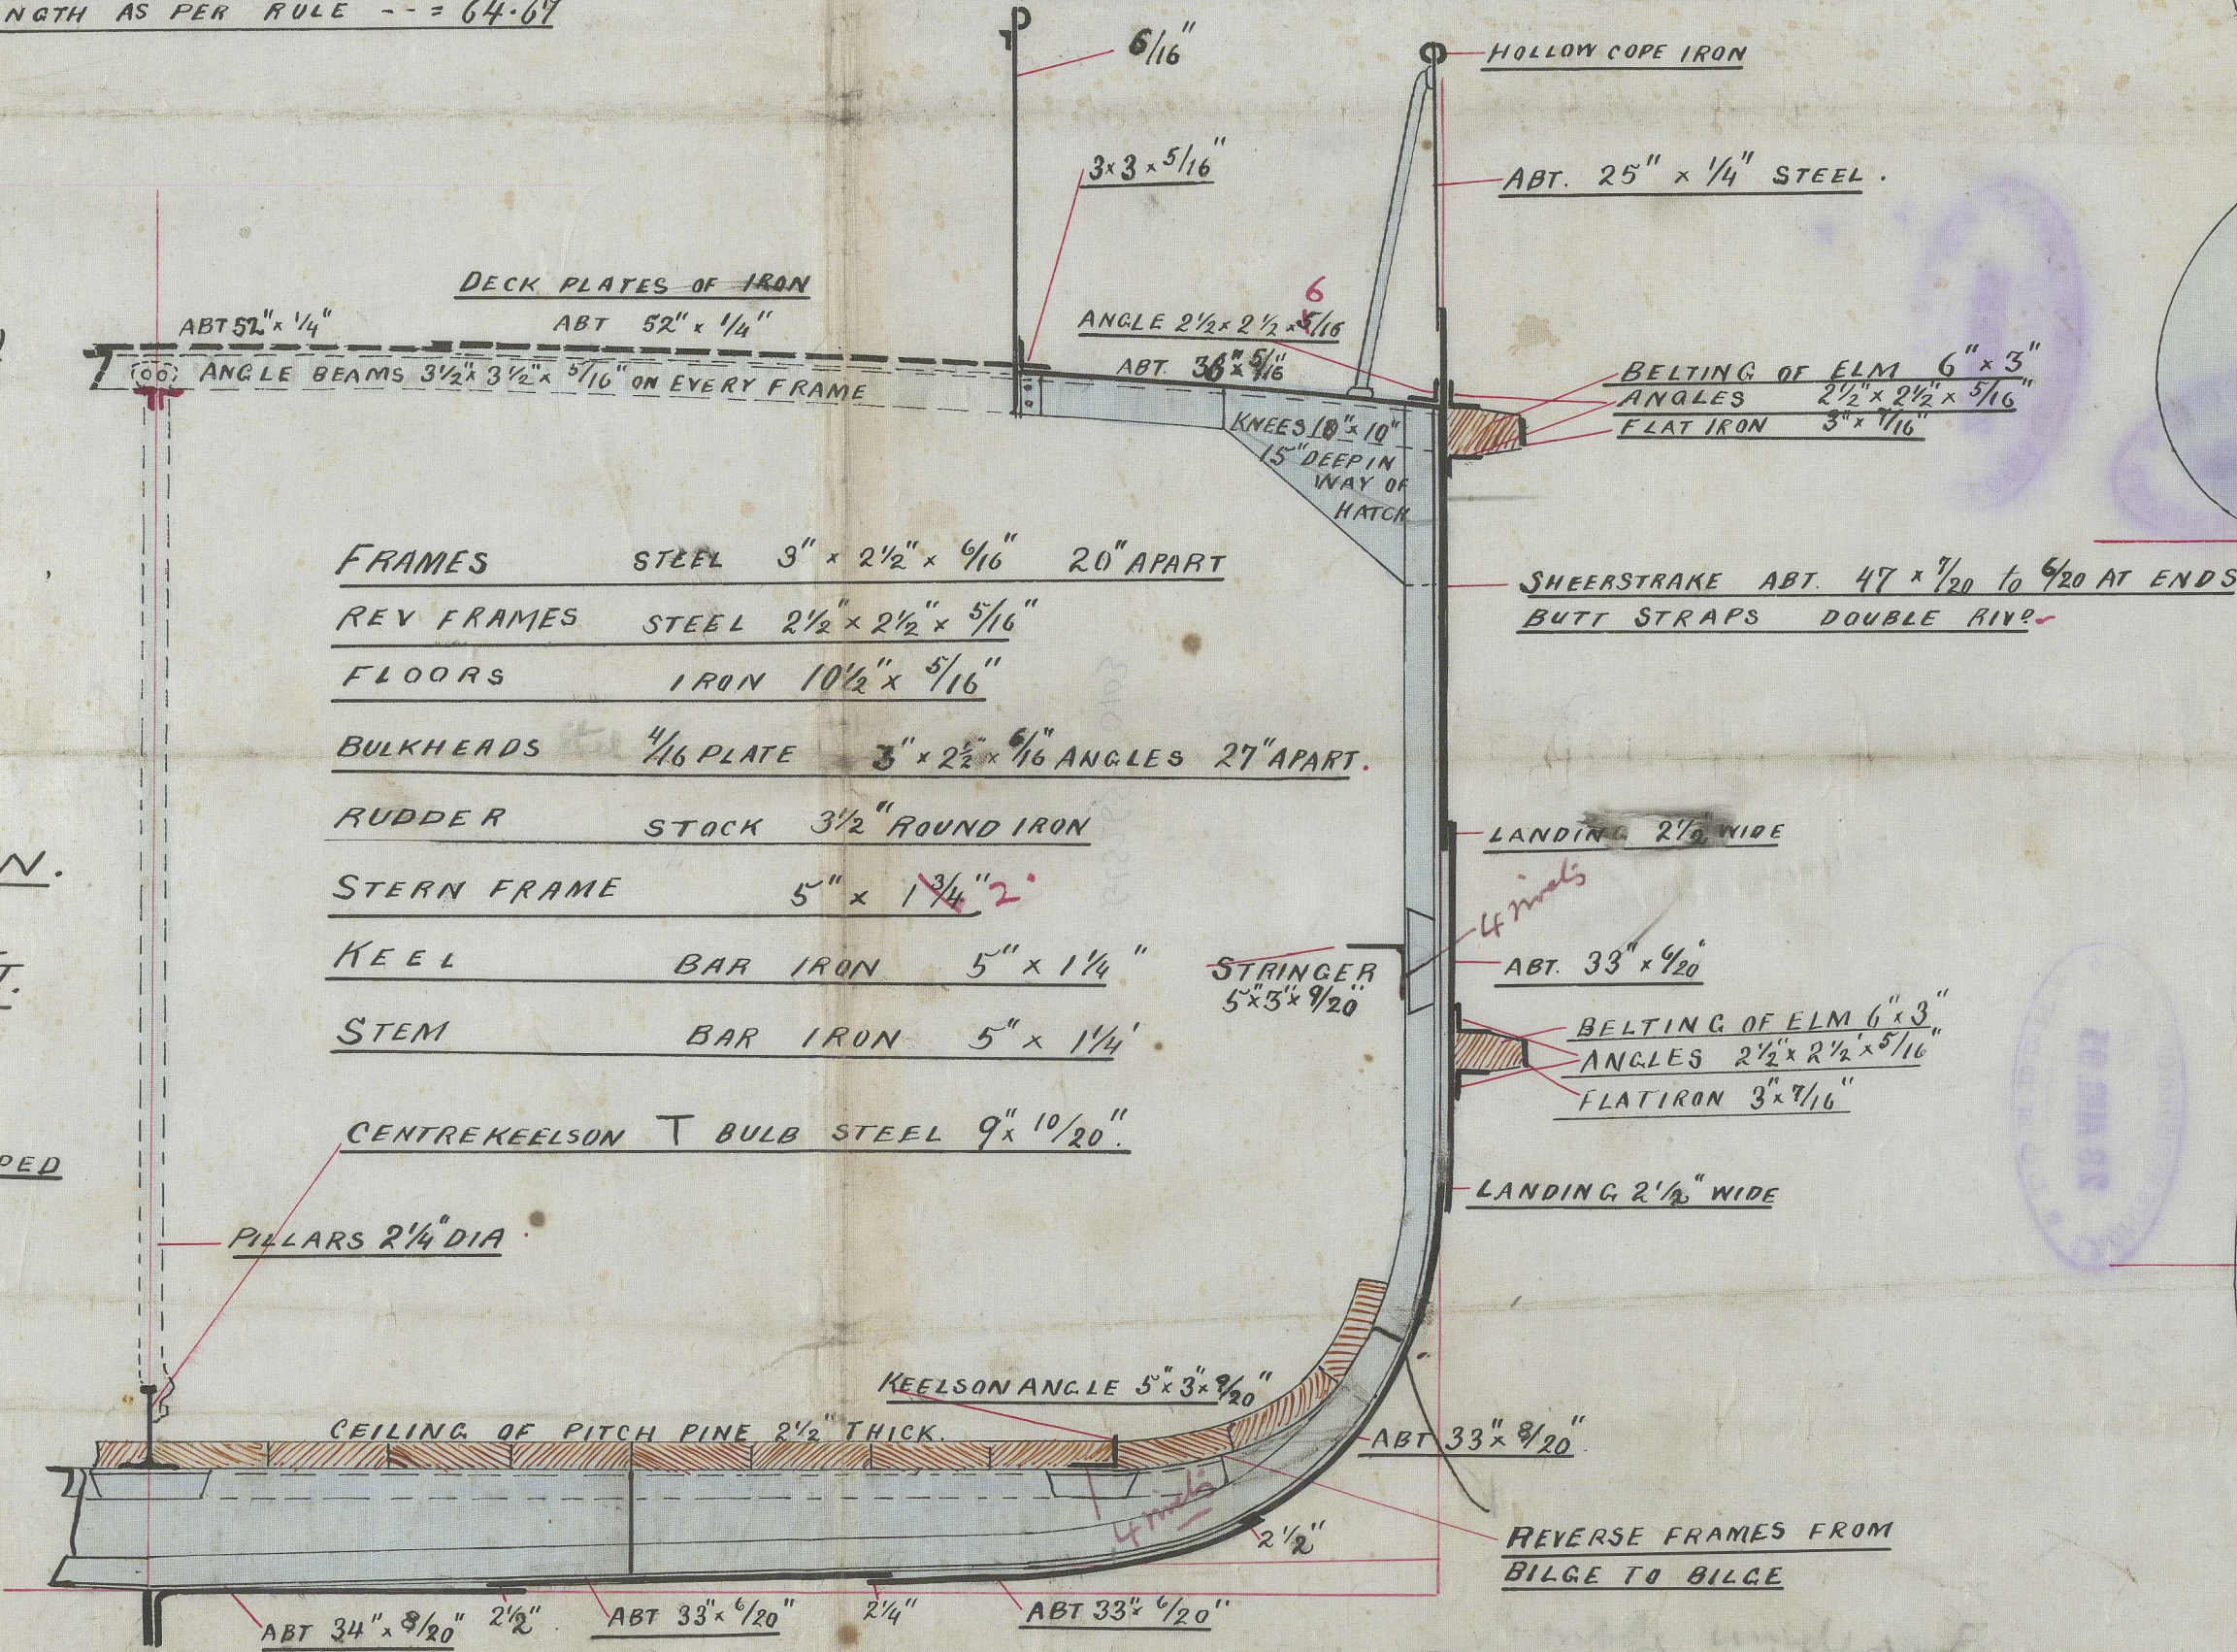
$$9.0 + 8.9 + 16.3 = 34.2 \text{ THWARTSHIPS}$$
$$(9.2 + 8.3 + 16.3) \times 64.67 = 2211.7 \text{ LONGIT.}$$


See amended tracing  
J. P.

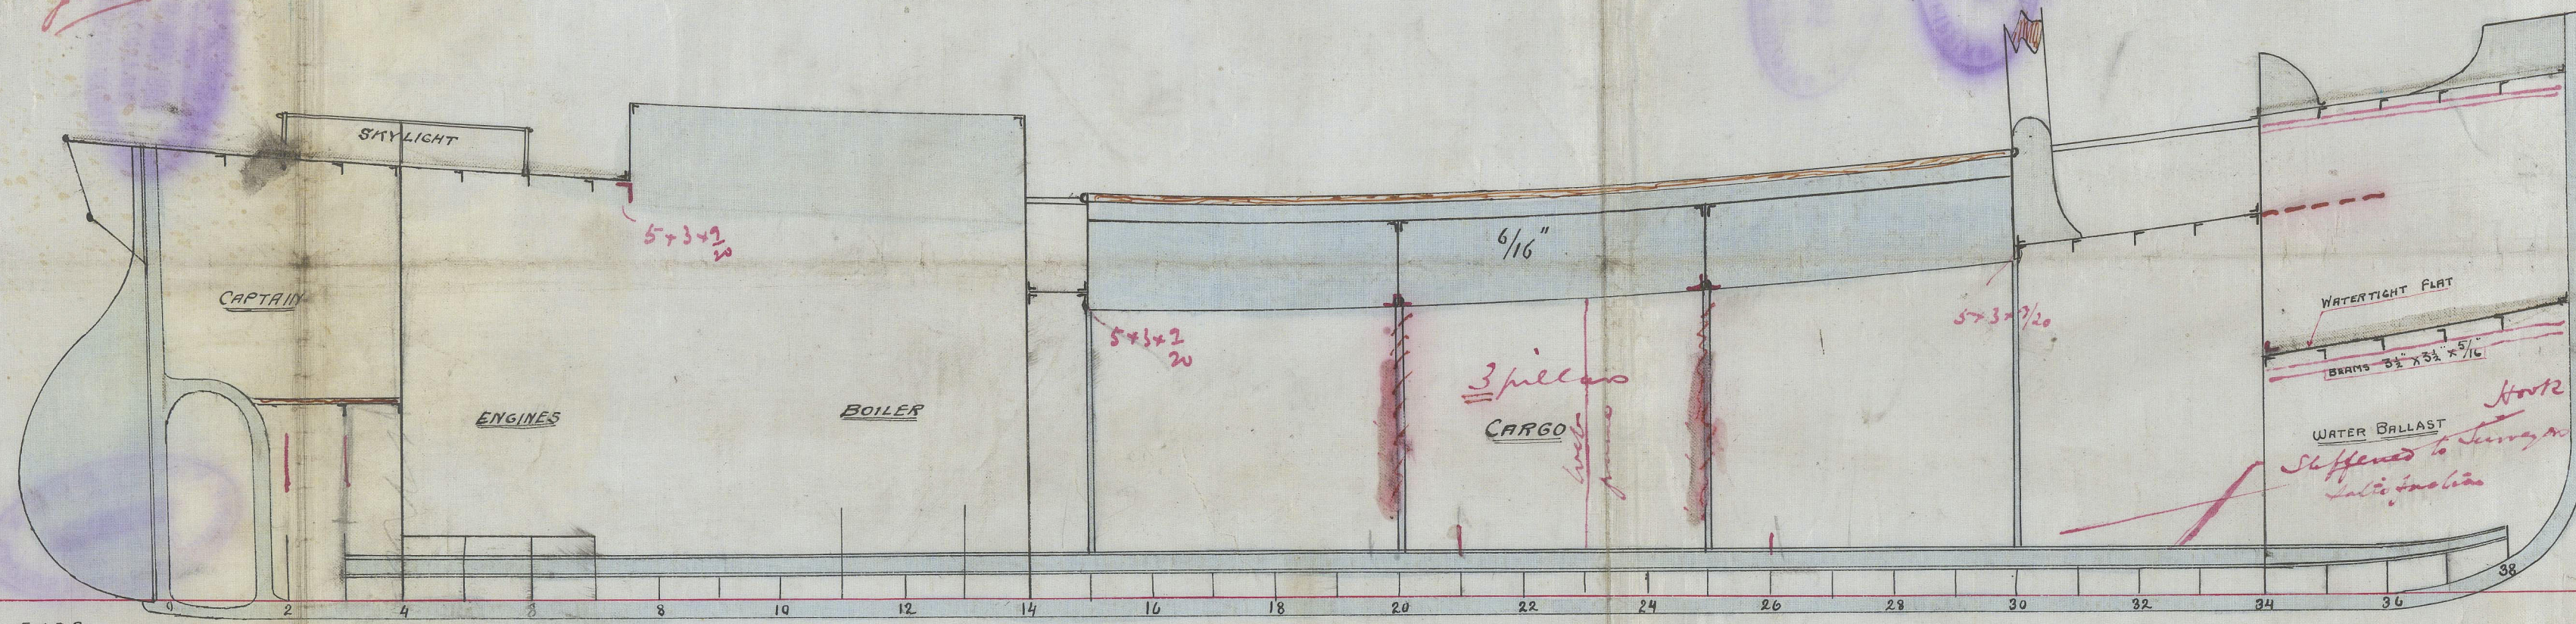


PROPOSED STEEL SCREW STEAMER.

TO CLASS A COASTING RIVER AND CANAL PURPOSES.

SCALE  $\frac{1}{4}" = 1 \text{ FT.}$



No 79 & 80

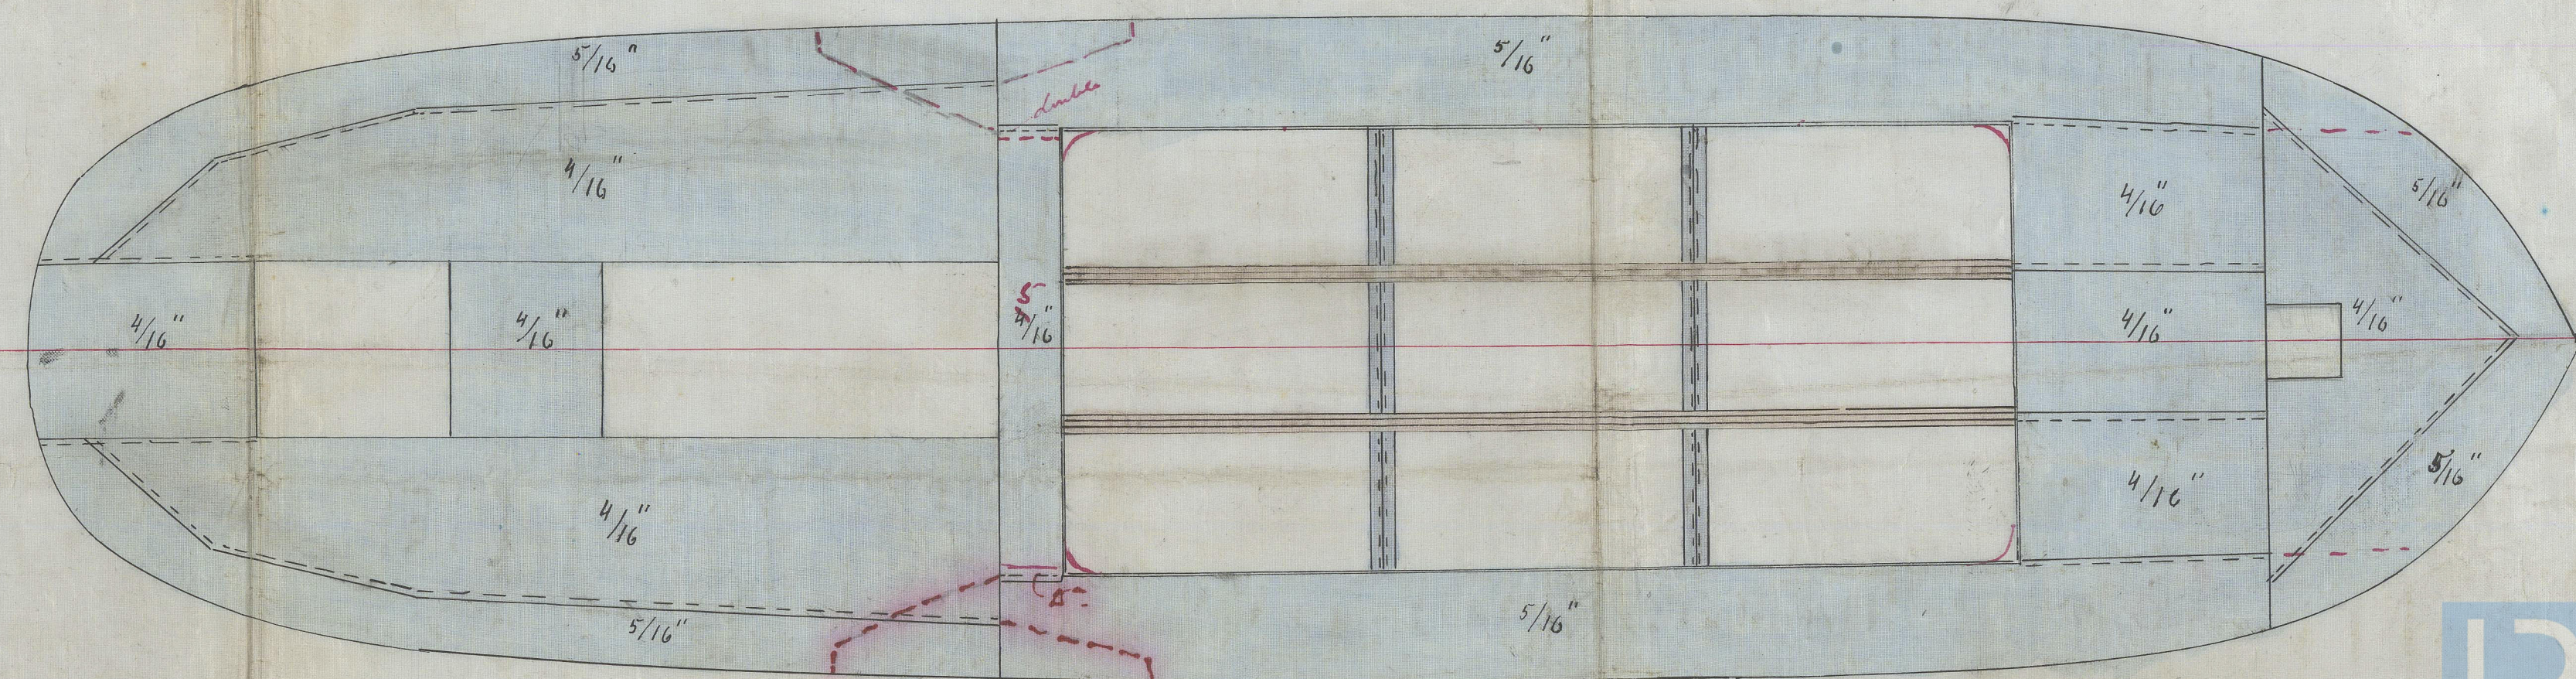





08295280

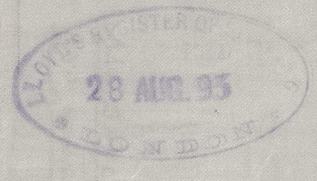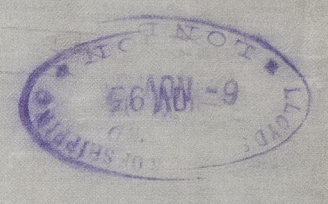









 




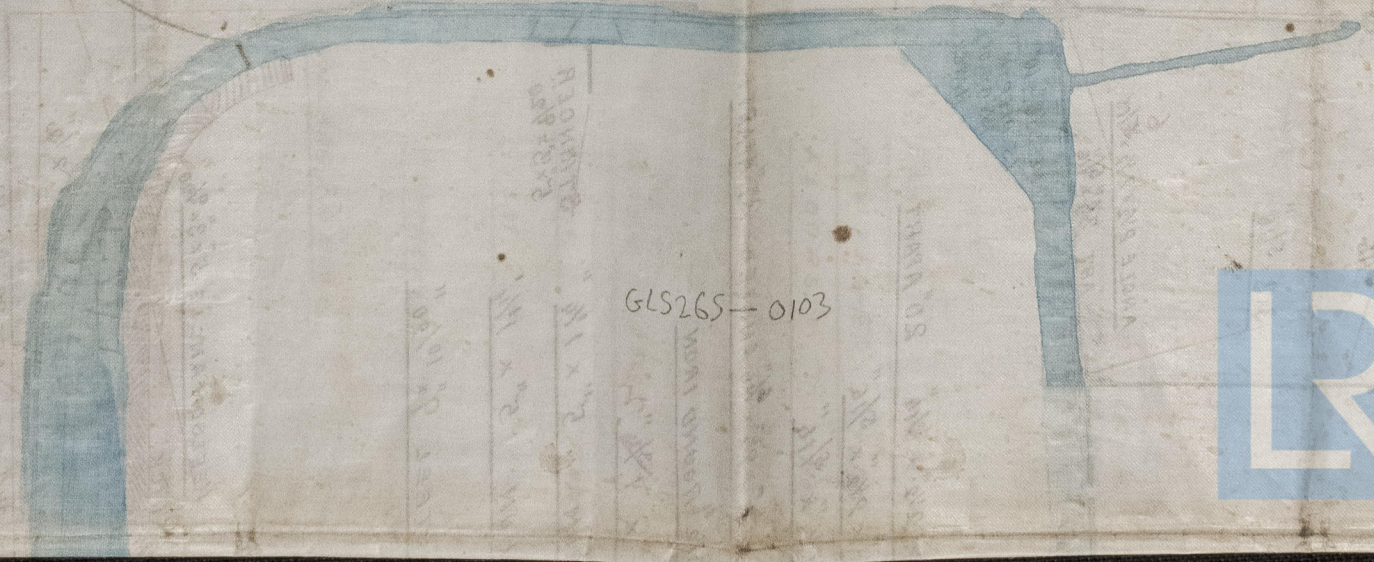

GLS265-0103



© 2021  
Lloyd's Register  
Foundation