

Lloyd's Register of British and Foreign Shipping.

(Report on Vessel No. 15,797 Port Glasgow)

No. 6058 SHIP FORGINGS OR CASTINGS.

The words FORGINGS OR CASTINGS, IRON OR STEEL, should be struck out as may be required.

I have to report that the undermentioned Iron or ~~Steel~~ Forgings or Castings, manufactured by Messrs Robert Kerr & Sons of Irvine for the Vessel No. S/S Angelo, being ~~built~~ repaired by Messrs S McKnight & Co of Ayr have been inspected by me as set forth below, and found to be, so far as can be seen, Sound & efficient


Mark on Forgings.

Lloyd's
No.
<u>WH</u>

William Hamilton  
Glasgow

	STERN FRAME.	RUDDER FRAME.	STEM.
Material* ...	<u>Scrap iron</u>		
How made ...	<u>Forged</u>		
Dimensions ...	<u>5 1/2</u>		
Progress on Inspection	<u>Forging &amp; smithing</u>		
Date when Inspected	<u>28/7/97 to 29/10/97</u>		

SKETCHES OF FRAMES SHOWING POSITION AND DESCRIPTION OF WELDS OF FORGINGS, OR PARTICULARS OF TESTS APPLIED TO CASTINGS.

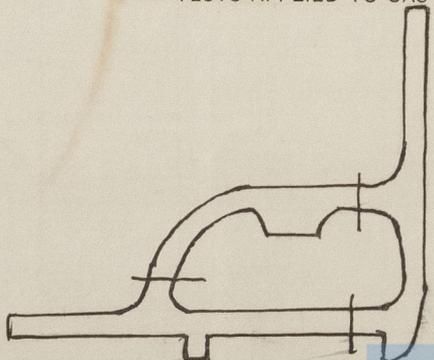

Gut welds

Fee (if any chargeable) £ 1 : 1 : 0

To be paid at



© 2021

Lloyd's Register  
Foundation