

## Lloyd's Register of British and Foreign Shipping.

(Report on Vessel No. 15,797)Port GlasgowNo. 6058 SHIP FORGINGS OR CASTINGS.

I have to report that the undermentioned Iron or Steel Forgings or Castings,  
 manufactured by Messrs Robt Kerr & Sons  
 of Irvine for the Vessel No. S/S Angelo, being built repaired

by S Mc Knight & Coy of Ayr  
 have been inspected by me as set forth below, and found to be, so far as can be seen,  
Sound & efficient

Mark on Forgings.

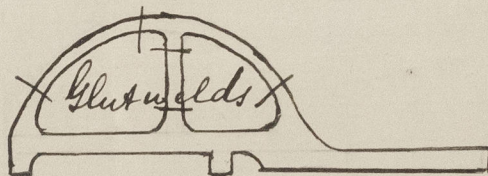
Lloyd's

No.

W.H.William HamiltonGlasgow 6/12/97

	STERN FRAME.	RUDDER FRAME.	STEM.
Material* ...		<u>Scrap iron</u>	
How made ...		<u>Forged</u>	
Dimensions ...		<u>3 1/2 to 2" pimbles</u>	
Progress on Inspection		<u>Forging &amp; smithing</u>	
Date when Inspected		<u>26/11/97 to 4/12/97</u>	

SKETCHES OF FRAMES SHOWING POSITION AND DESCRIPTION OF WELDS OF FORGINGS, OR PARTICULARS OF  
 TESTS APPLIED TO CASTINGS.

Fee (if any chargeable) £ 1 : 1 : 0To be paid at Glasgow

© 2021

Lloyd's Register  
Foundation