
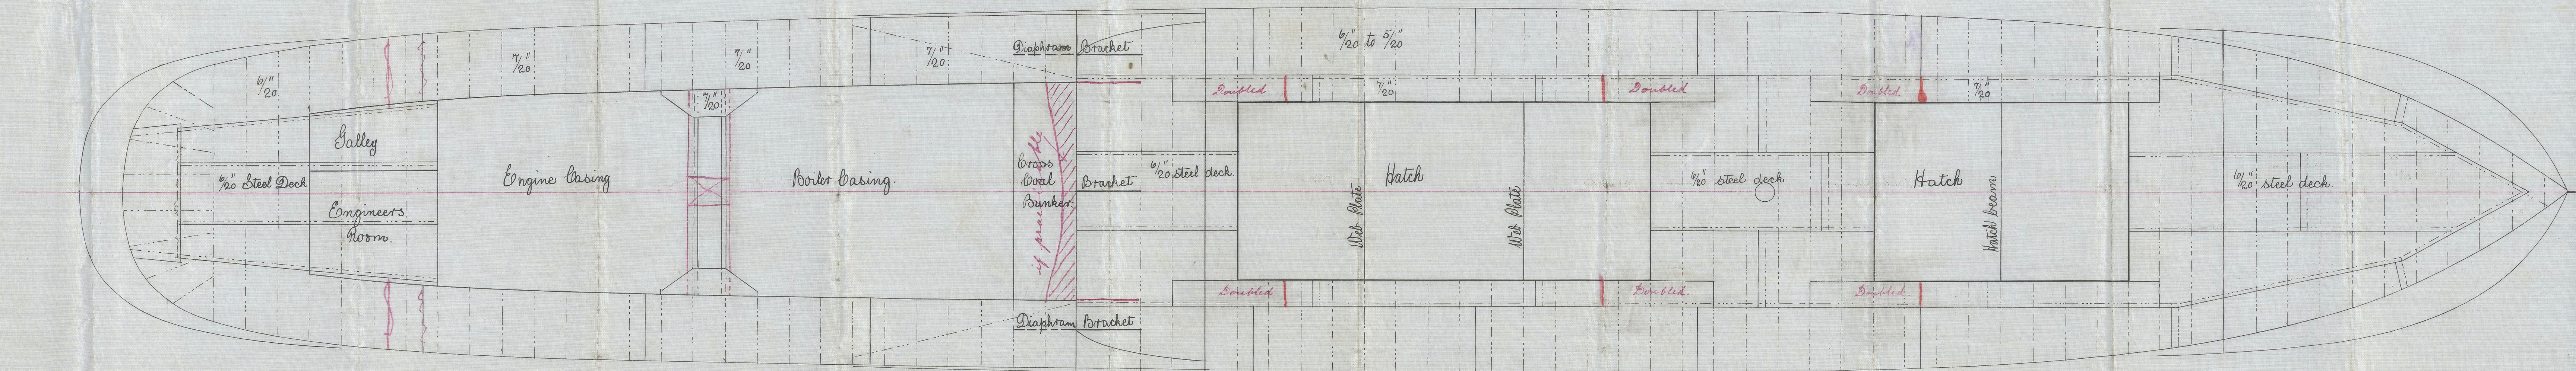


Profile and Deck Plan of S. S. No 142.
Scale $\frac{1}{4}$ Inch = 1 Foot.

A circular purple ink stamp. The outer ring contains the text "JOHN FULLERTON & CO." at the top and "PAISLEY." at the bottom, separated by small decorative stars. In the center, the word "Shipbuilders," is written in a stylized font. Overlaid on the center is the date "25/7/98" in a handwritten style.

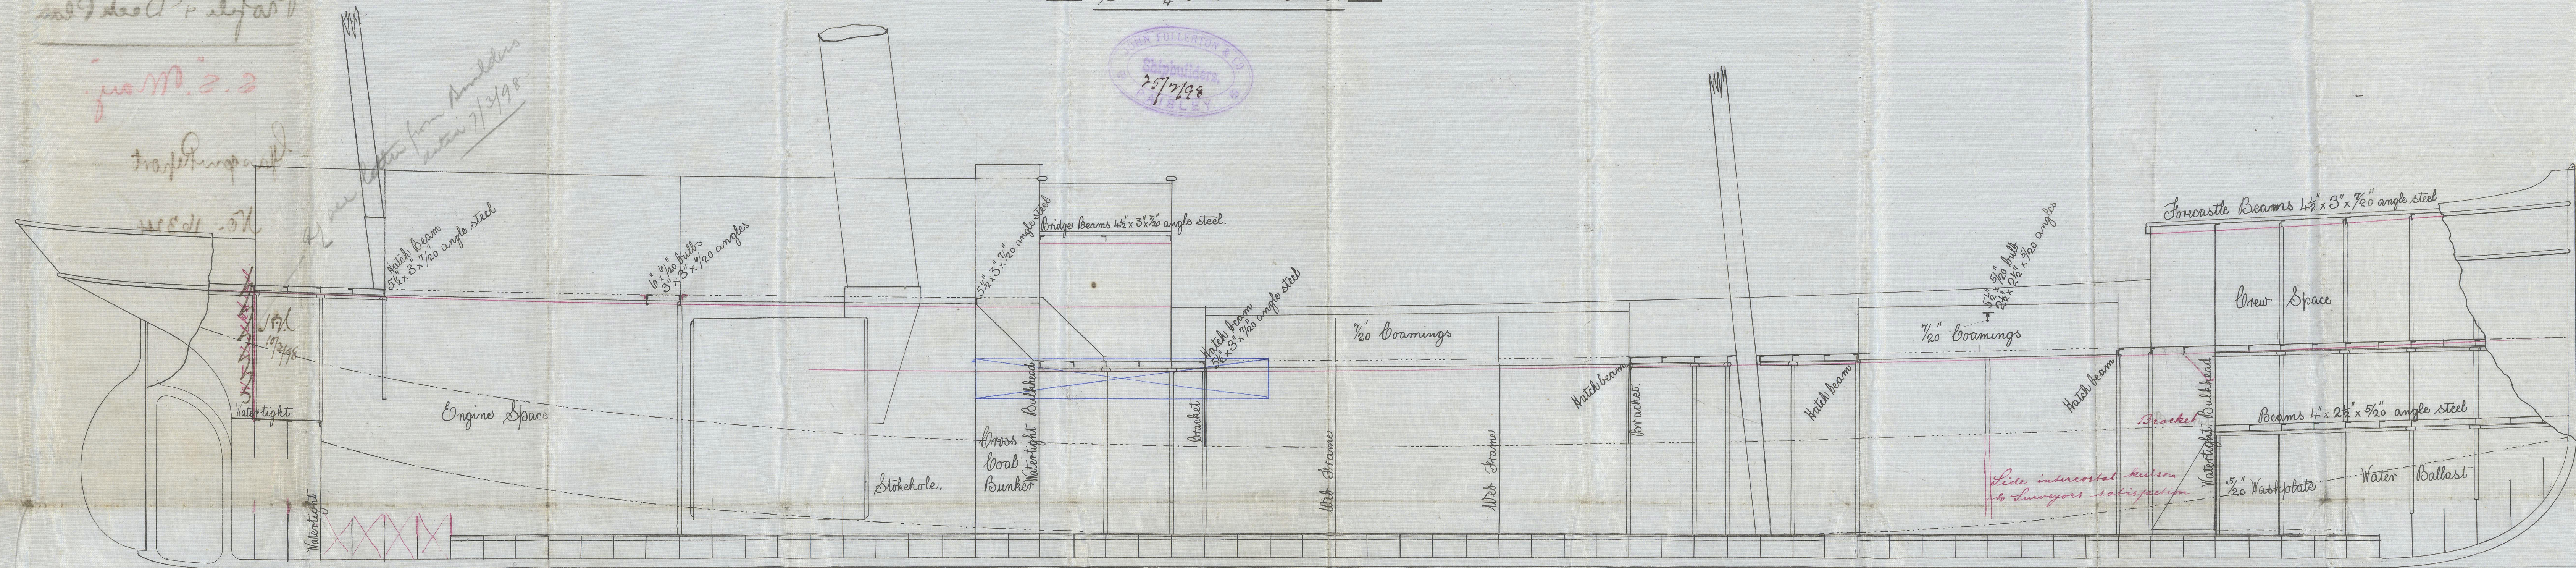

Wm
4/3/98

John Fullerton & Co.


No. 142

Amended
Profile & Deck Plan


S.S. May.

Glasgow Report

No. 16324

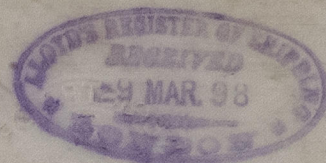

8p. E. 4
8p. E. 01

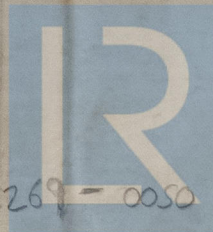

GLS269-0050

© 2021

Lloyd's Register
Foundation