
 
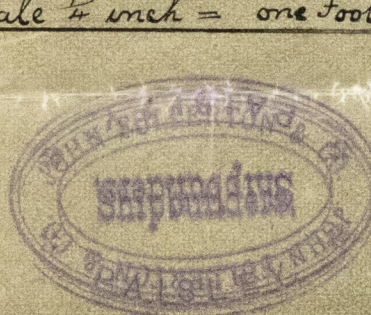


Mr 30.3.98


Pumping Plan of S. S. No 142.
 Scale to inch = one foot.

100 8 21 oil tank pump

100 8 21 oil tank pump

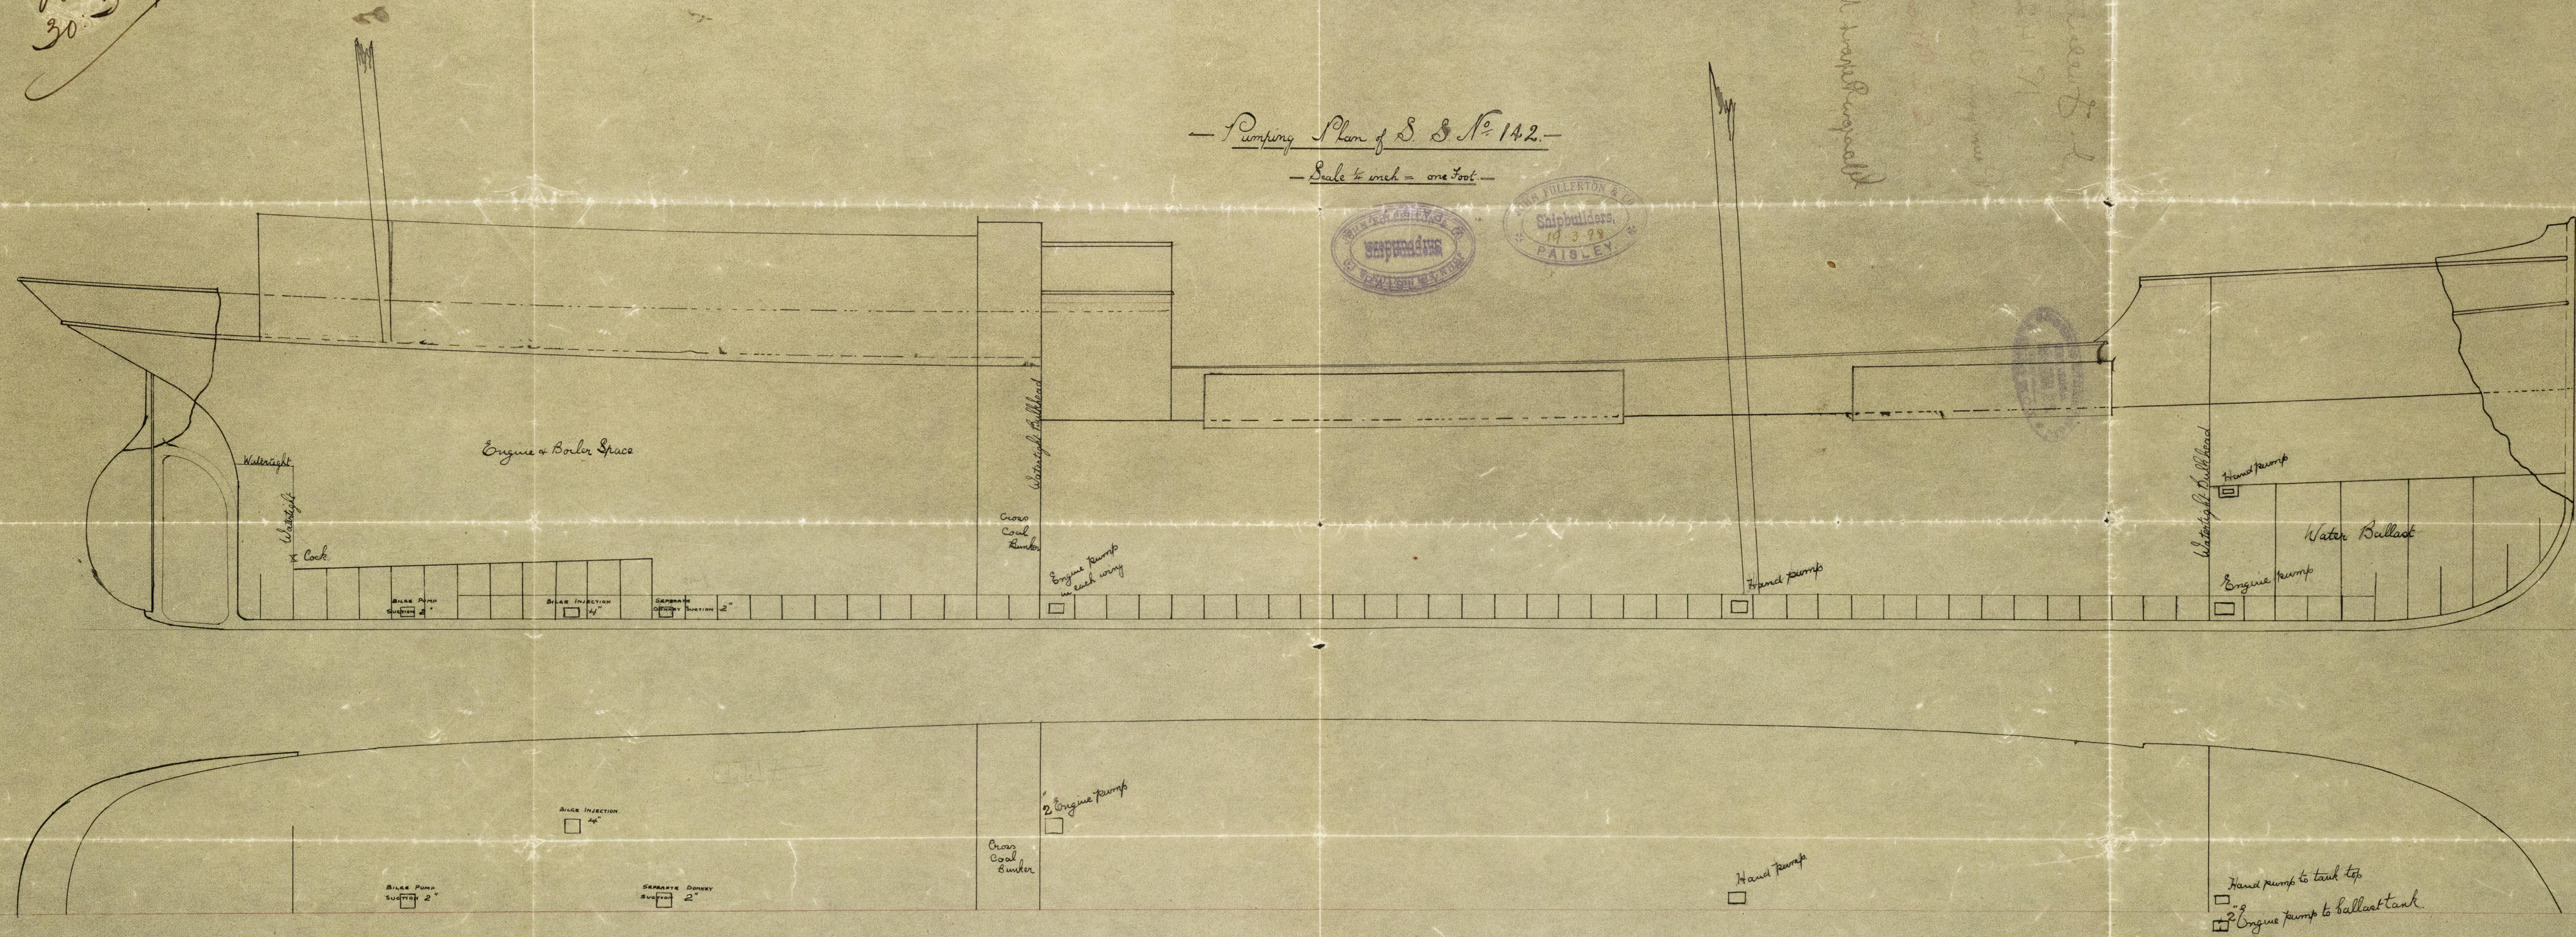


J.M.
 29/3/98

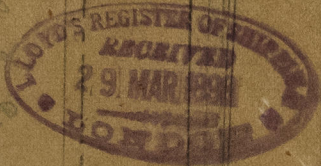

J. Fullerton & Co
N^o 142.

Pumping Arrangements
S.S. "May."

Glasgow Report No. 16324

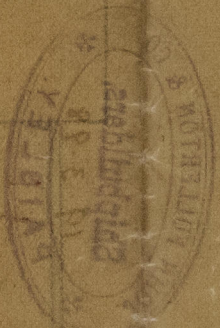

GLS269--0051



—241/10
J. Fullerton & Co
Glasgow

© 2021

Lloyd's Register
Foundation