


22.1.98

5200-198253


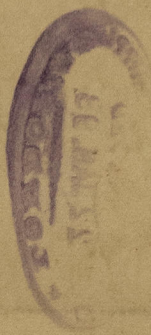


- Single Plate Rudder -
- for S. S. N^o 142 -
- Scale 1" = 1 foot -

✓
No. 142
✓
No. 142

2.2.1900

subd. 1900
16.1.98

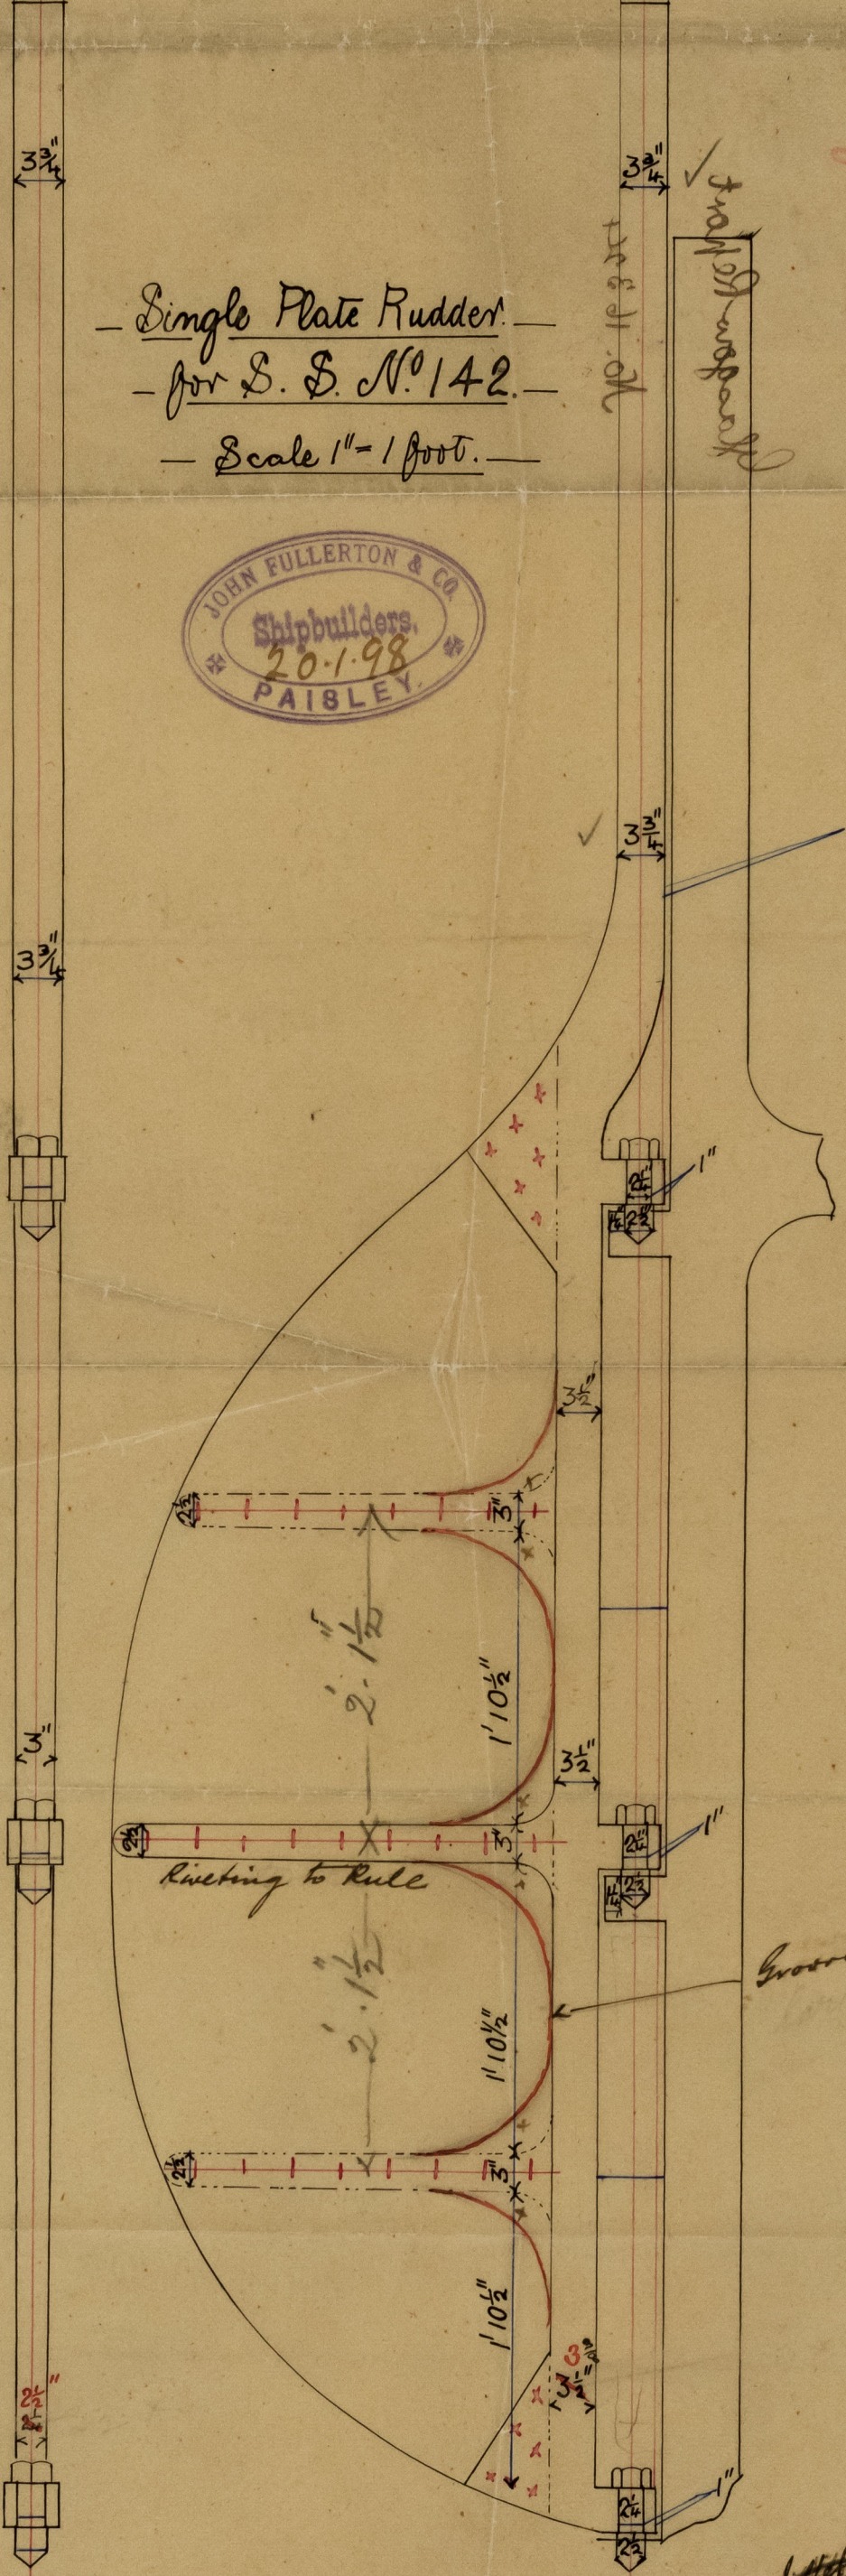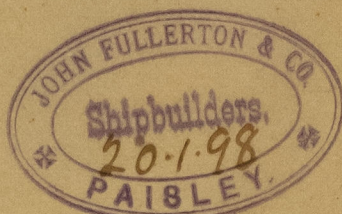


1" at end
✓ 10" plate

groove as large fillet

Plating No 51.85

W. L.
8/2 20/1/98

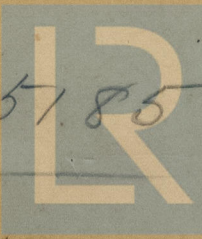


© 2021
Lloyd's Register
Foundation

GLS269-0052


GLS269-0052

© 2021
Lloyd's Register
Foundation

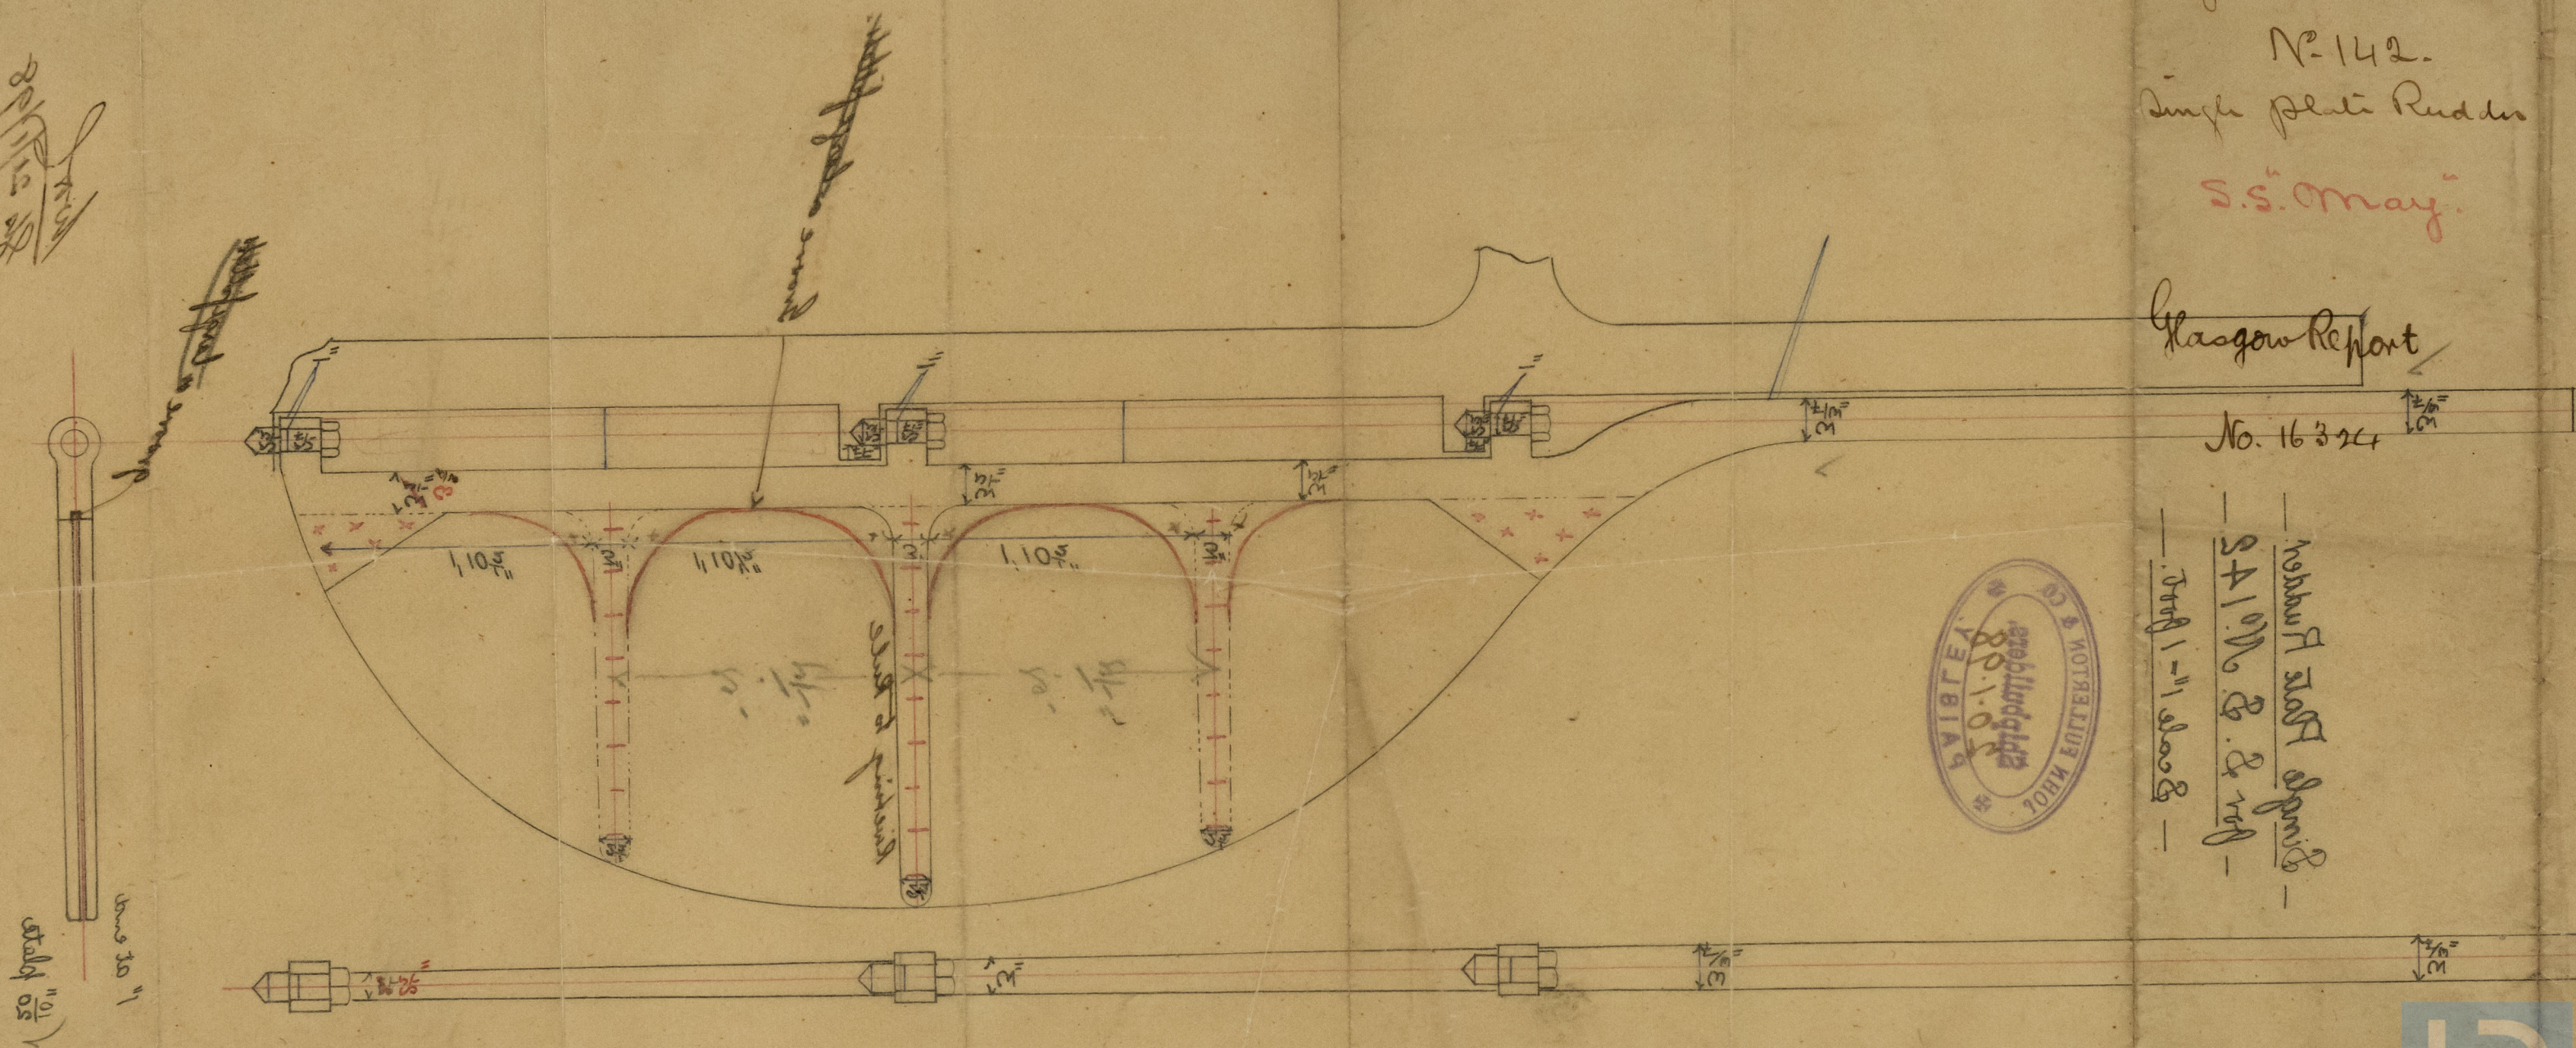

[Handwritten signature]

10 22 22

June 30th
1891