

## Lloyd's Register of British and Foreign Shipping.

(Report on Vessel No. \_\_\_\_\_ Port \_\_\_\_\_)

## No. 6260 SHIP FORGINGS OR CASTINGS.

I have to report that the undermentioned Iron or Steel Forgings or Castings, manufactured by The Irvine Forge Coy of Irvine for the Vessel No. 142, being built by Messrs John Kullerton & Co of Paisley have been inspected by me as set forth below, and found to be, so far as can be seen, Sound & efficient

Mark on Forgings.

Lloyd's

No. 6260

W.H


William Hamilton

Glasgow

4/3/98

	STERN FRAME.	RUDDER FRAME.	STEM.
Material* ...	Scrap iron		
How made ...	Forged		
Dimensions ...	6 1/2 x 3		
Progress on Inspection	Forging & smithing		
Date when Inspected	1/2/98 to 3/3/98		

SKETCHES OF FRAMES SHOWING POSITION AND DESCRIPTION OF WELDS OF FORGINGS, OR PARTICULARS OF TESTS APPLIED TO CASTINGS.

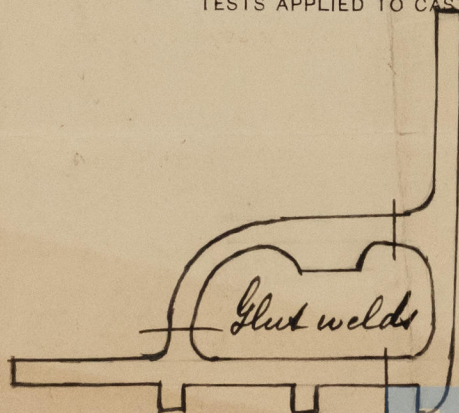

Fee (if any chargeable) £ : :

To be paid at



J. Fullerton & Co<sup>2</sup>

N<sup>o</sup> 142.

Report on Stern Frame  
S.S. "May".

Glasgow Report

No. 16324.

---



© 2021

Lloyd's Register  
Foundation