


TO PASS LLOYD'S REQUIREMENTS FOR 100 LBS WORKING PRESSURE AND TO HAVE CERTIFICATE	
TO BE MADE OF STEEL, TENSILE STRENGTH 28 TONS	
CIRCUMFERENTIAL SEAMS: LAP JOINT, DOUBLE RIVETED.	
PERCENTAGE OF PLATE SECTION	66.82
" RIVET	66.14
LONGITUDINAL SEAMS: DOUBLE BUTT STRAP, DOUBLE RIVETED	
PERCENTAGE OF PLATE SECTION	81.99
" RIVET	75.31

MARINE BOILER 11'-6" DIA. X 9'-6" LONG. N° 188.

SCALE: 1" = ONE FOOT.

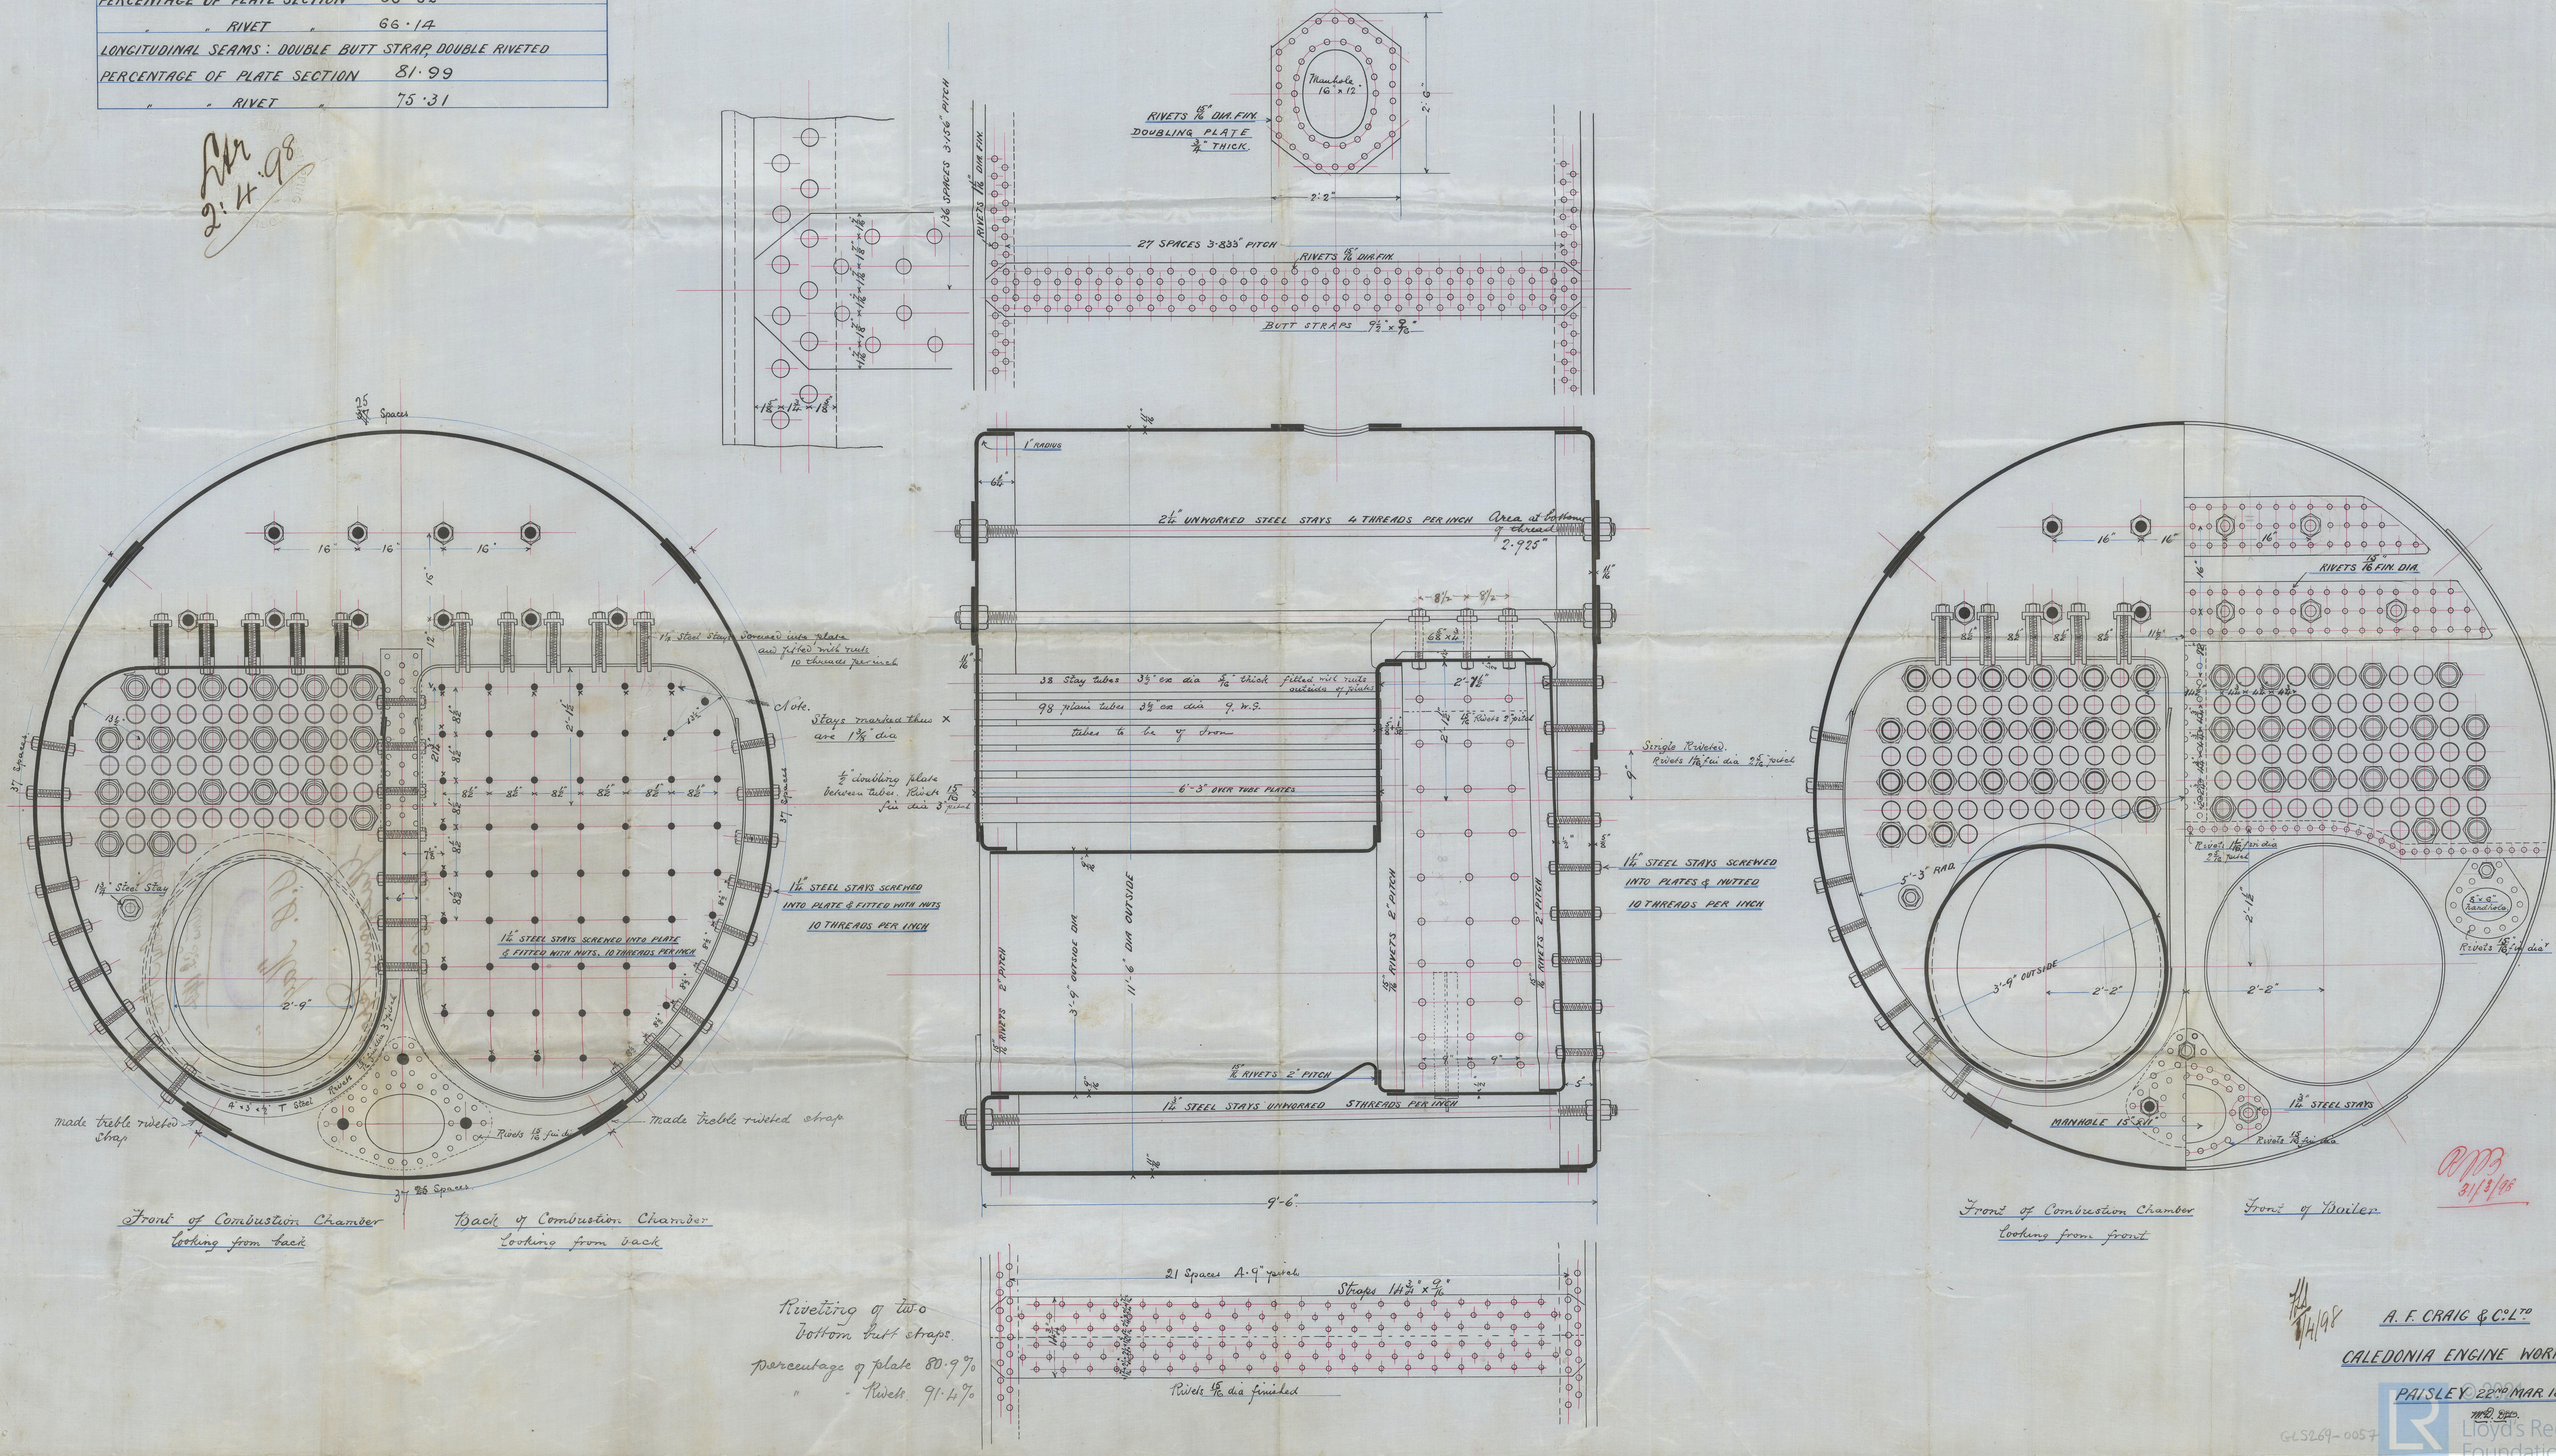

A. F. CRAIG & CO. LTD.

CALEDONIA ENGINE WORKS

PAISLEY 22ND MAR 1898

Coring & Bay N^o 188
Keelbottom S.S. 142

S.S. "May"

Glasgow Report

No. 16324

7500-692879




© 2021

Lloyd's Register
Foundation