


Scale $\frac{1}{4}$ " inch = 1' foot


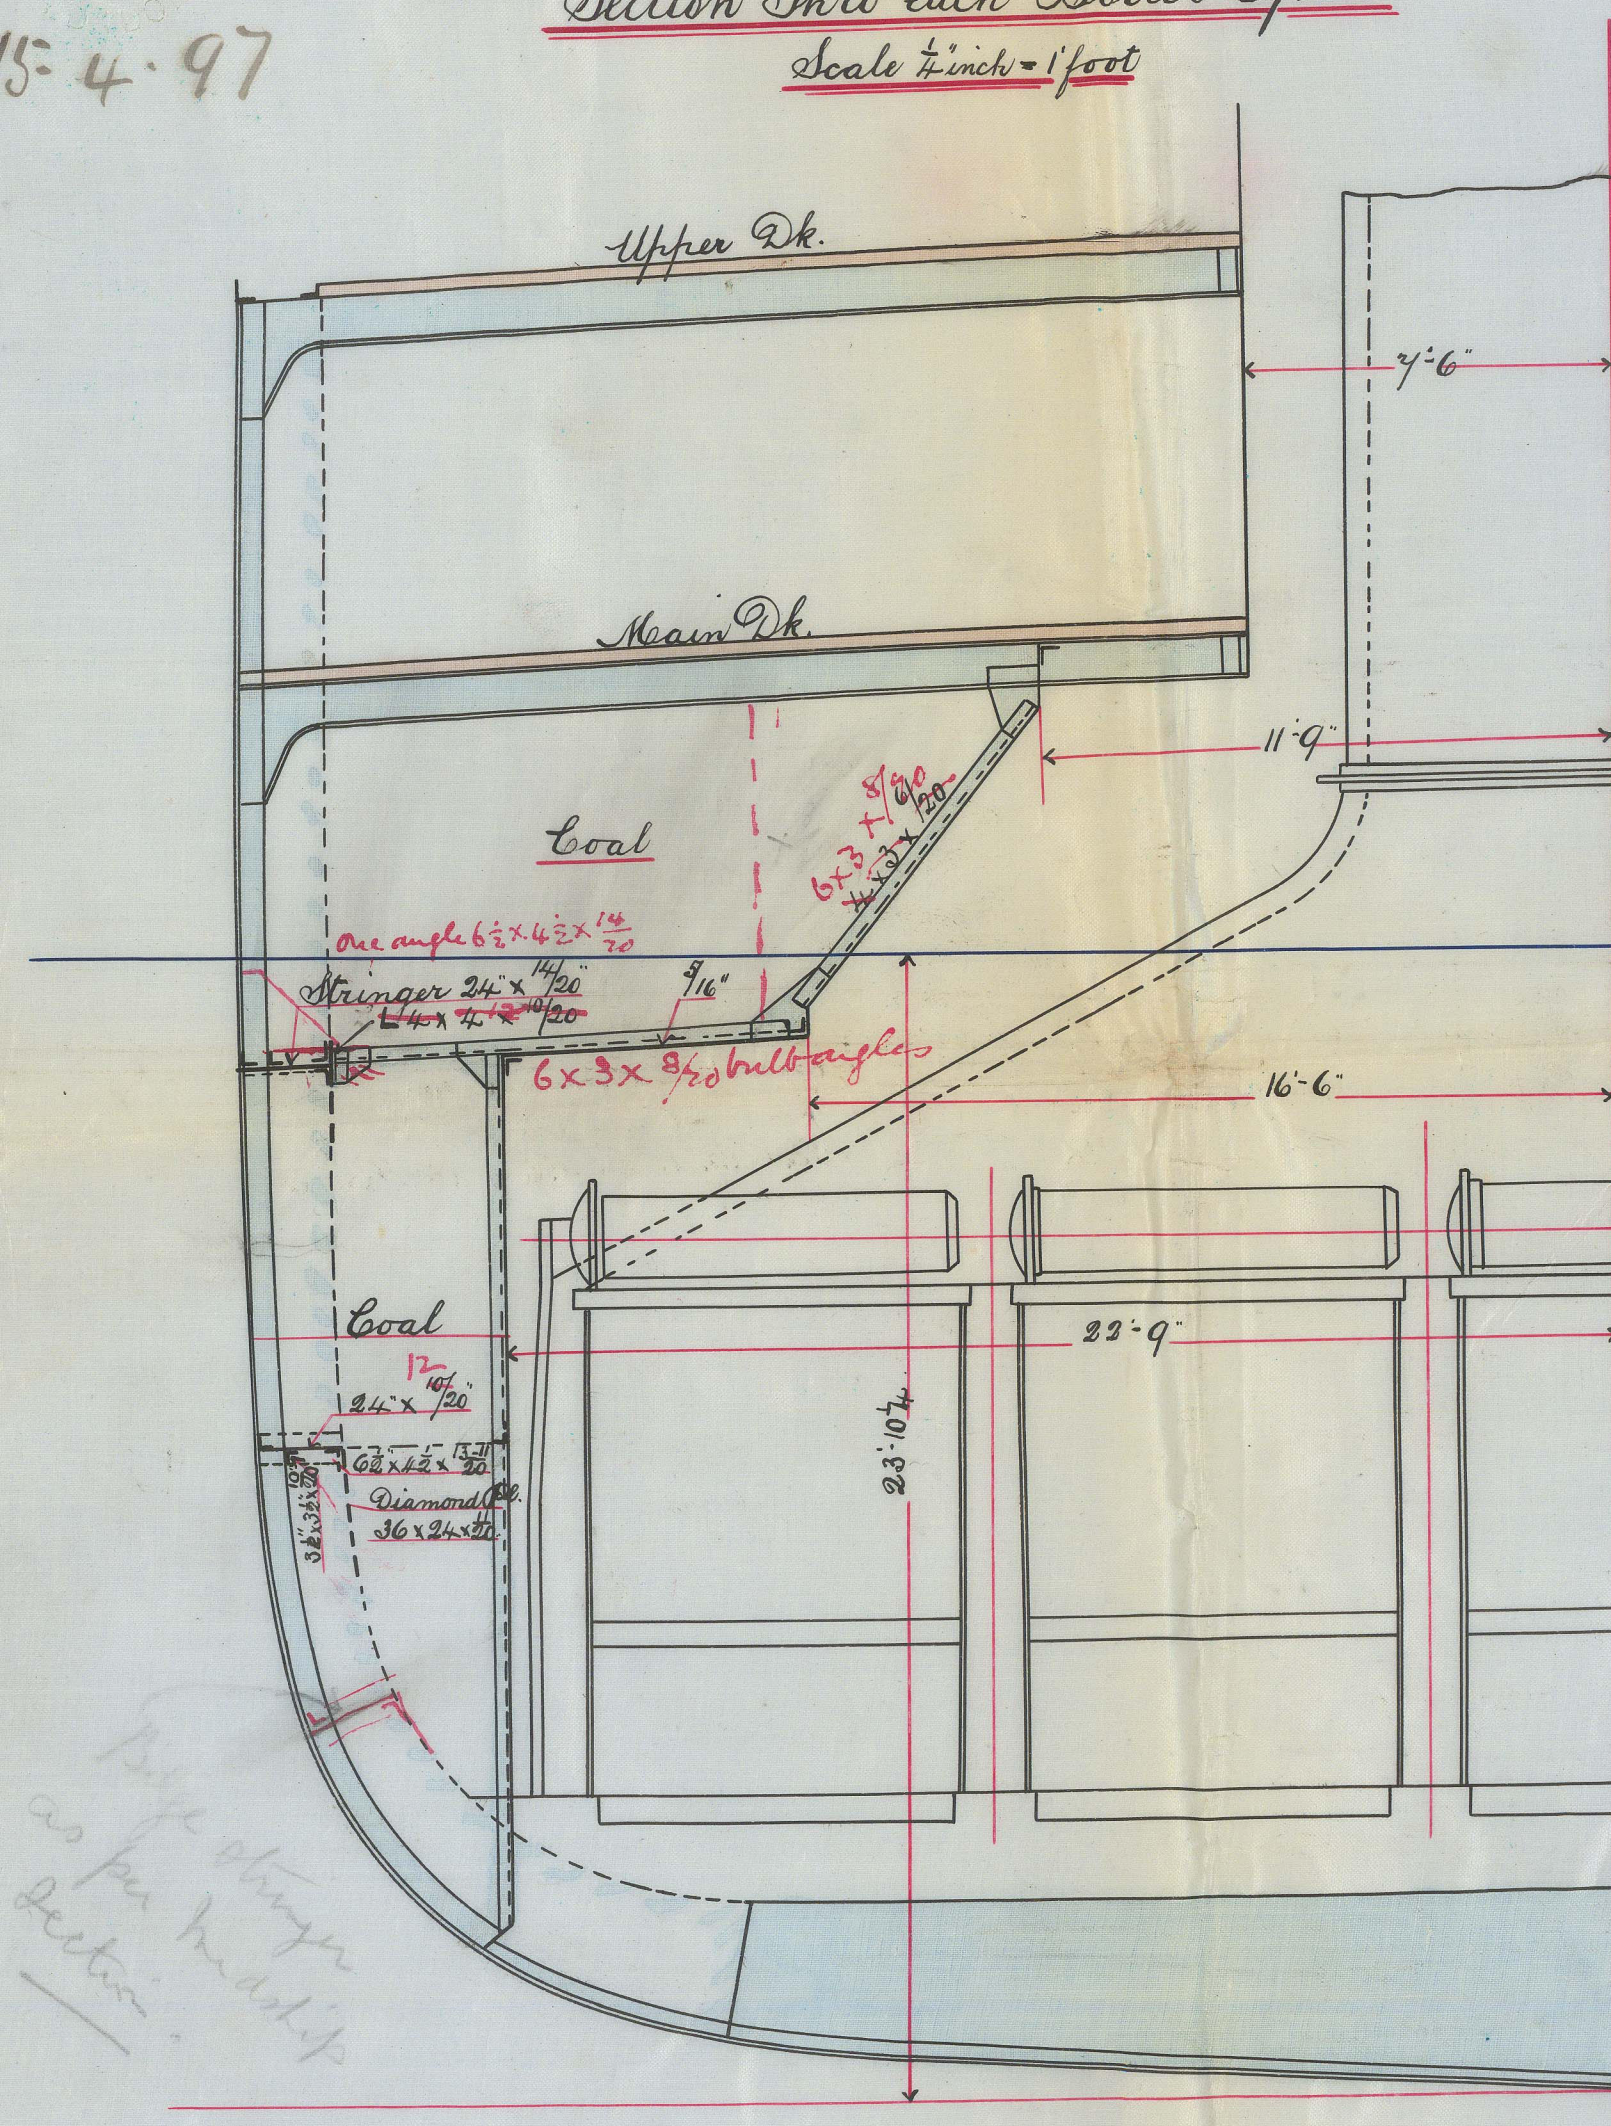


(Amended Place.)

Y.S.S. No 307

Part Plan of Lower Deck.

Scale $\frac{1}{8}$ inch = 1 foot.

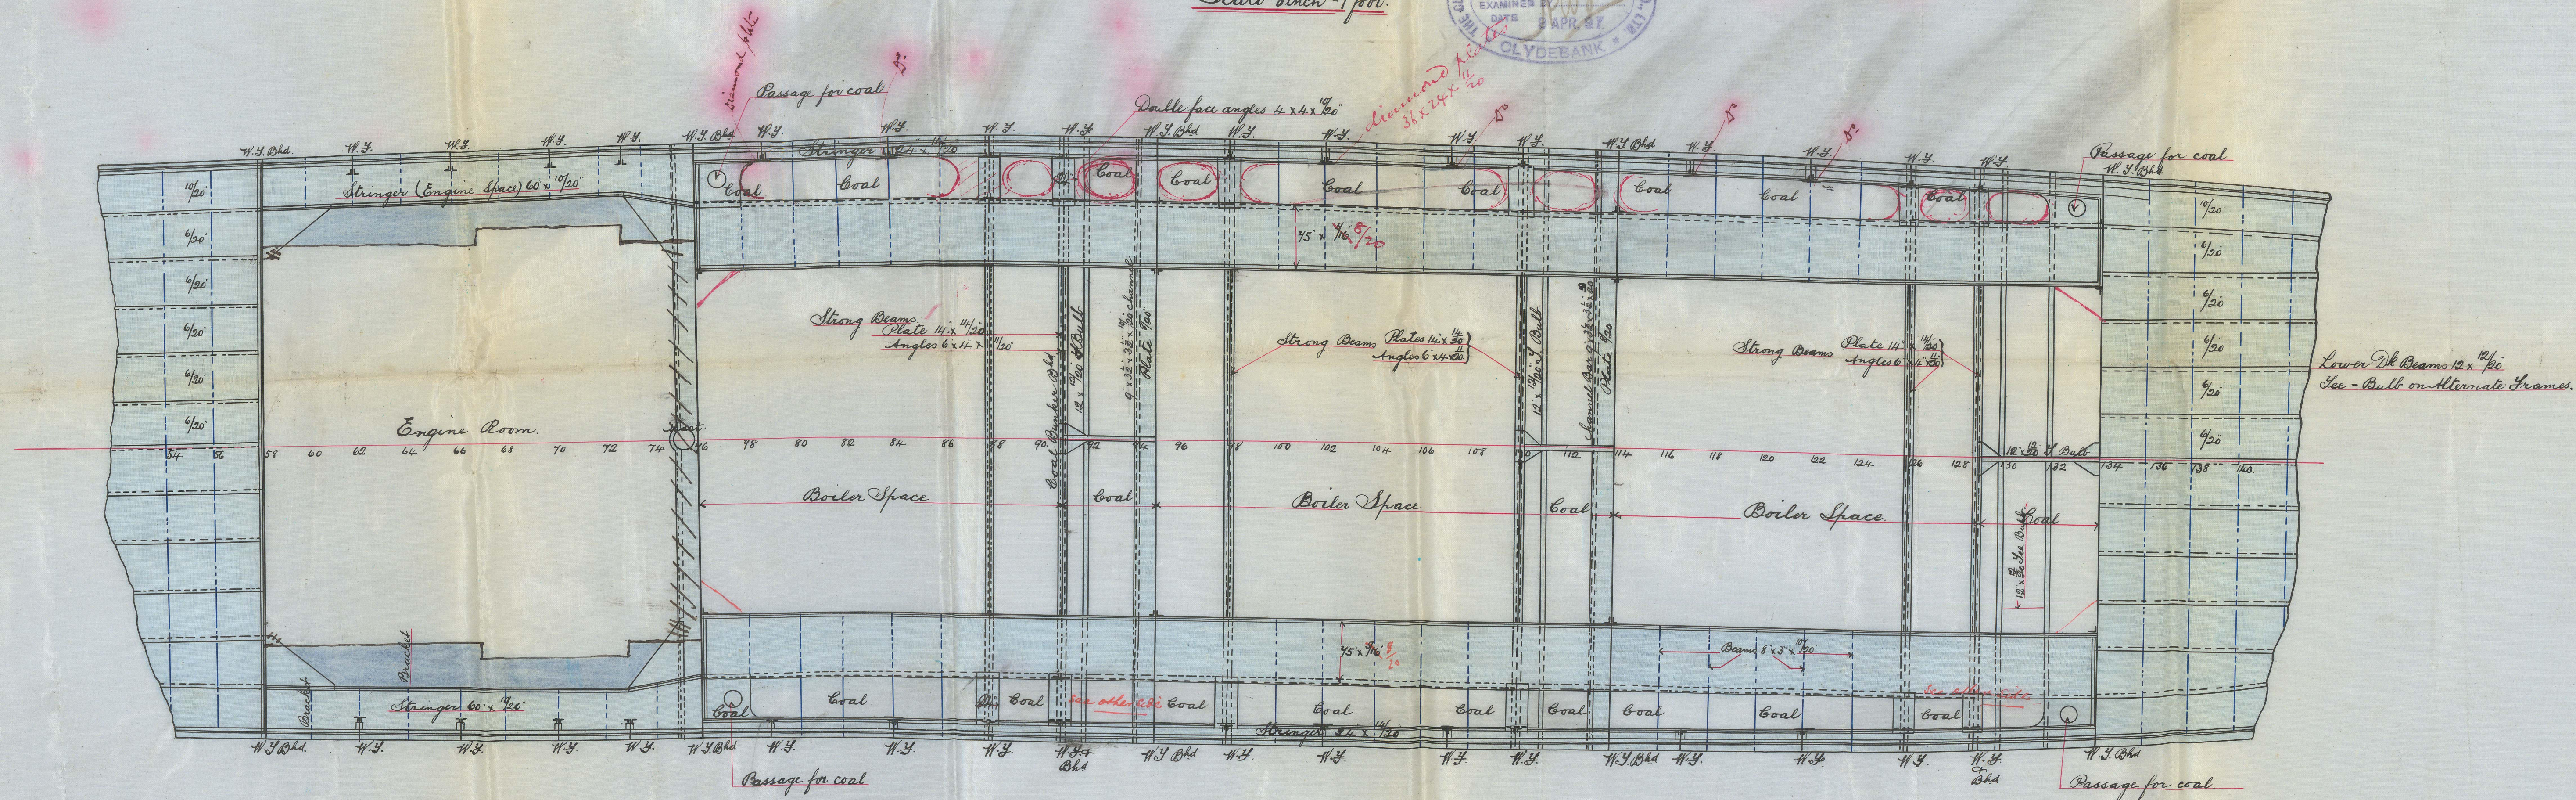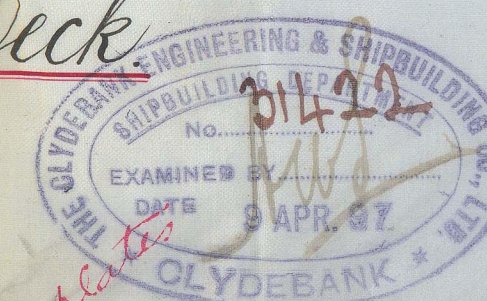

Lower Dk Beams 12 x 12 1/2
See - Built on Alternate Frames.

J.V.K.
15/4/97