


29-3-97
15-4-97

Main Deck
Lower Deck
Orlop Deck


S.S. No 307
Main, Lower & Orlop Decks Shewing
Extra Strengthening in way of Machinery
Spaces.

Scale 1/2 inch = 1 Foot.

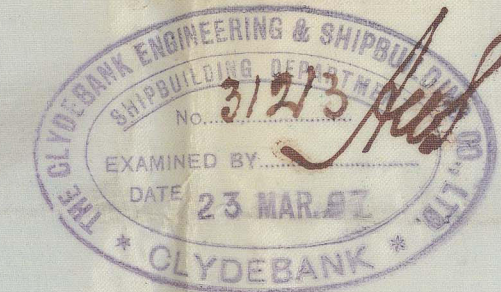

Main Deck


Main Deck Beams 12" x 20"
See built on alternate frames.

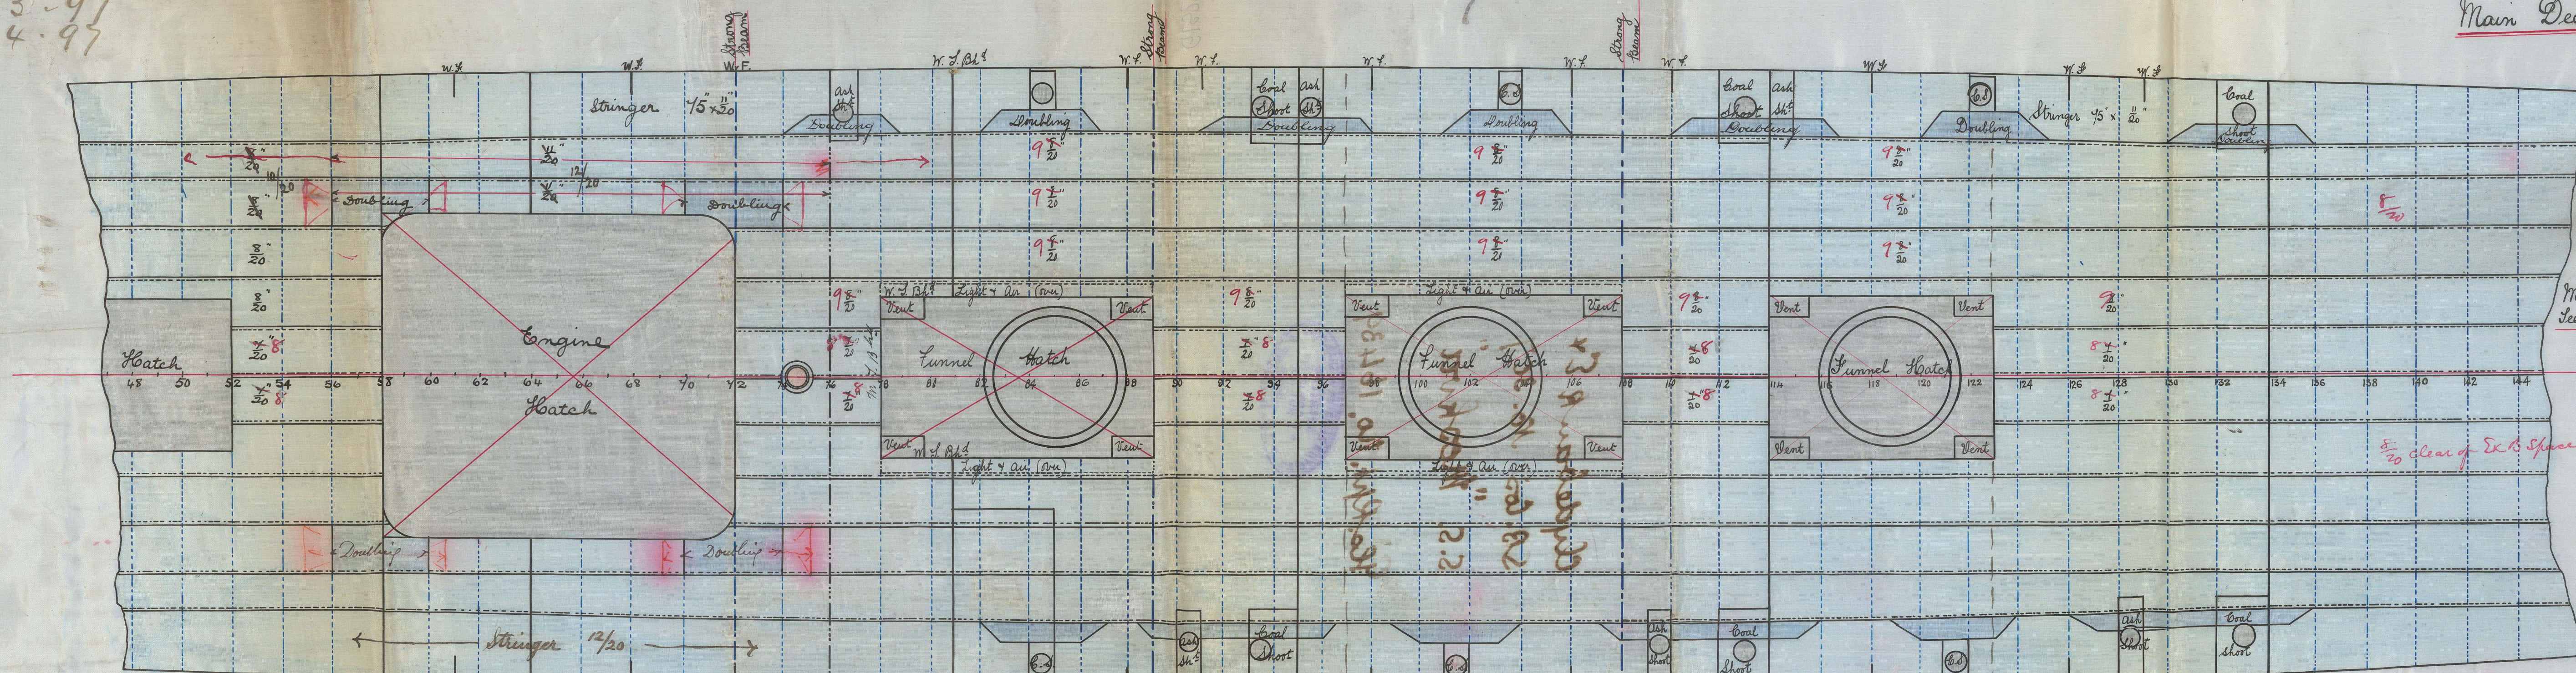


Lower Deck

See separate amended drawings of plan

Lower Deck Beams 12" x 20"
See built on alternate frames

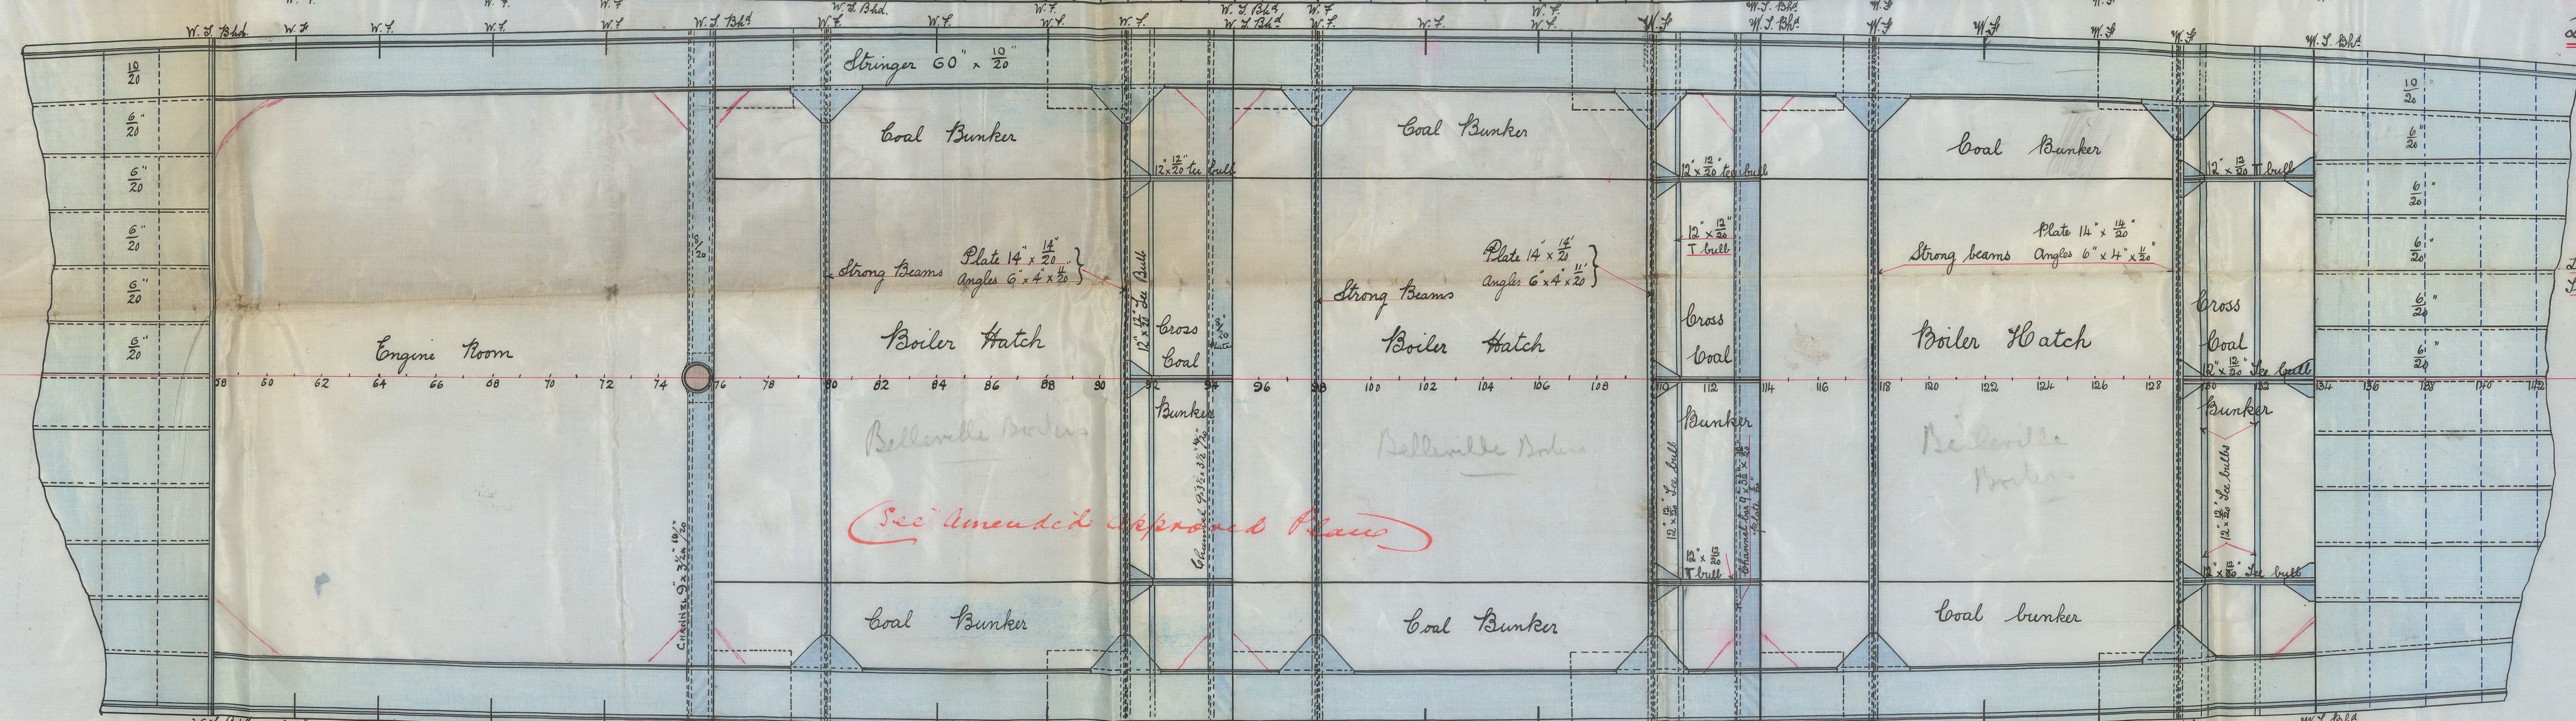

Orlop Deck

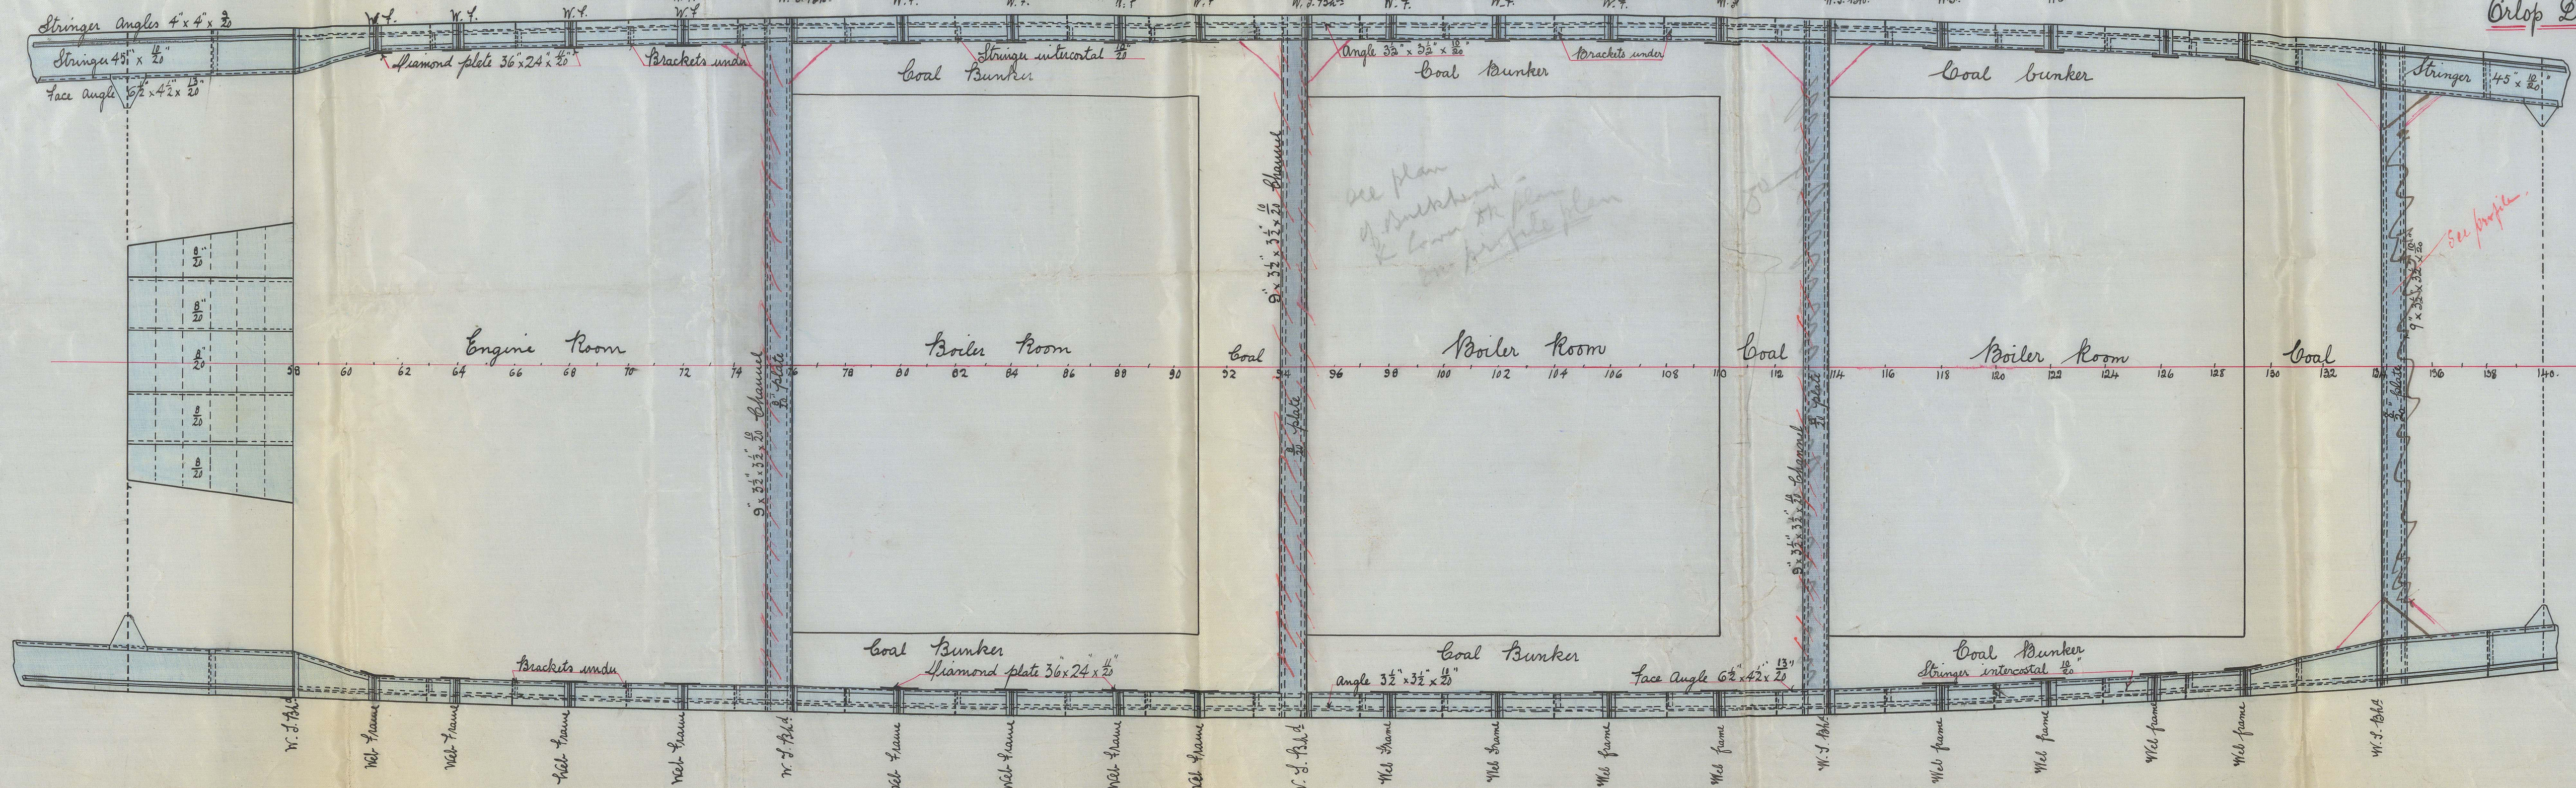


29/3/97
7/4/97

G13270-0058

Clydebank Ex
SB. Co. No. 307
S.S. "Moskva"

Ho. Rpt. No. 16439

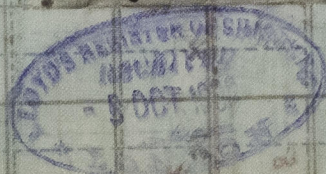

Main, Lower and
Orlop Decks.



© 2021

Lloyd's Register
Foundation

GLS270-0058