

29.3.97  
15.4.97

S.S. 26: 307.  
Upper & Bridge Decks, shewing  
strengthening in way of machinery  
openings.  
Scale 1/8" = 1 Foot.

Upper & Bridge Decks





Bridge Deck Beams 8" x 3" x 20' Angle Bulbs.

open at sides above

Bridge Deck.

(See Separate Arranged Plan)

Plan of Bridge Deck  
see arranged plan  
attached

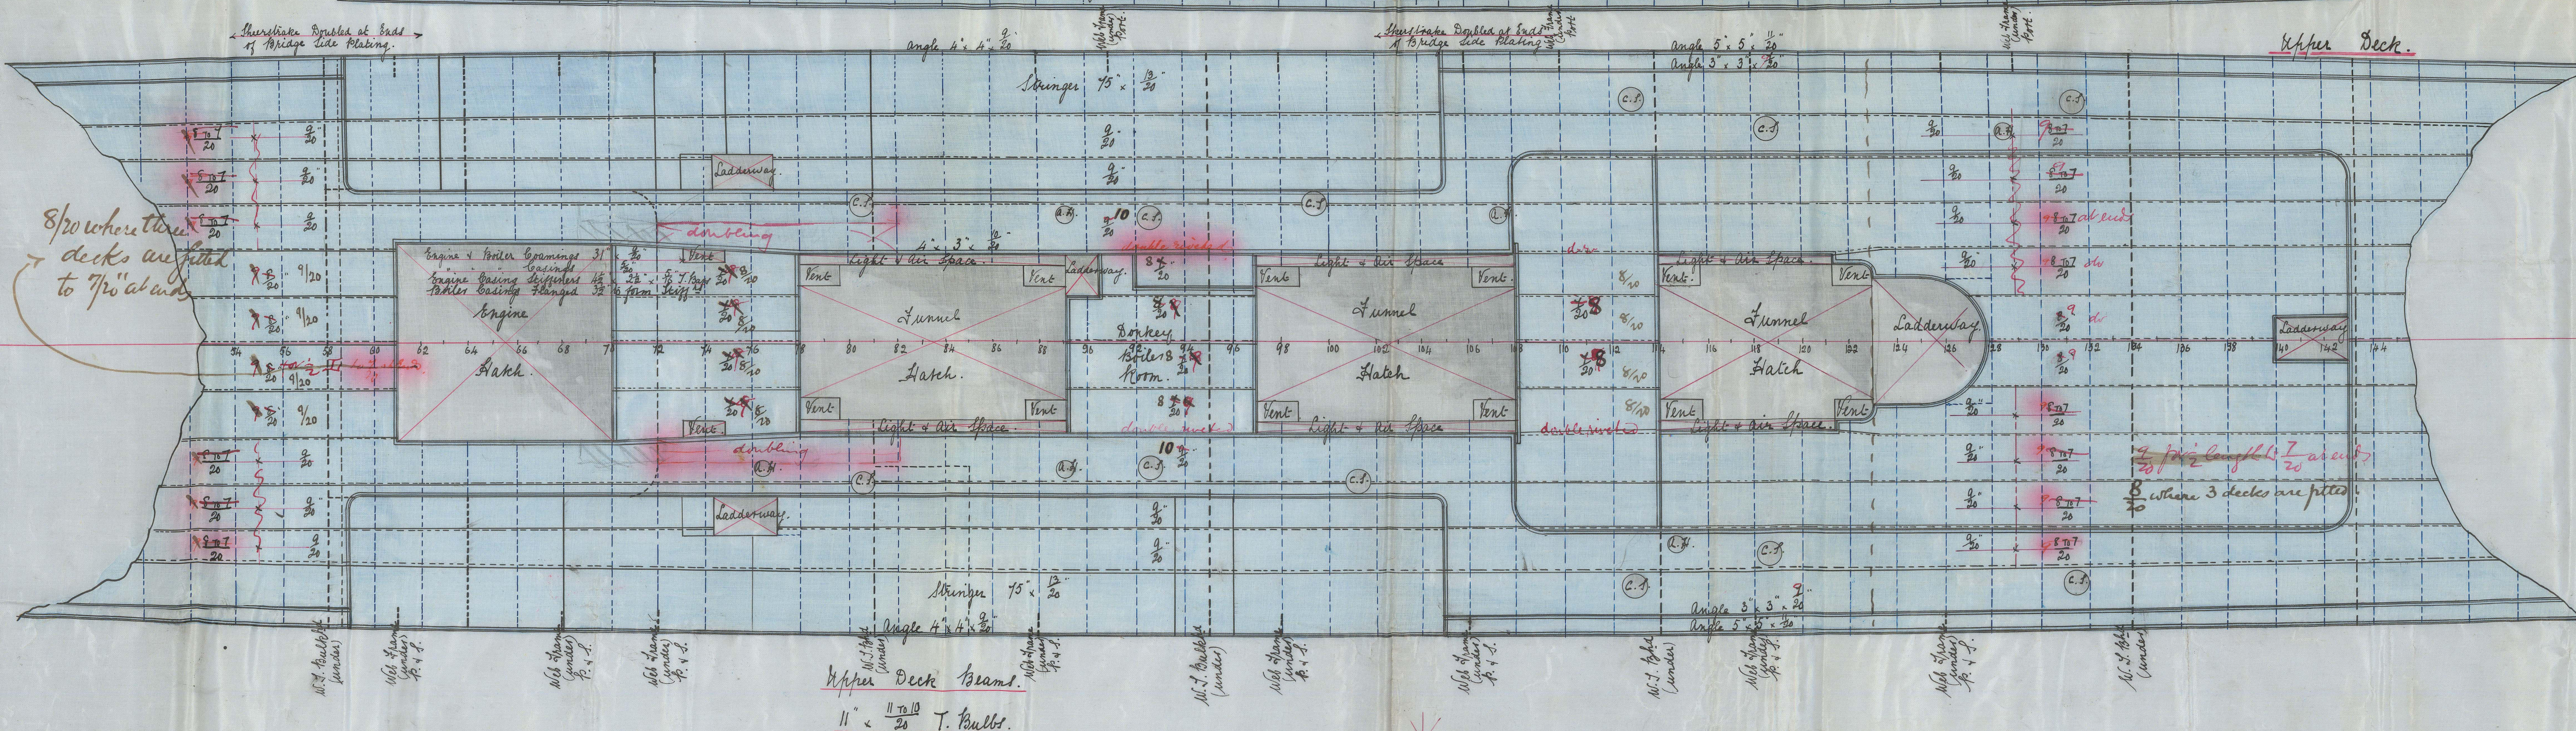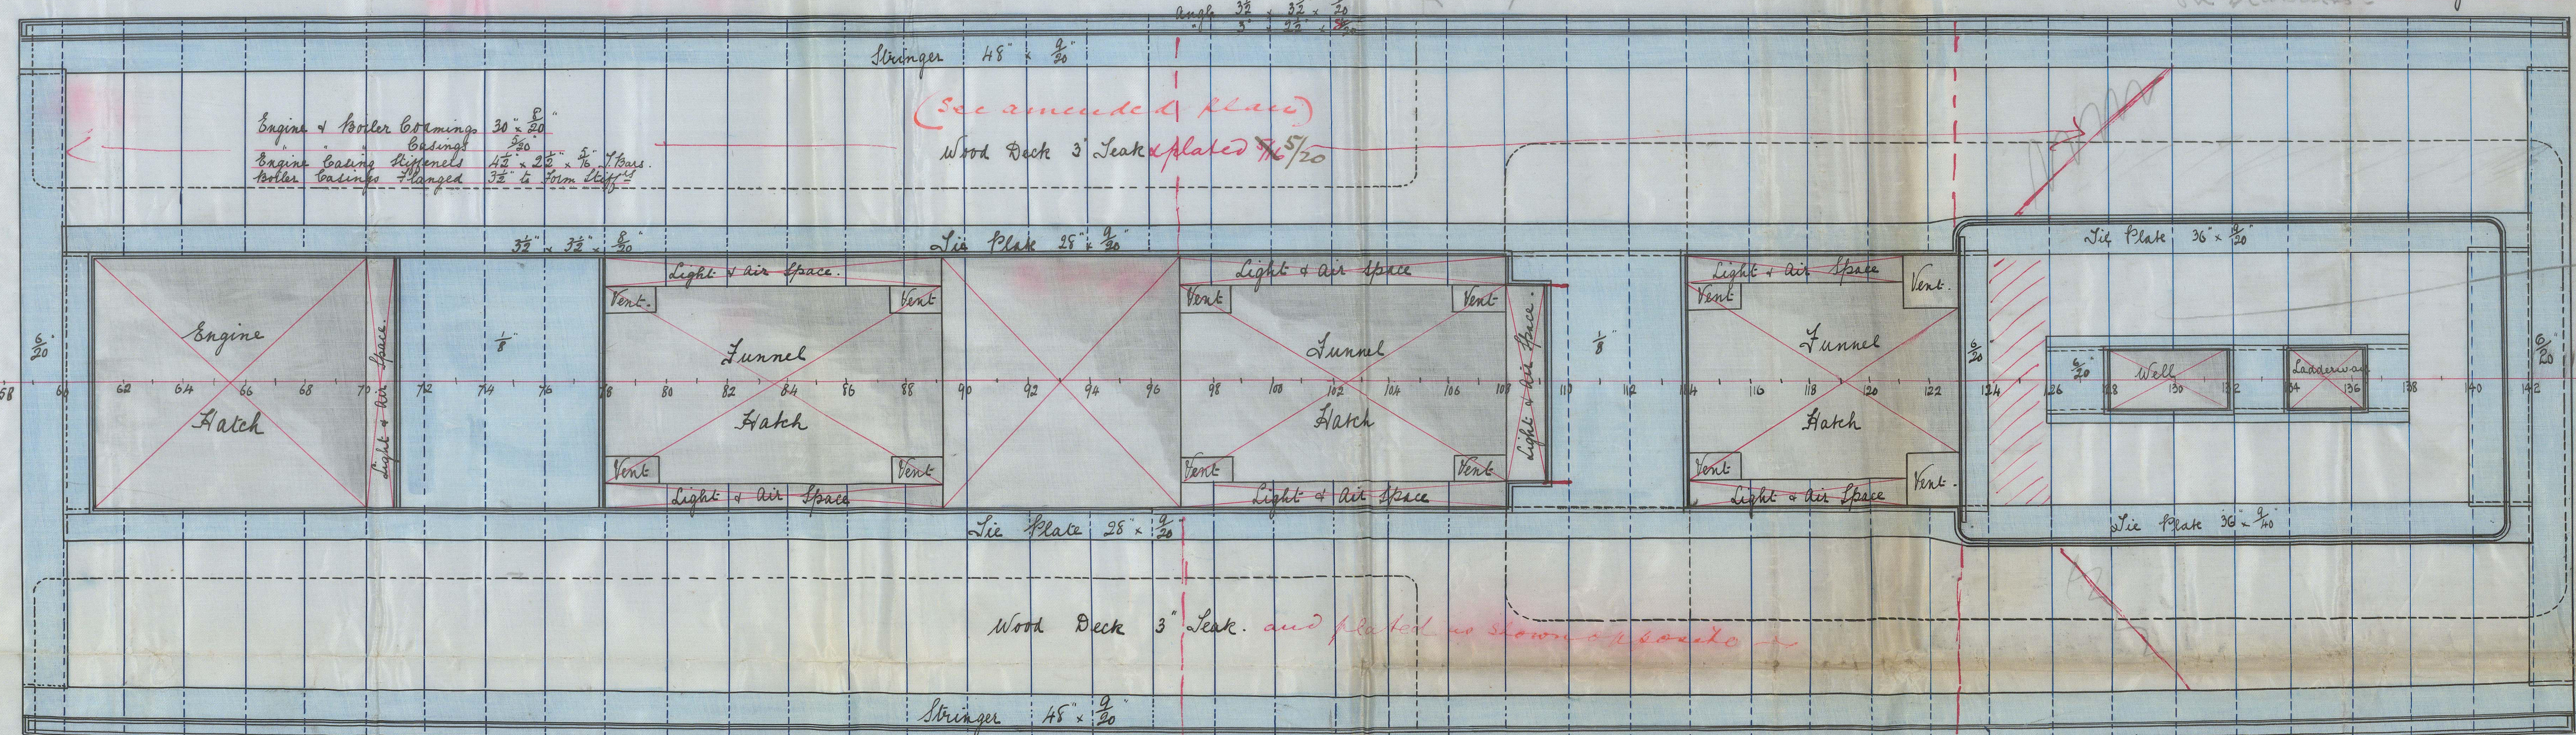

8/20 where three  
decks are fitted  
to 7/20 at end

1/20 where 3 decks are fitted

27/3/97  
7/4/97





X

*General Plan*


Scale of 1" = 20'

Plan of Bridge Deck  
Scale 1" = 10'

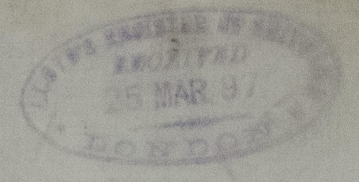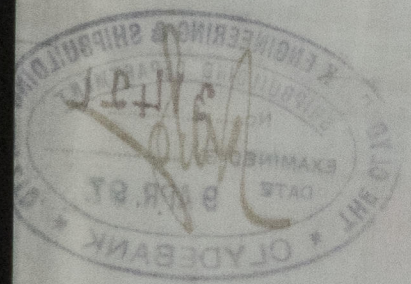

*Upper & Bridge Decks*

GLS270-0065

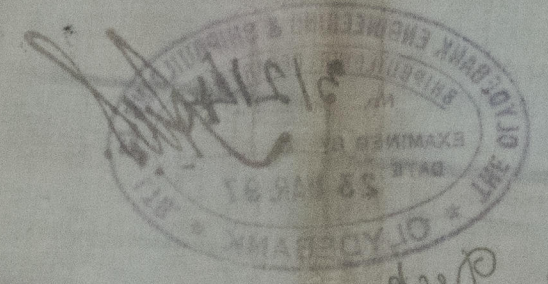

Plan of Bridge Deck  
Scale 1" = 10'

*General Plan*

