



20.5.97

T. S. S. MOSKVA.
No 307.
RIGGING PLAN.

SCALE 1/4" = 1 FOOT.

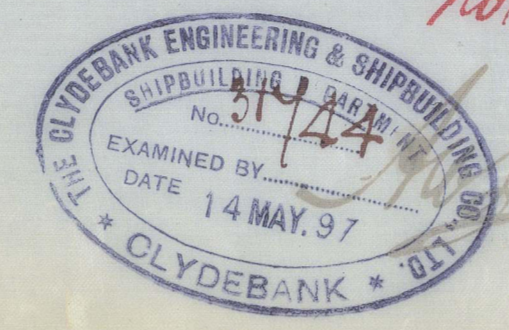

Upward to 100 ft
to 100 ft
to 100 ft
to 100 ft

 

NOTE: - POLE MASTS OF PINE ARE FITTED INTO STEEL MASTS.
STANDING RIGGING OF BEST GALVANIZED STEEL WIRE ROPE.
RIVETING AS PER RULE.

17/6
20/5/97

GLS270-0068

