


# STARBOARD L.P. CYLINDER

S.S. "MOSKVA" ENGINES N° 307

SCALES  $\frac{1}{2}$ " = 1 FOOT & FULL SIZE.


*L.P.  
Cylinder*

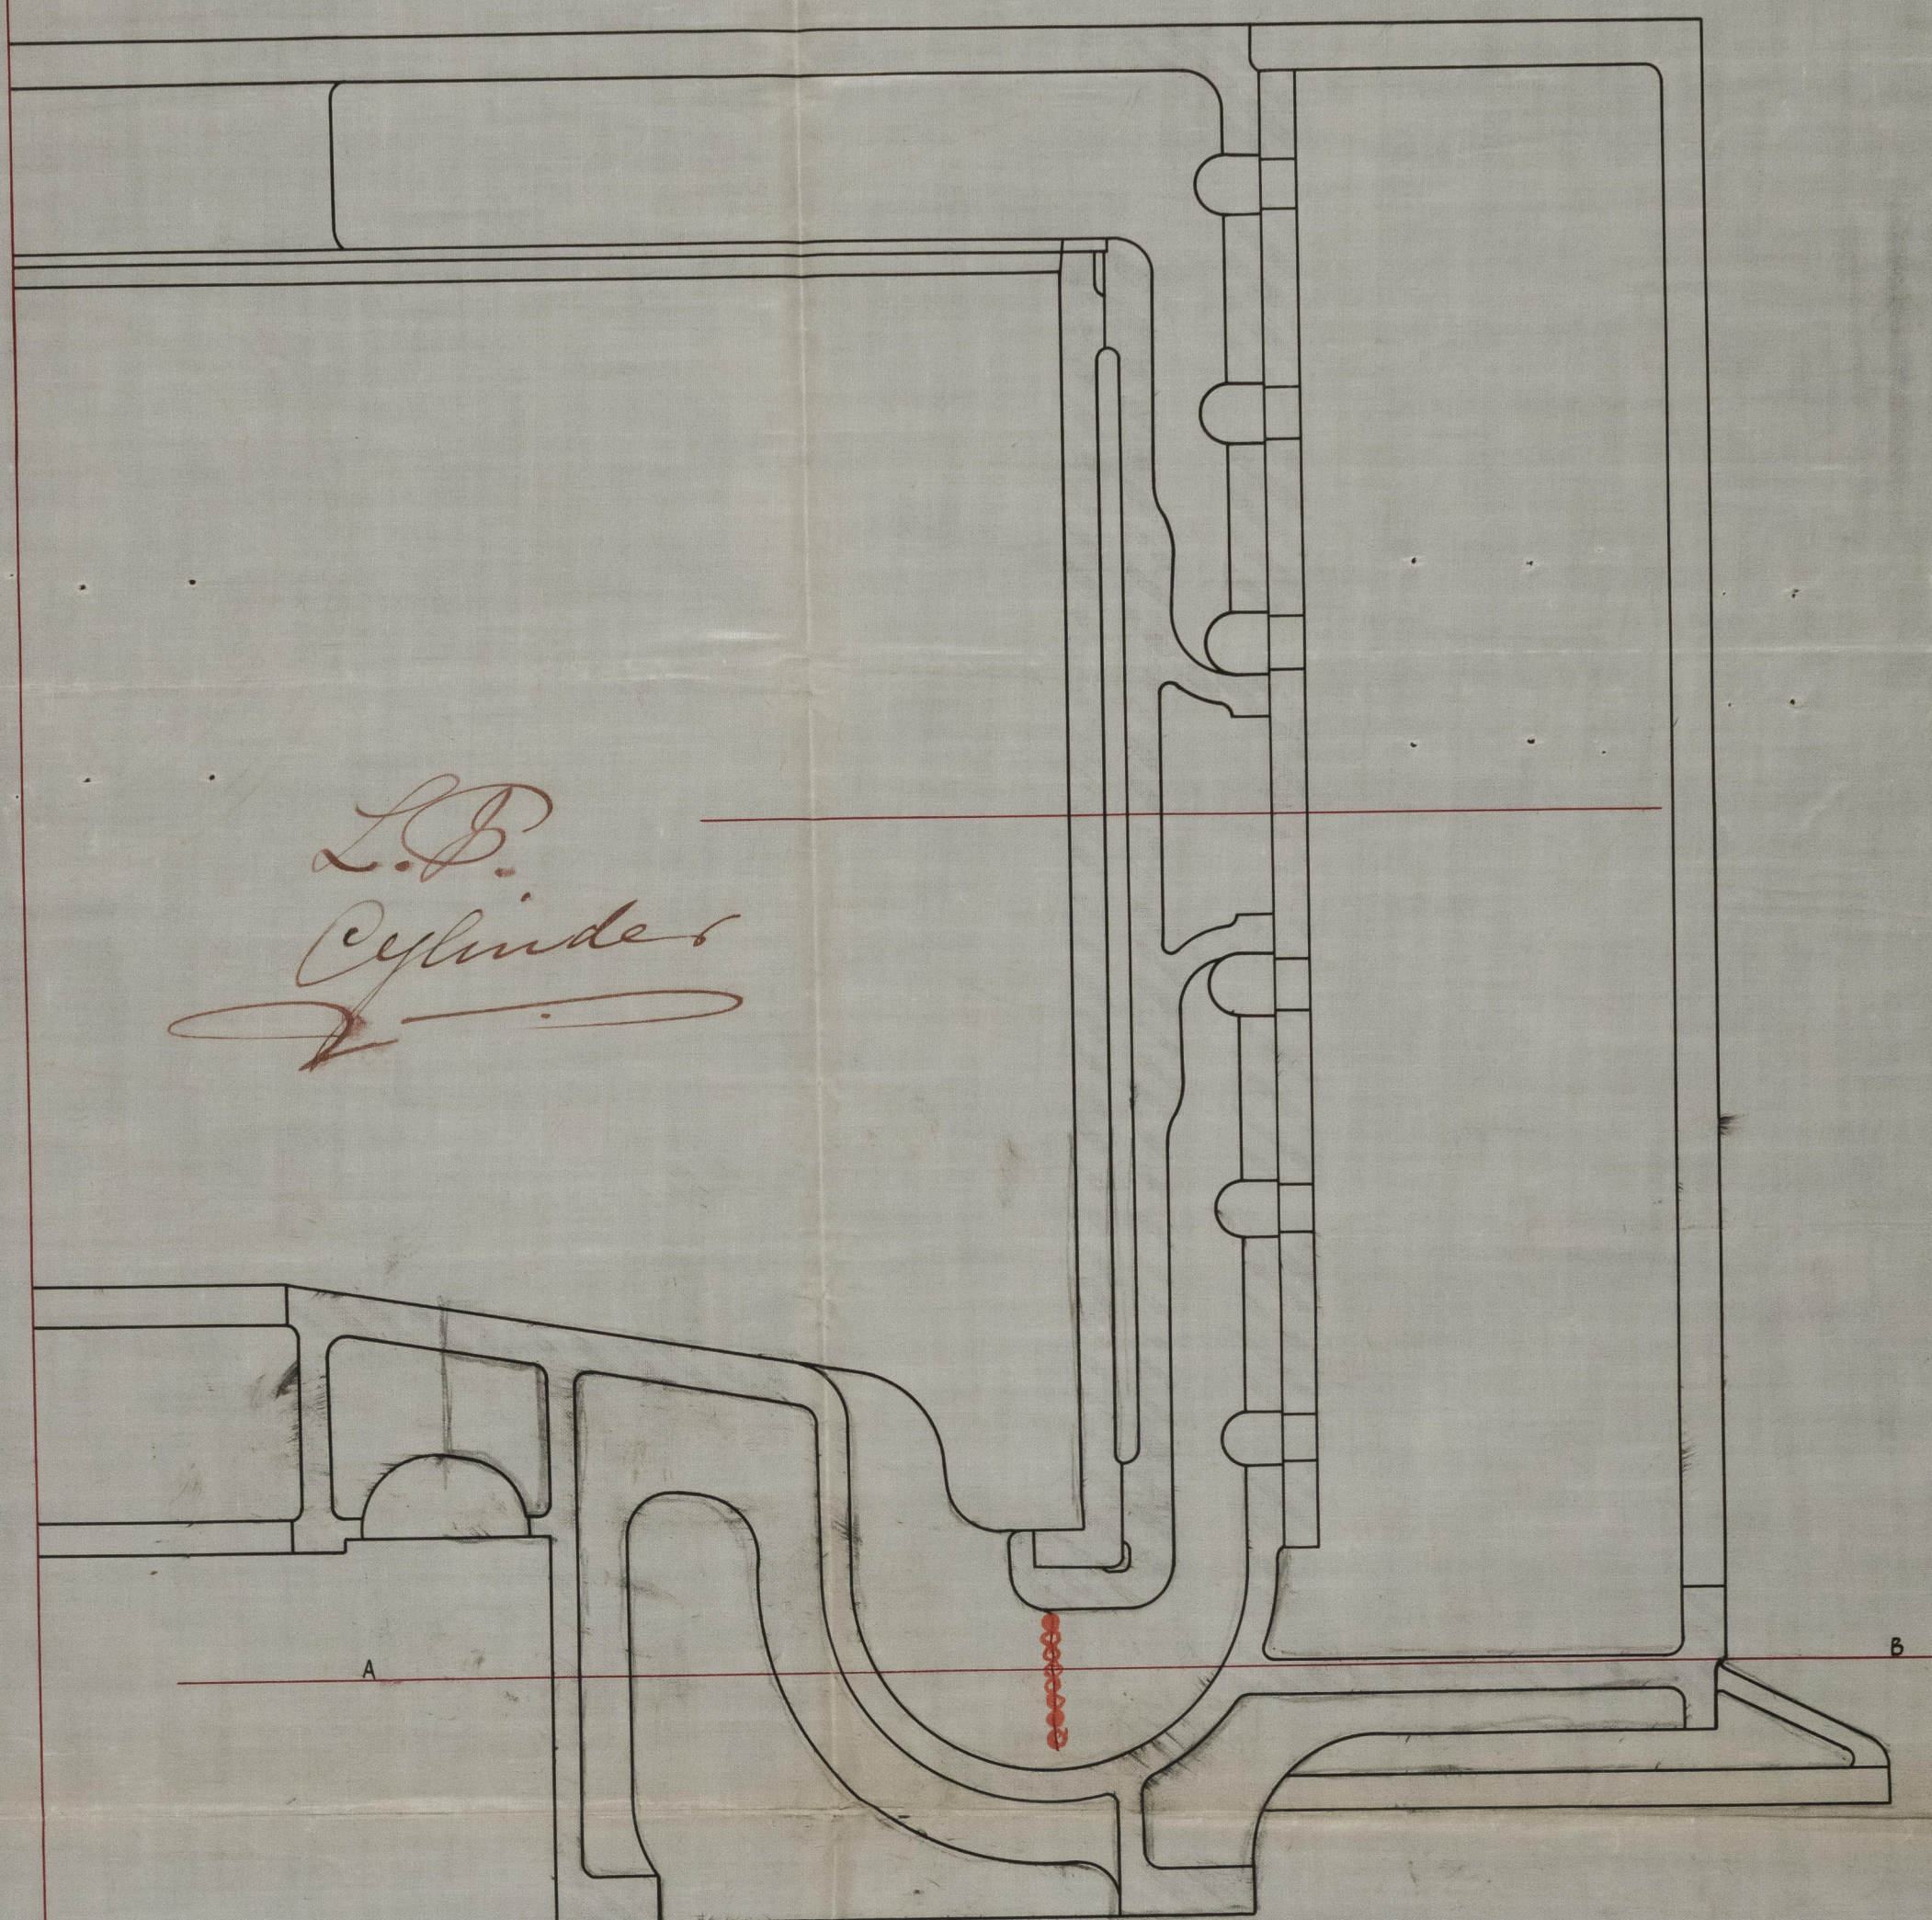

SECTION THRO STARBOARD L.P. CYLINDER LOOKING FORWARD

CRACK SHEWN BY RED LINE

*AM  
19/10/98*

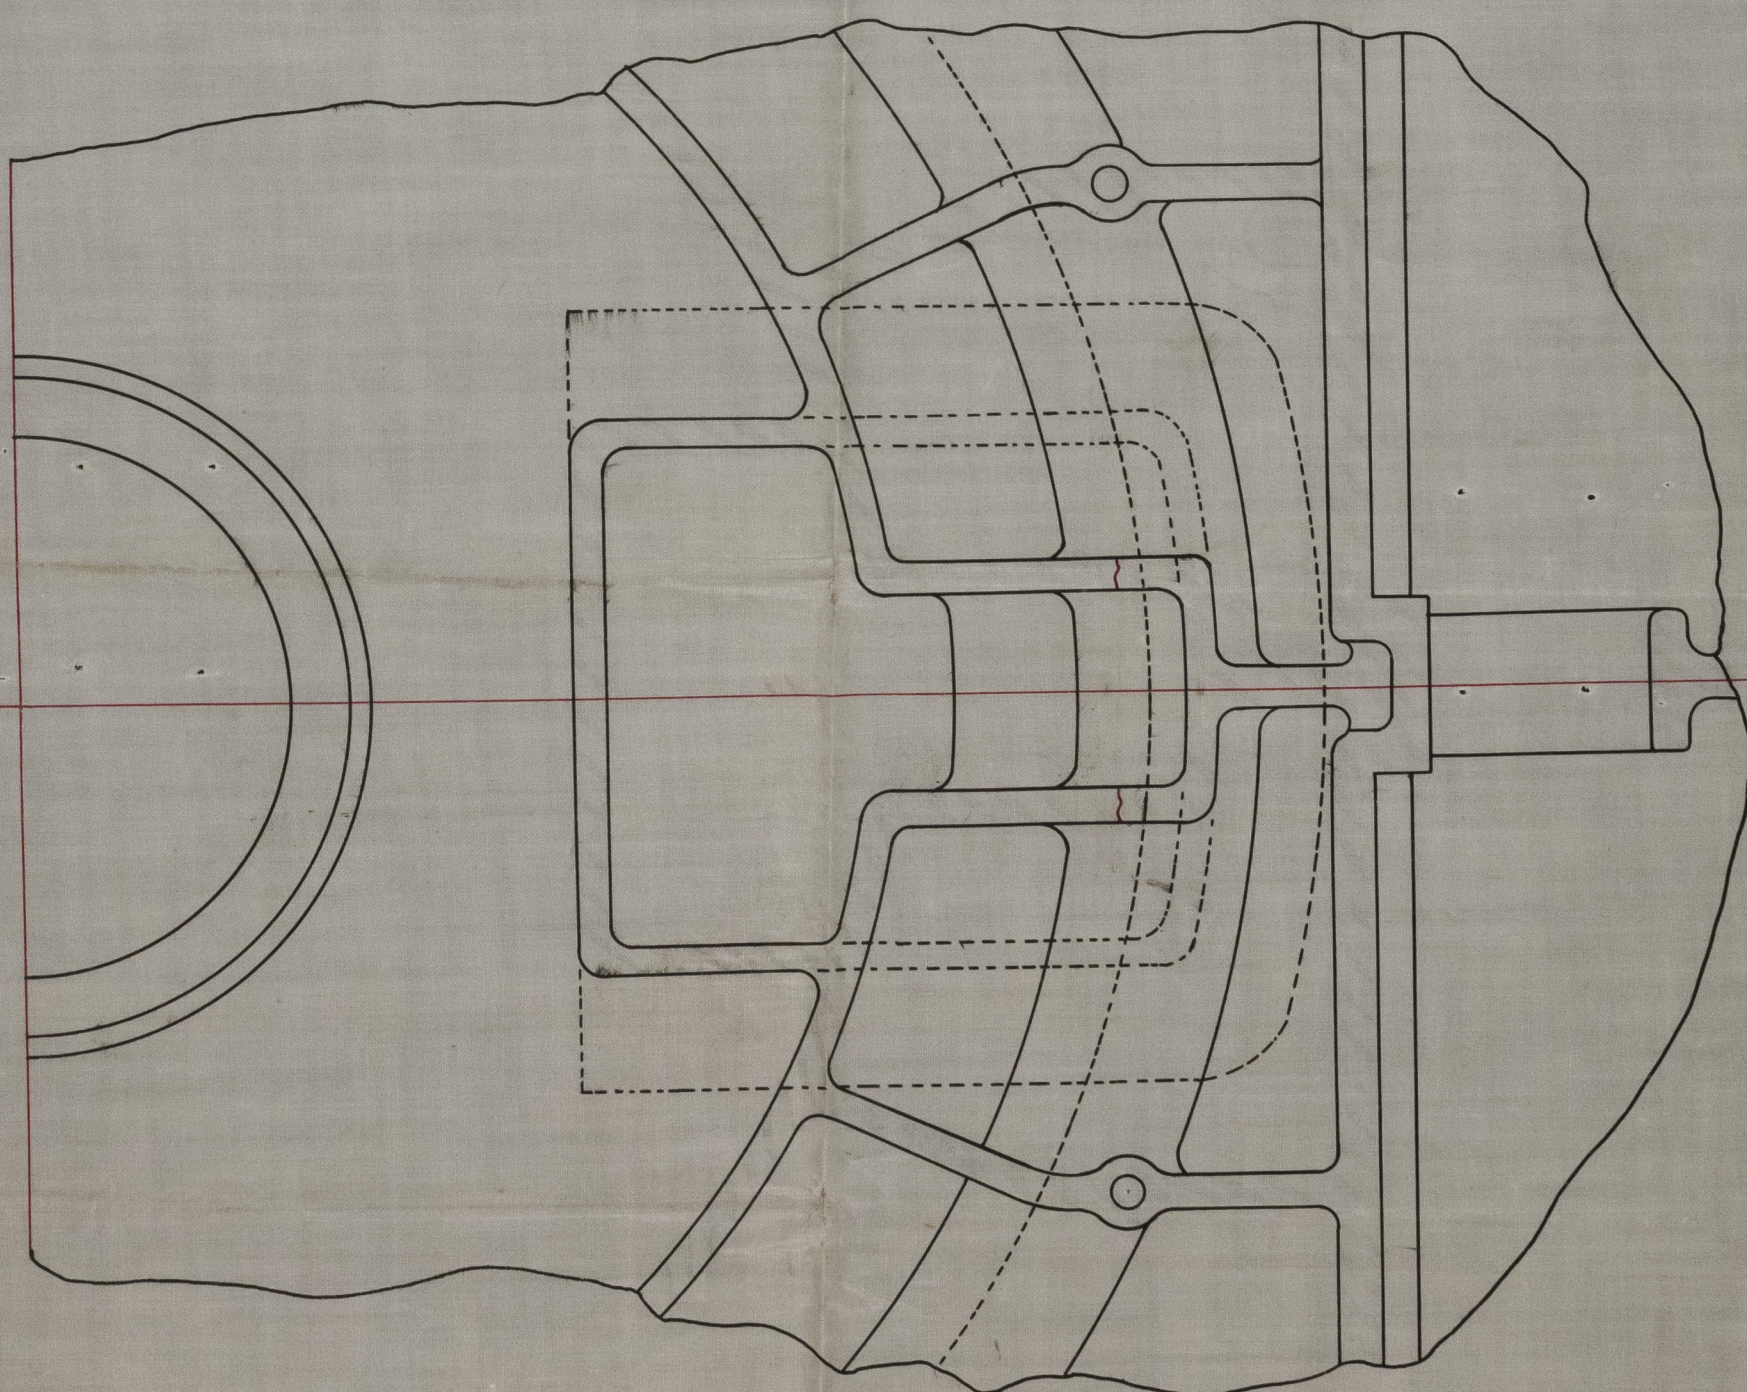

SECTION THRO A.B. LOOKING UP.

COLUMN FOOT SHEWN DOTTED

CRACKS SHEWN BY RED LINES



© 2021


Lloyd's Register  
Foundation

G13270-0083



St Moskva  
Gr 16439

GLS270-0083

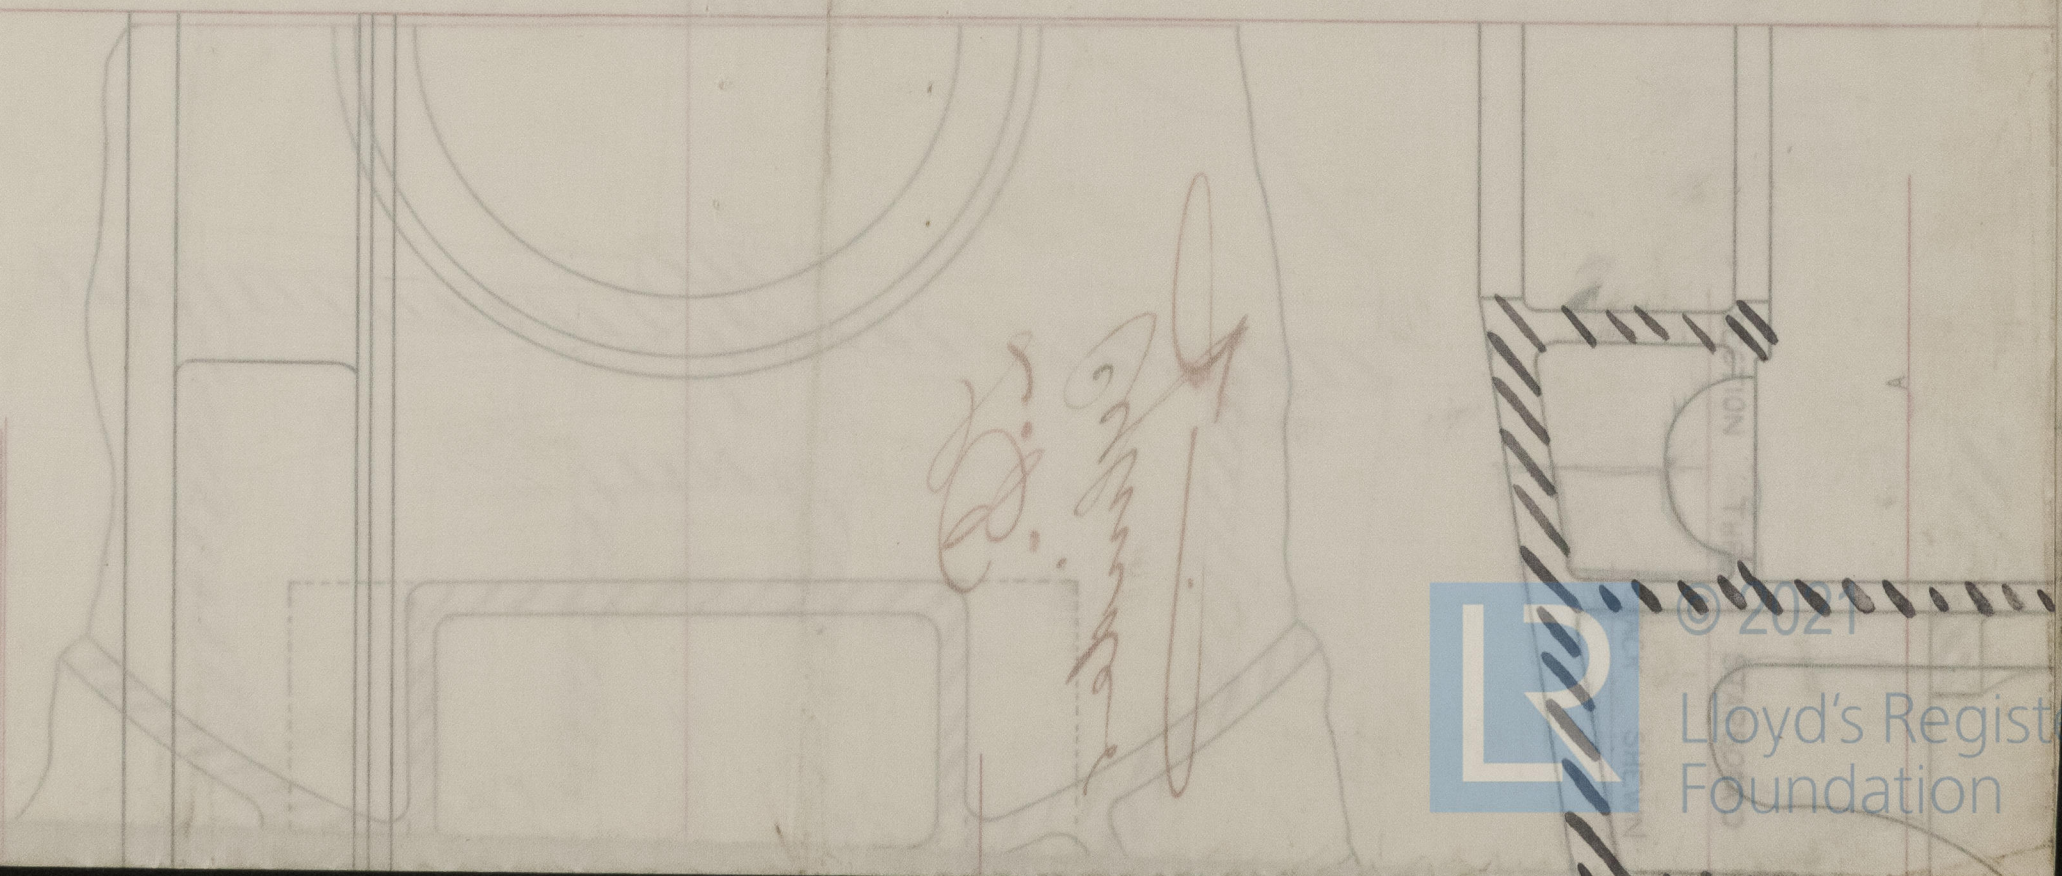

*Handwritten signature or initials in red ink.*

SECTION THROUGH  
2.2 " MOSKVA " ENG  
STARBOARD L.P. C



© 2021  
Lloyd's Register  
Foundation