



S.S.S.  
"Mastwa"

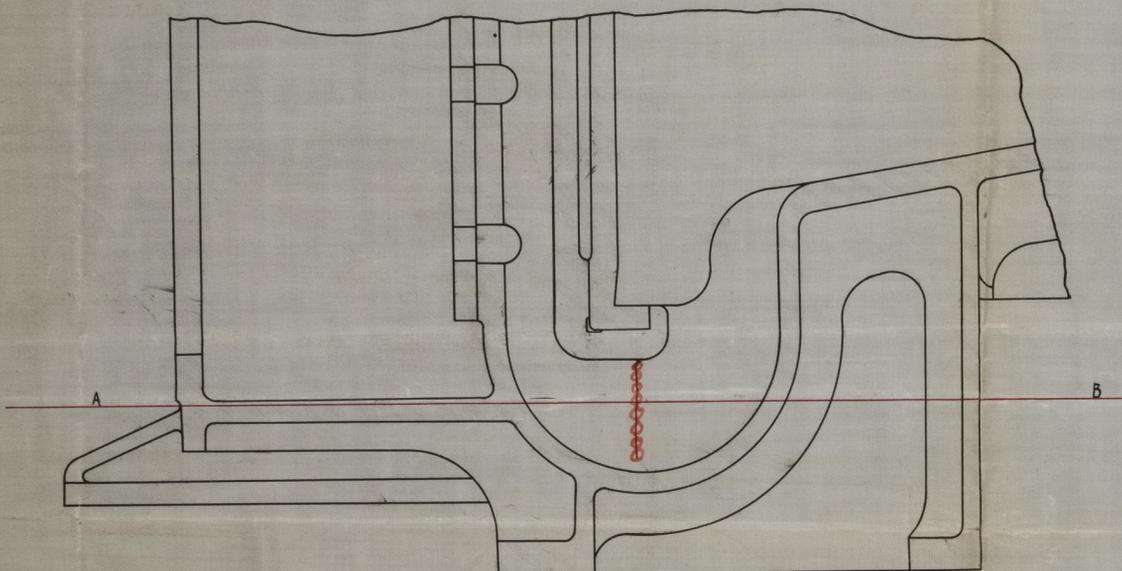

SECTION THRO STARBOARD L.P. CYLINDER LOOKING AFT

CRACK SHEWN BY RED LINE

*M. [unclear] 10/10/98*

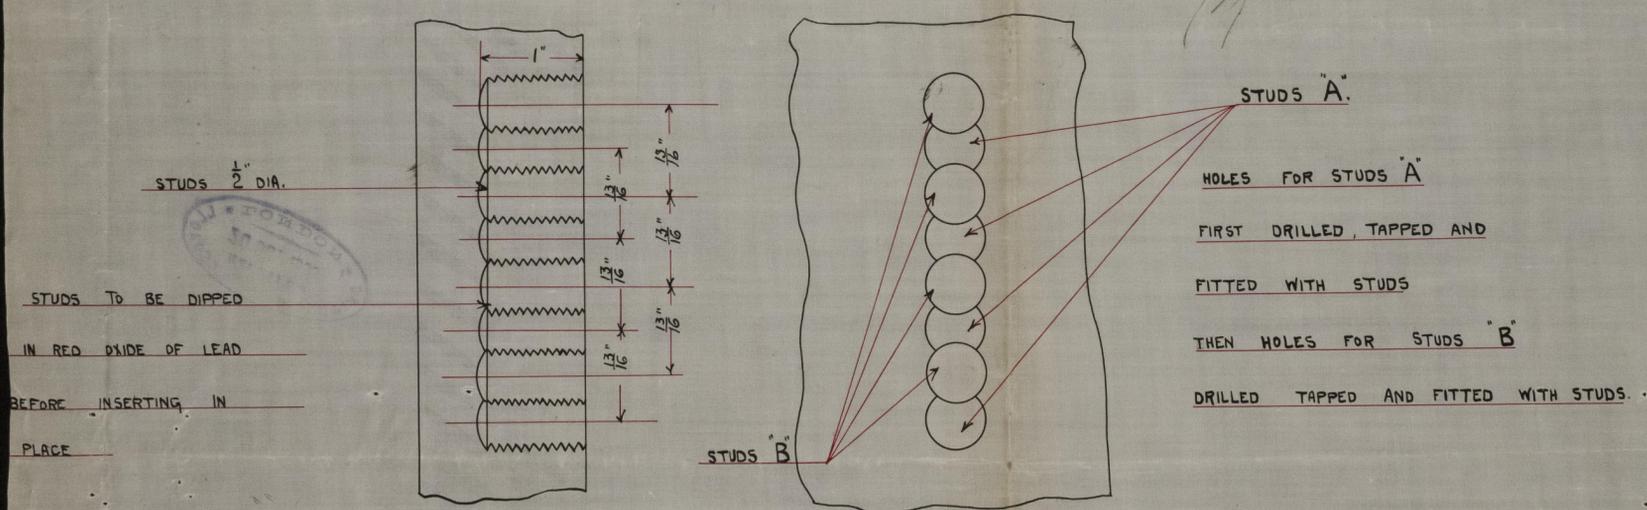

SKETCH SHEWING METHOD OF FILLING CRACKS

FULL SIZE.

*Revised [unclear]*



© 2021 Lloyd's Register Foundation

615270-0085

S/S Moskwa  
No 116439

GLS270-0085

SKETCH SHEWING METHOD OF

UNIT SIZE

