

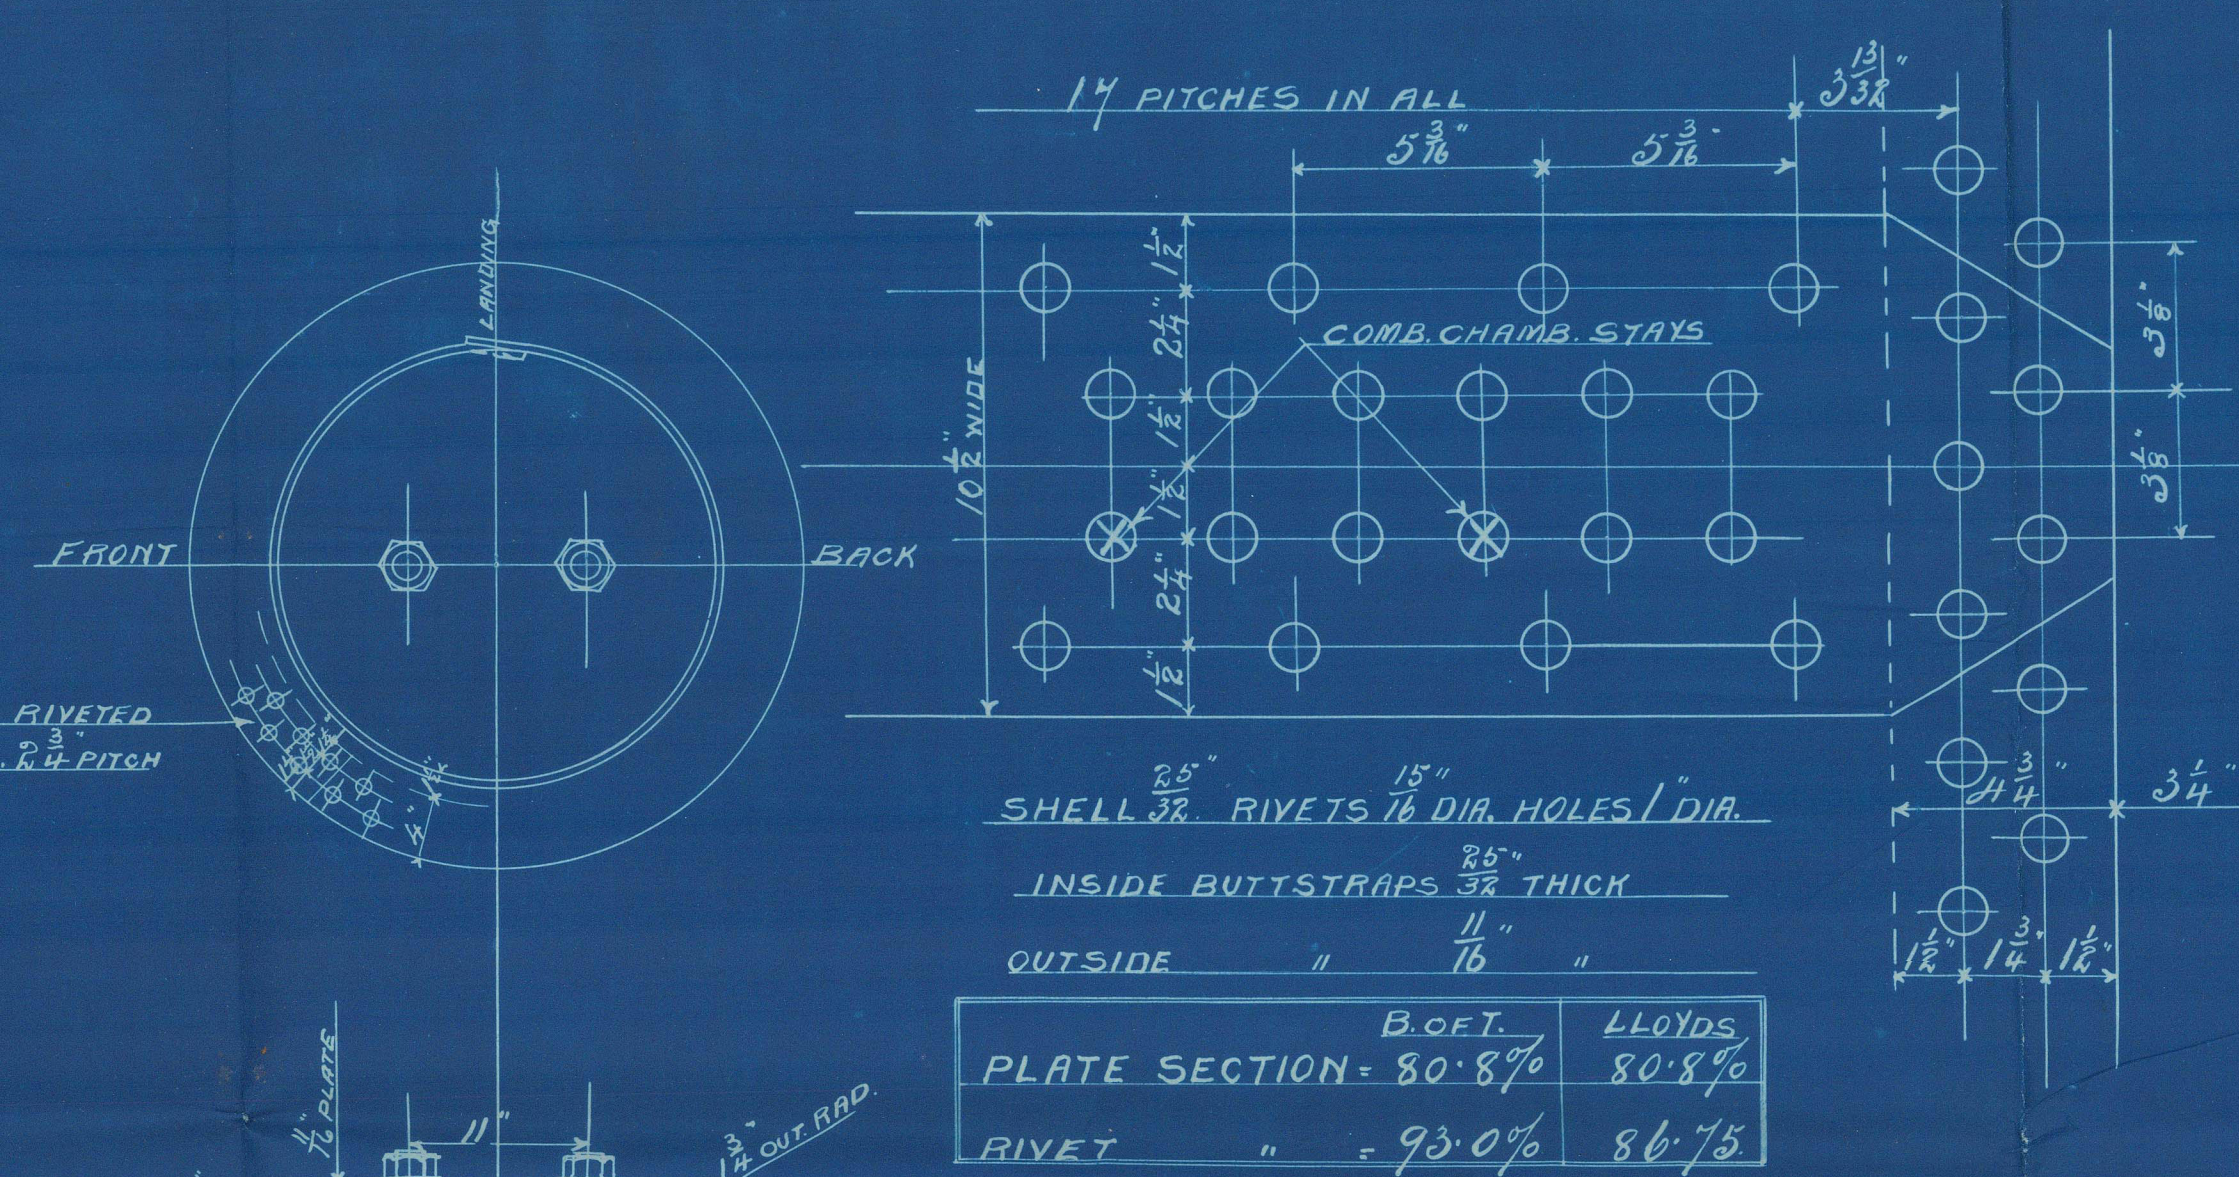
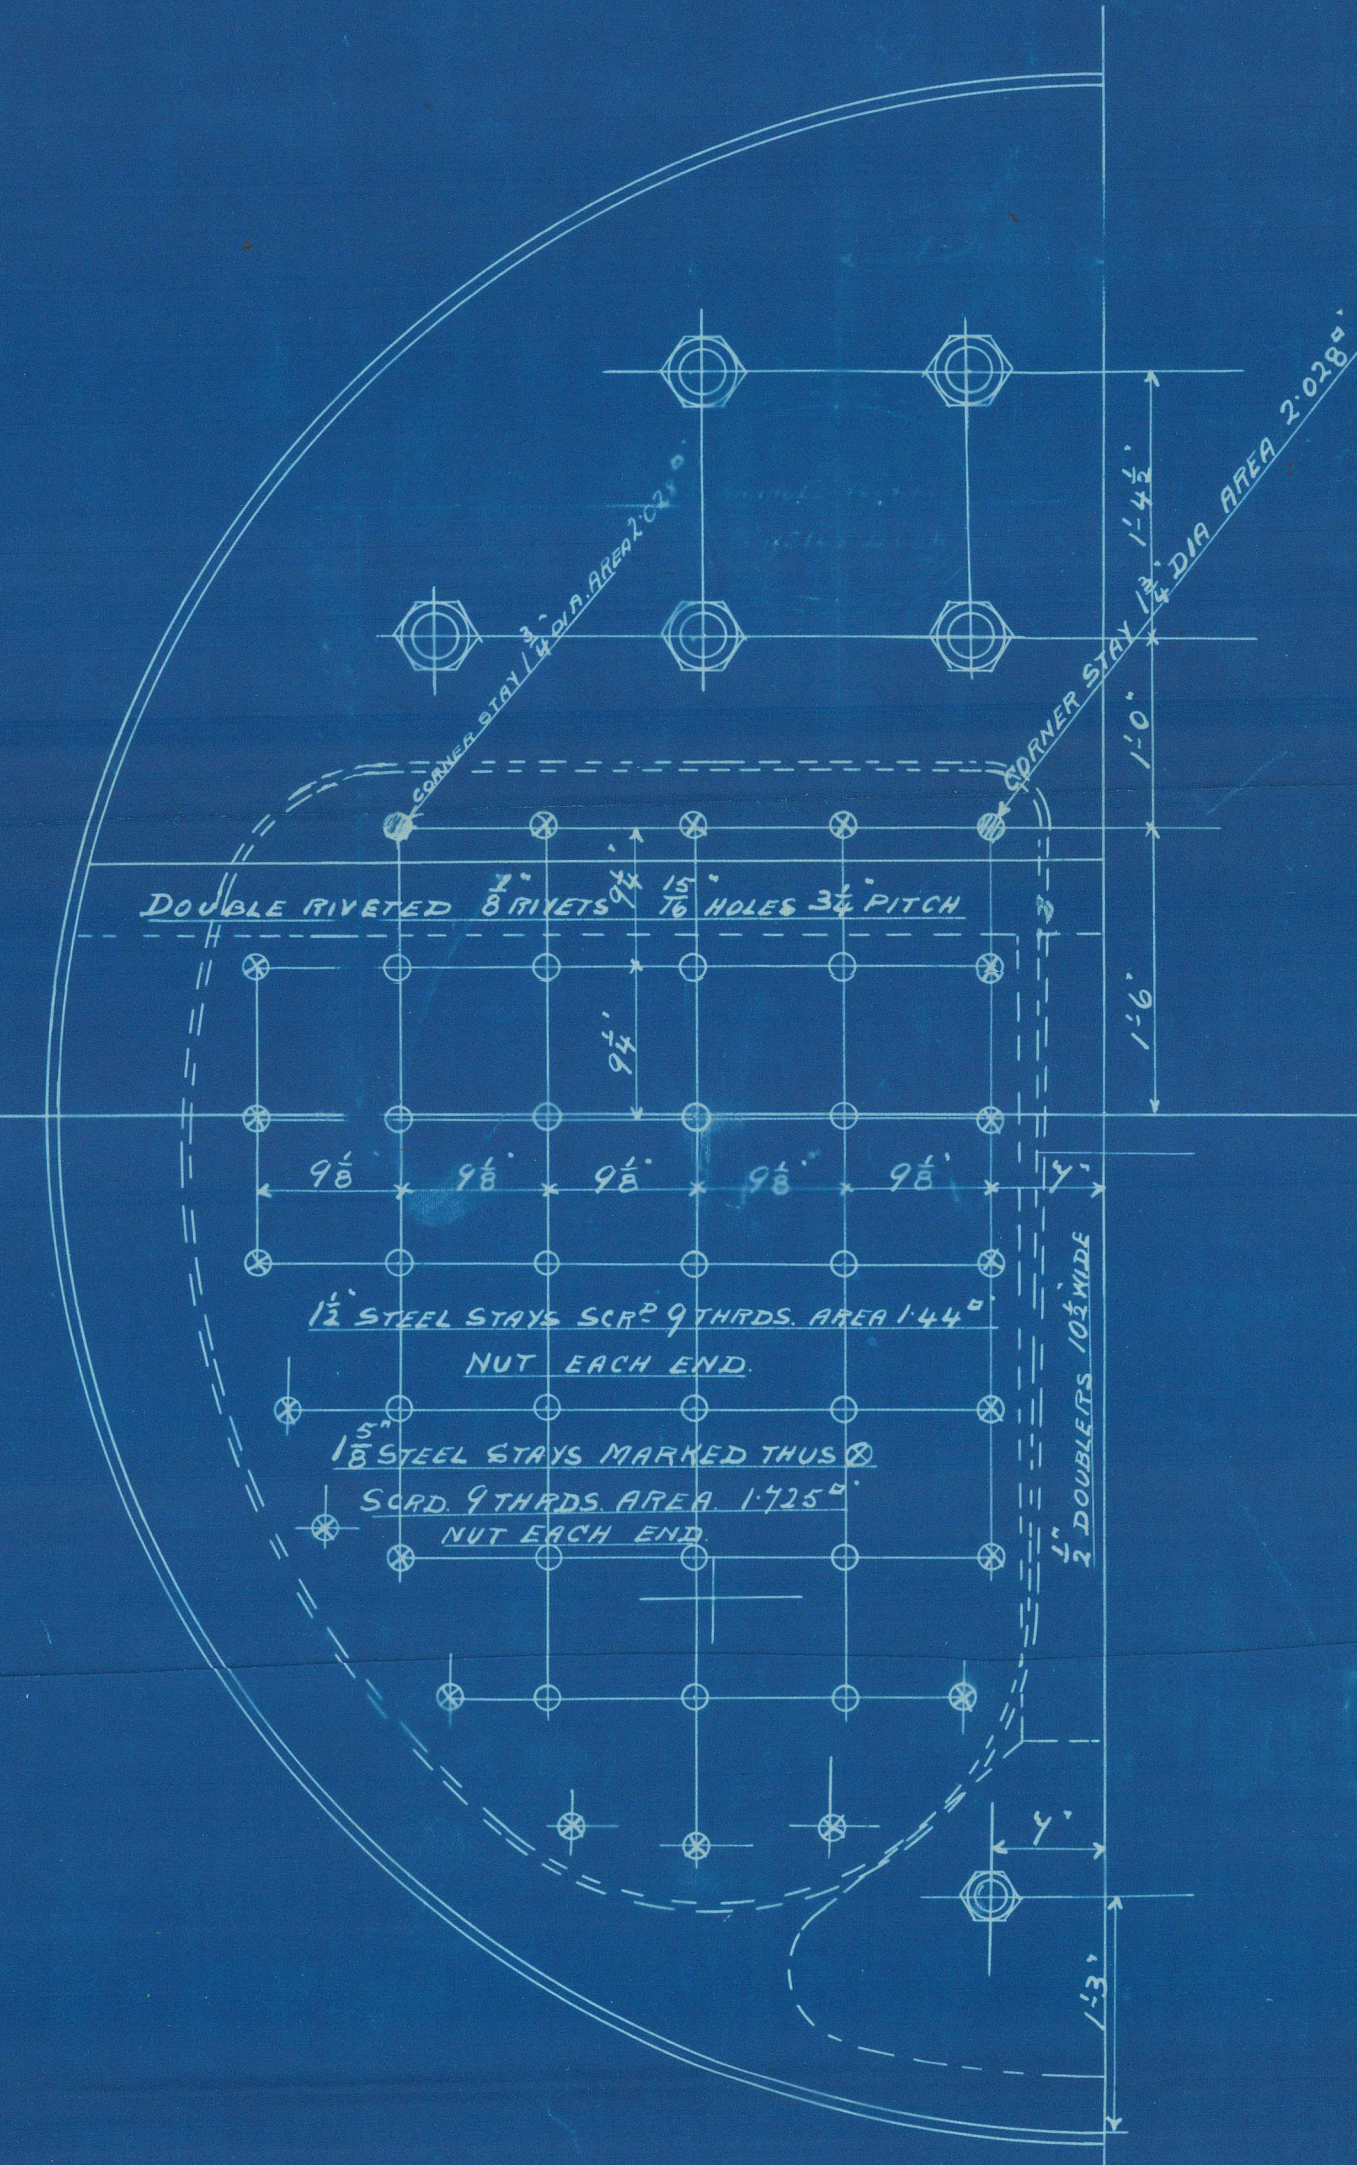


CIR. SEAM DOUBLE RIVETED  
3/4" RIVETS 1/2" HOLES 3/4" PITCH

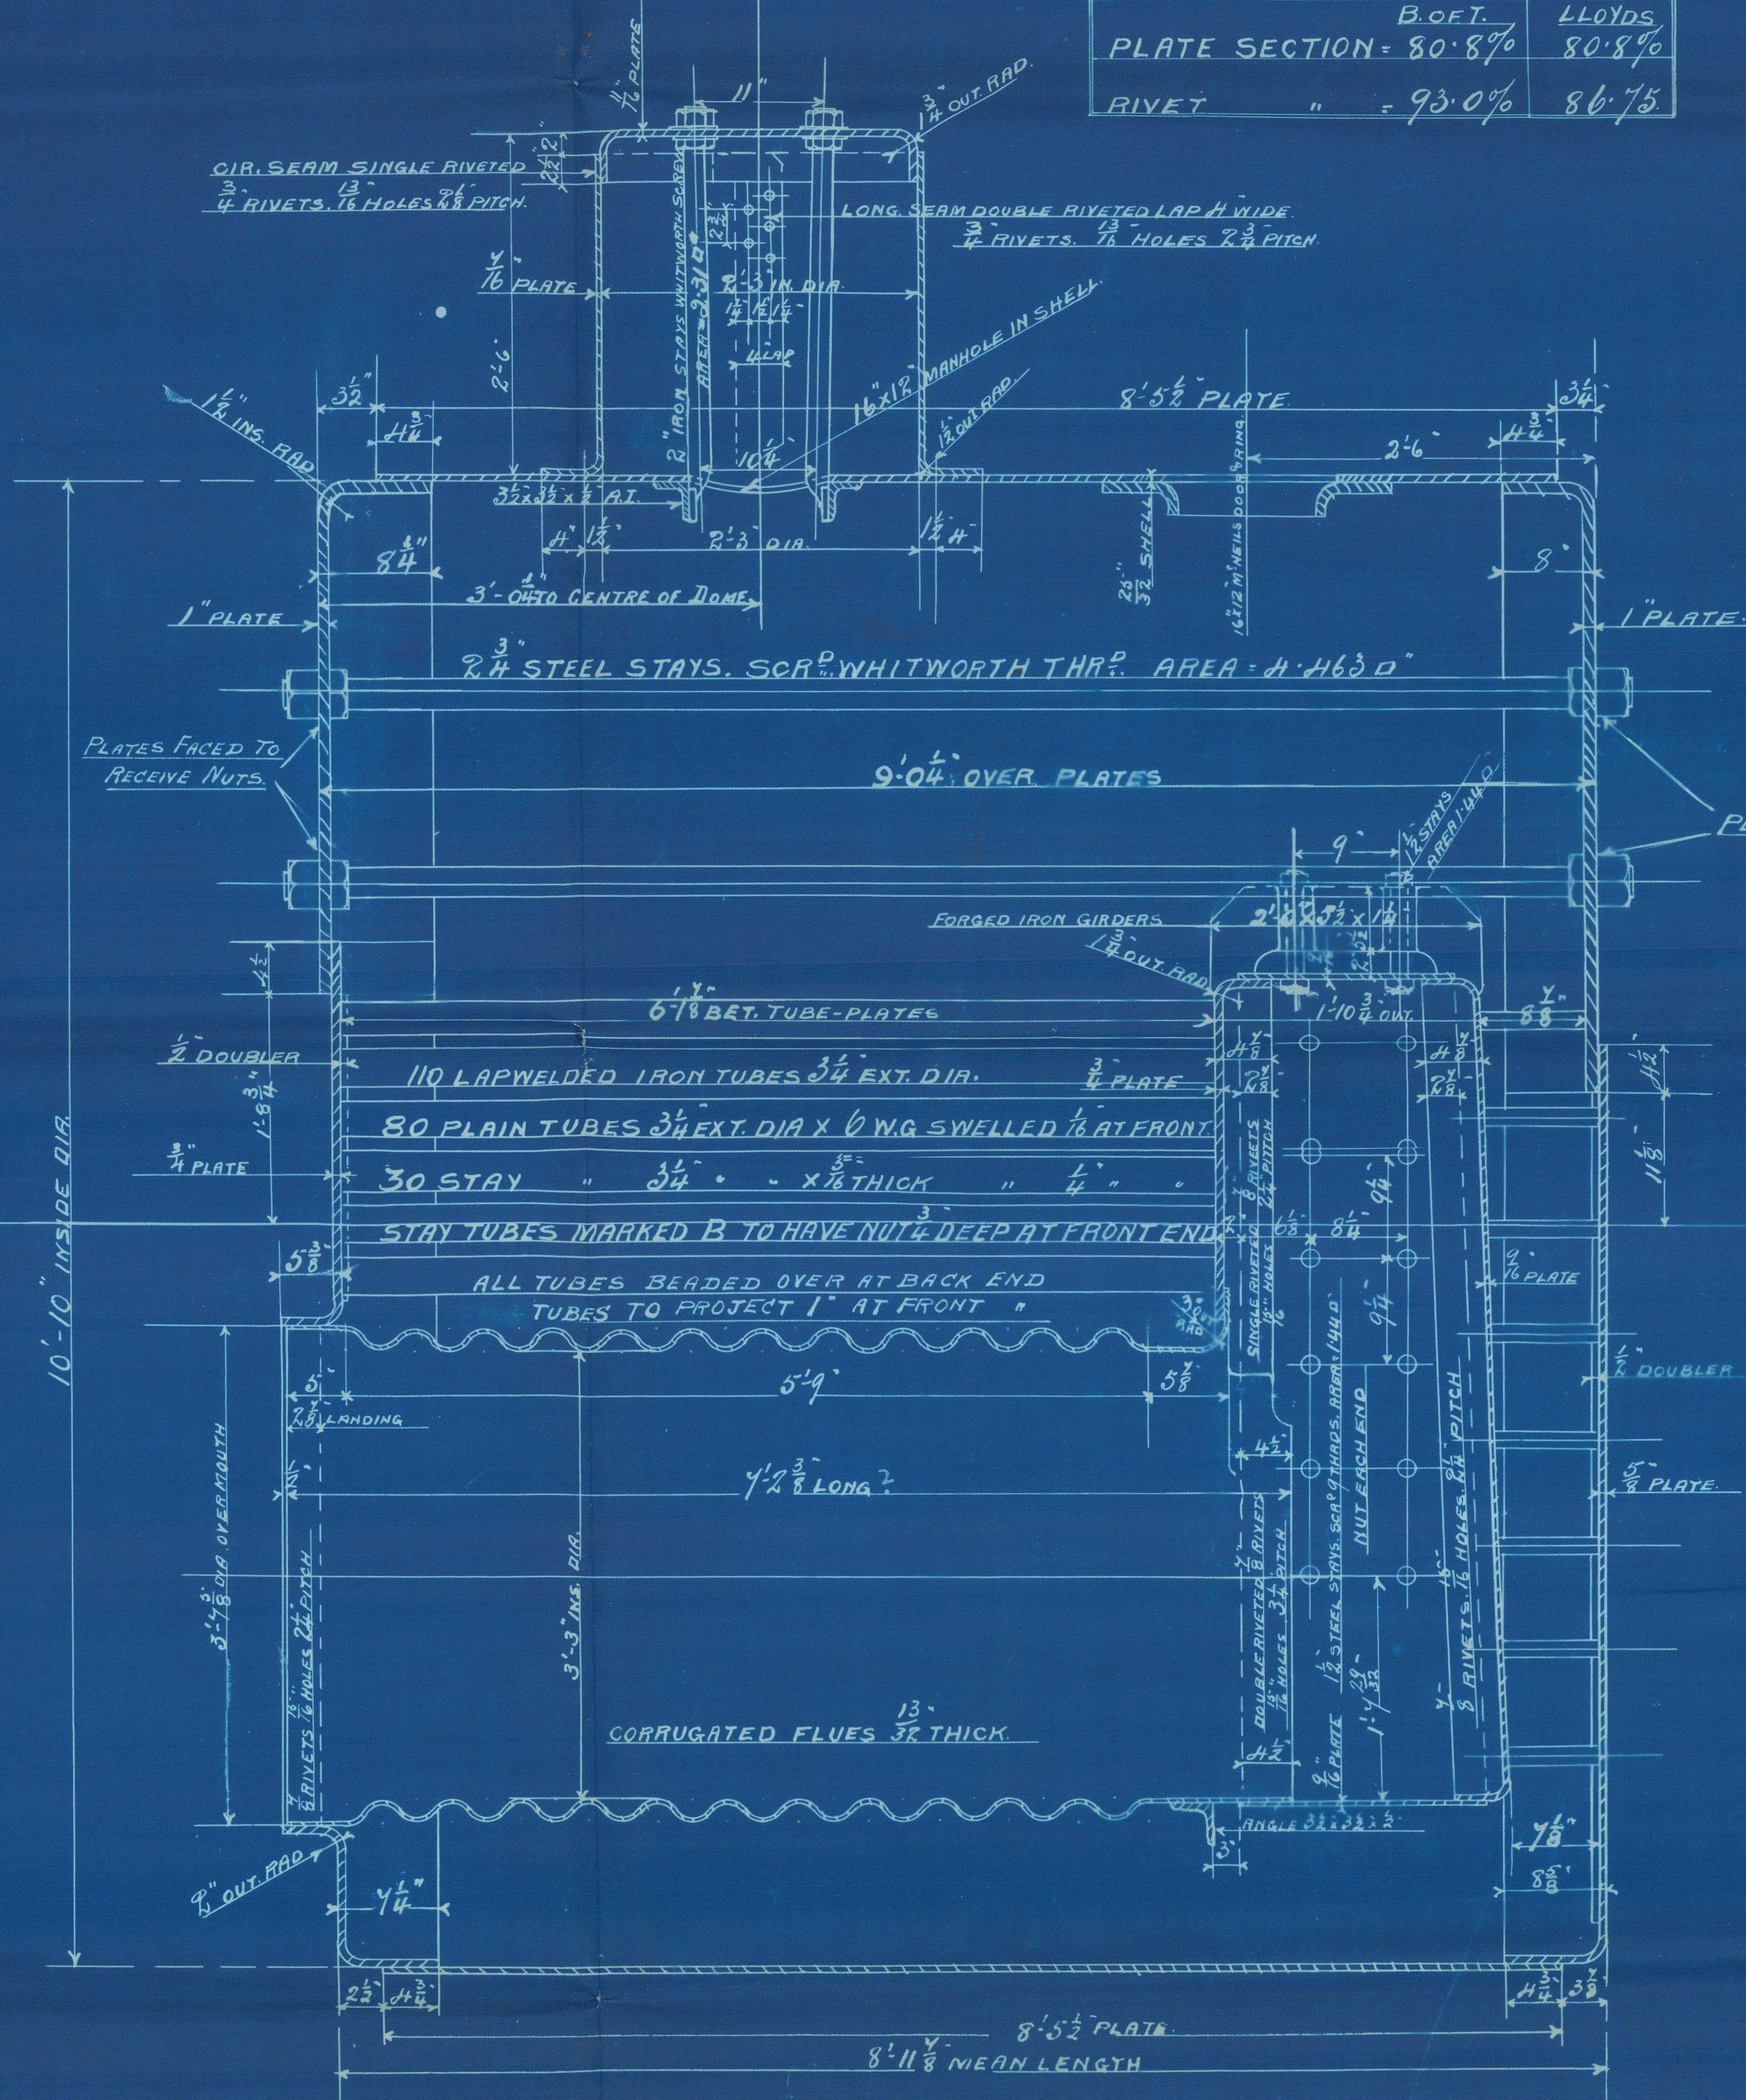

CIRCUMFER. SEAMS 16 RIVETS 1/2" HOLES

TENSILE STRENGTH OF SHELL 28 TO 32 TONS  
" " STAYS 27 TO 32 "

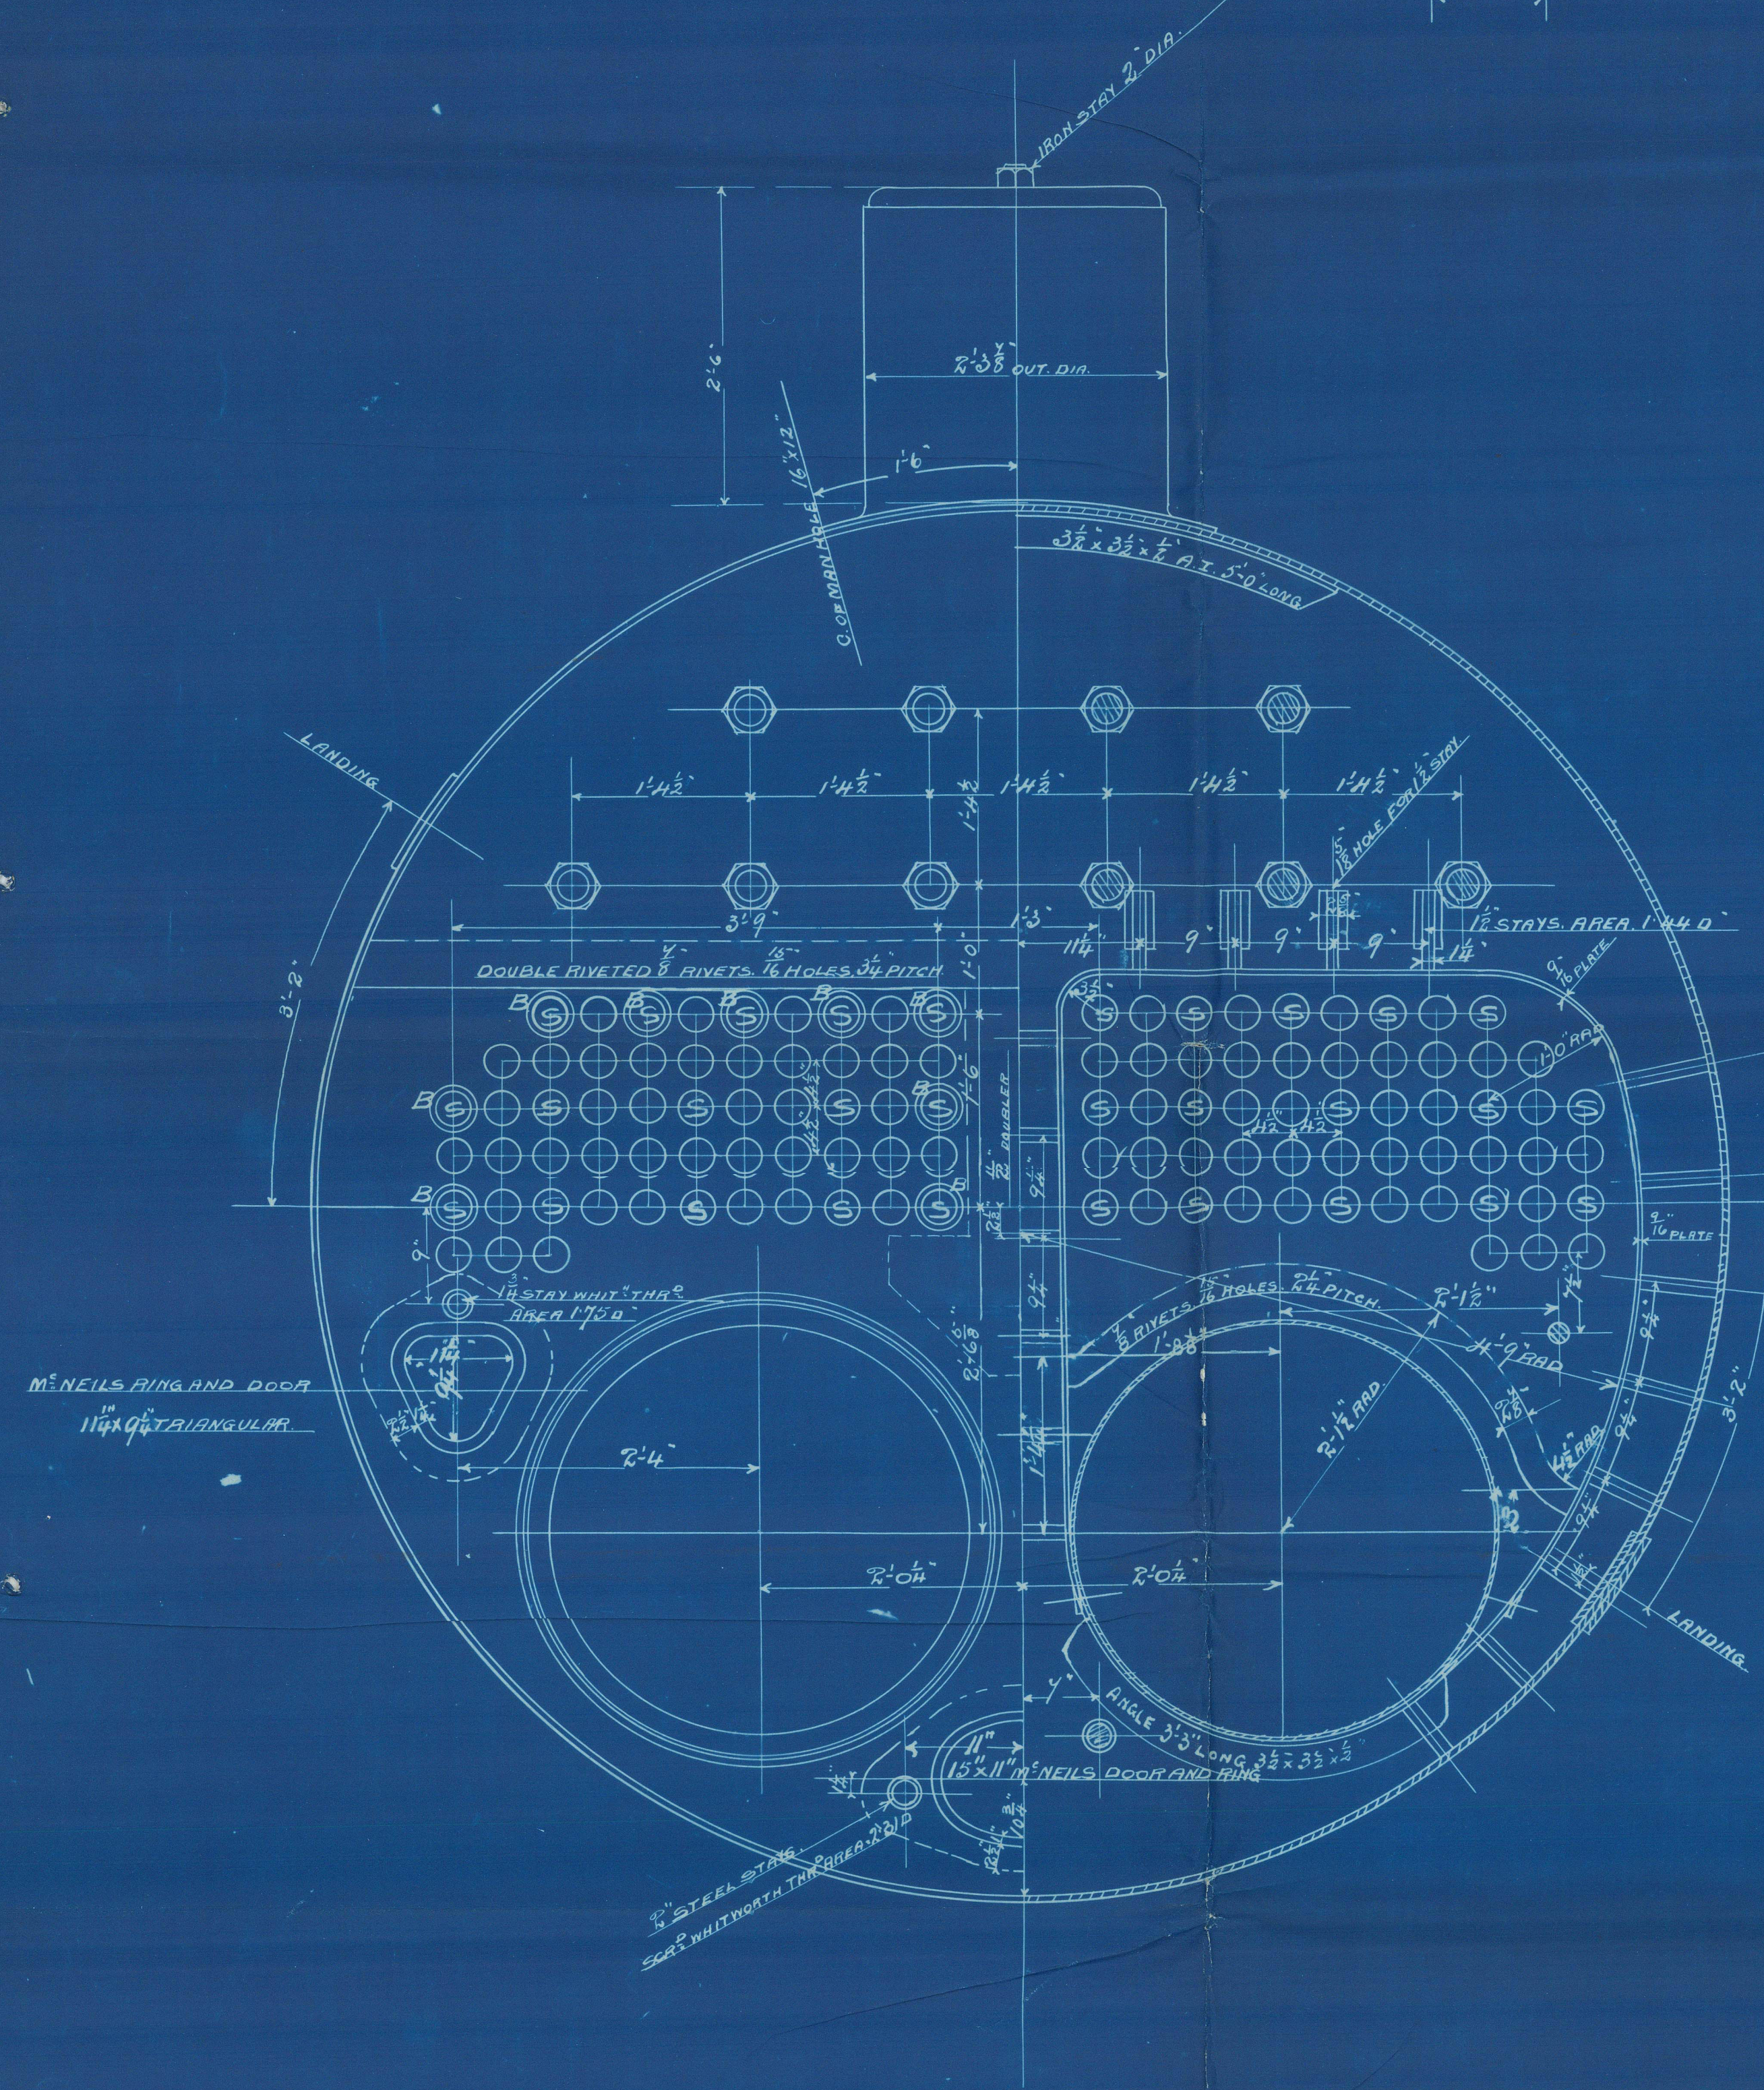

AMENDED DESIGN.  
MOORE PARK BOILER WORKS  
LINDSAY BURNET & CO  
HELEN STREET, COVAN, GLASGOW

MARINE BOILER 10'-10" INS. DIA. X 9'-0" MEAN LENGTH X 120 LBS. W.P.  
UNDER BOARD OF TRADE AND LLOYDS SURVEYS.

SCALE ONE IN = 1 FOOT

BLR. No 75 S