

1887. Jan 1st  
 400 400  
 200 200  
 100 100

STERN POSTS, RUDDER, & STRUTS

SCALE  $\frac{1}{2}'' = 1 \text{ FOOT}$



98  
12-11-97



Fairfield & Co

No 404

Sp. Omrah

Sl. Rpt. No. 16687

2. No 404

RUDDER & STERN

LE 1/2" = 1 FOOT




© 2021

Lloyd's Register  
Foundation



A

Fairfield Bls  
Ln. 404

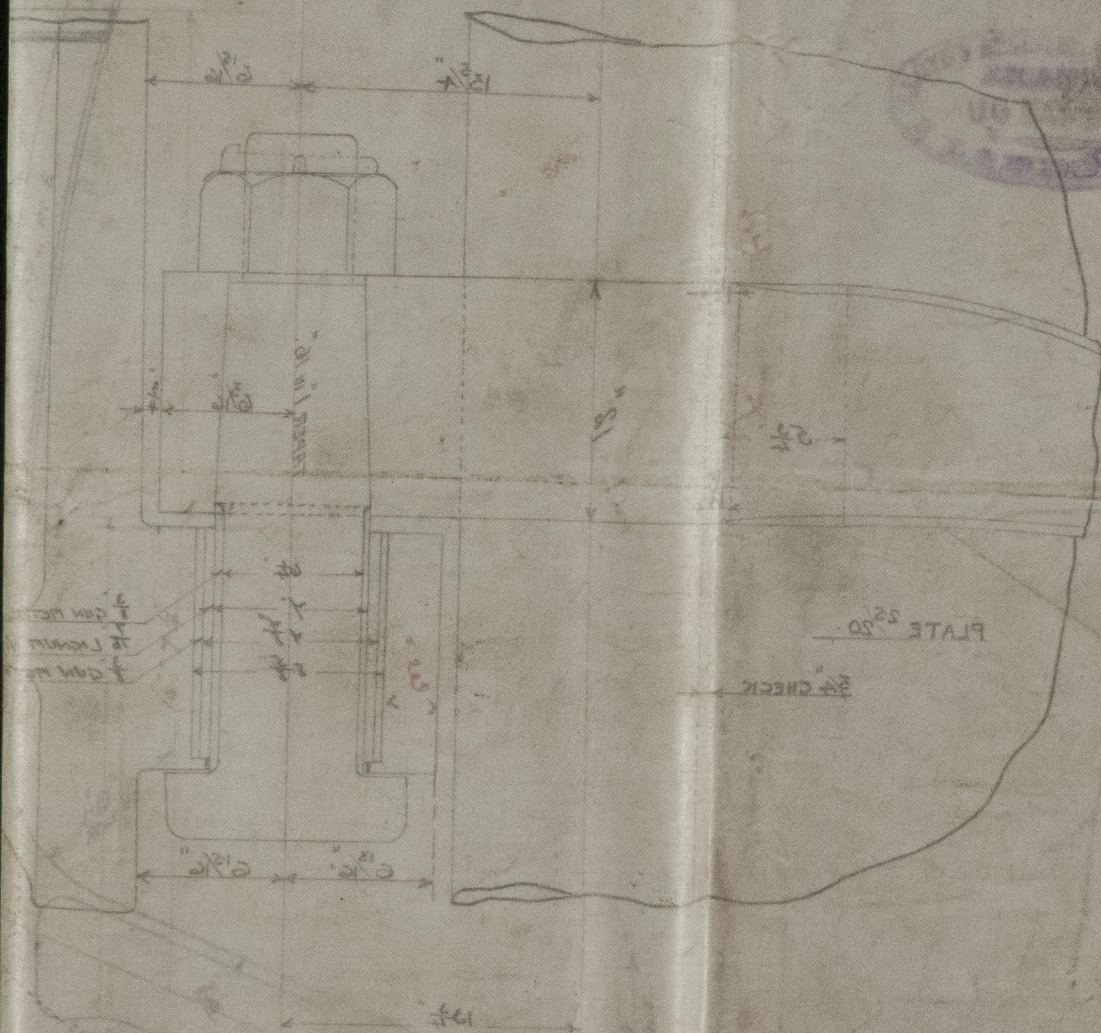

© 2021

Lloyd's Register  
Foundation

GLS273-0041