

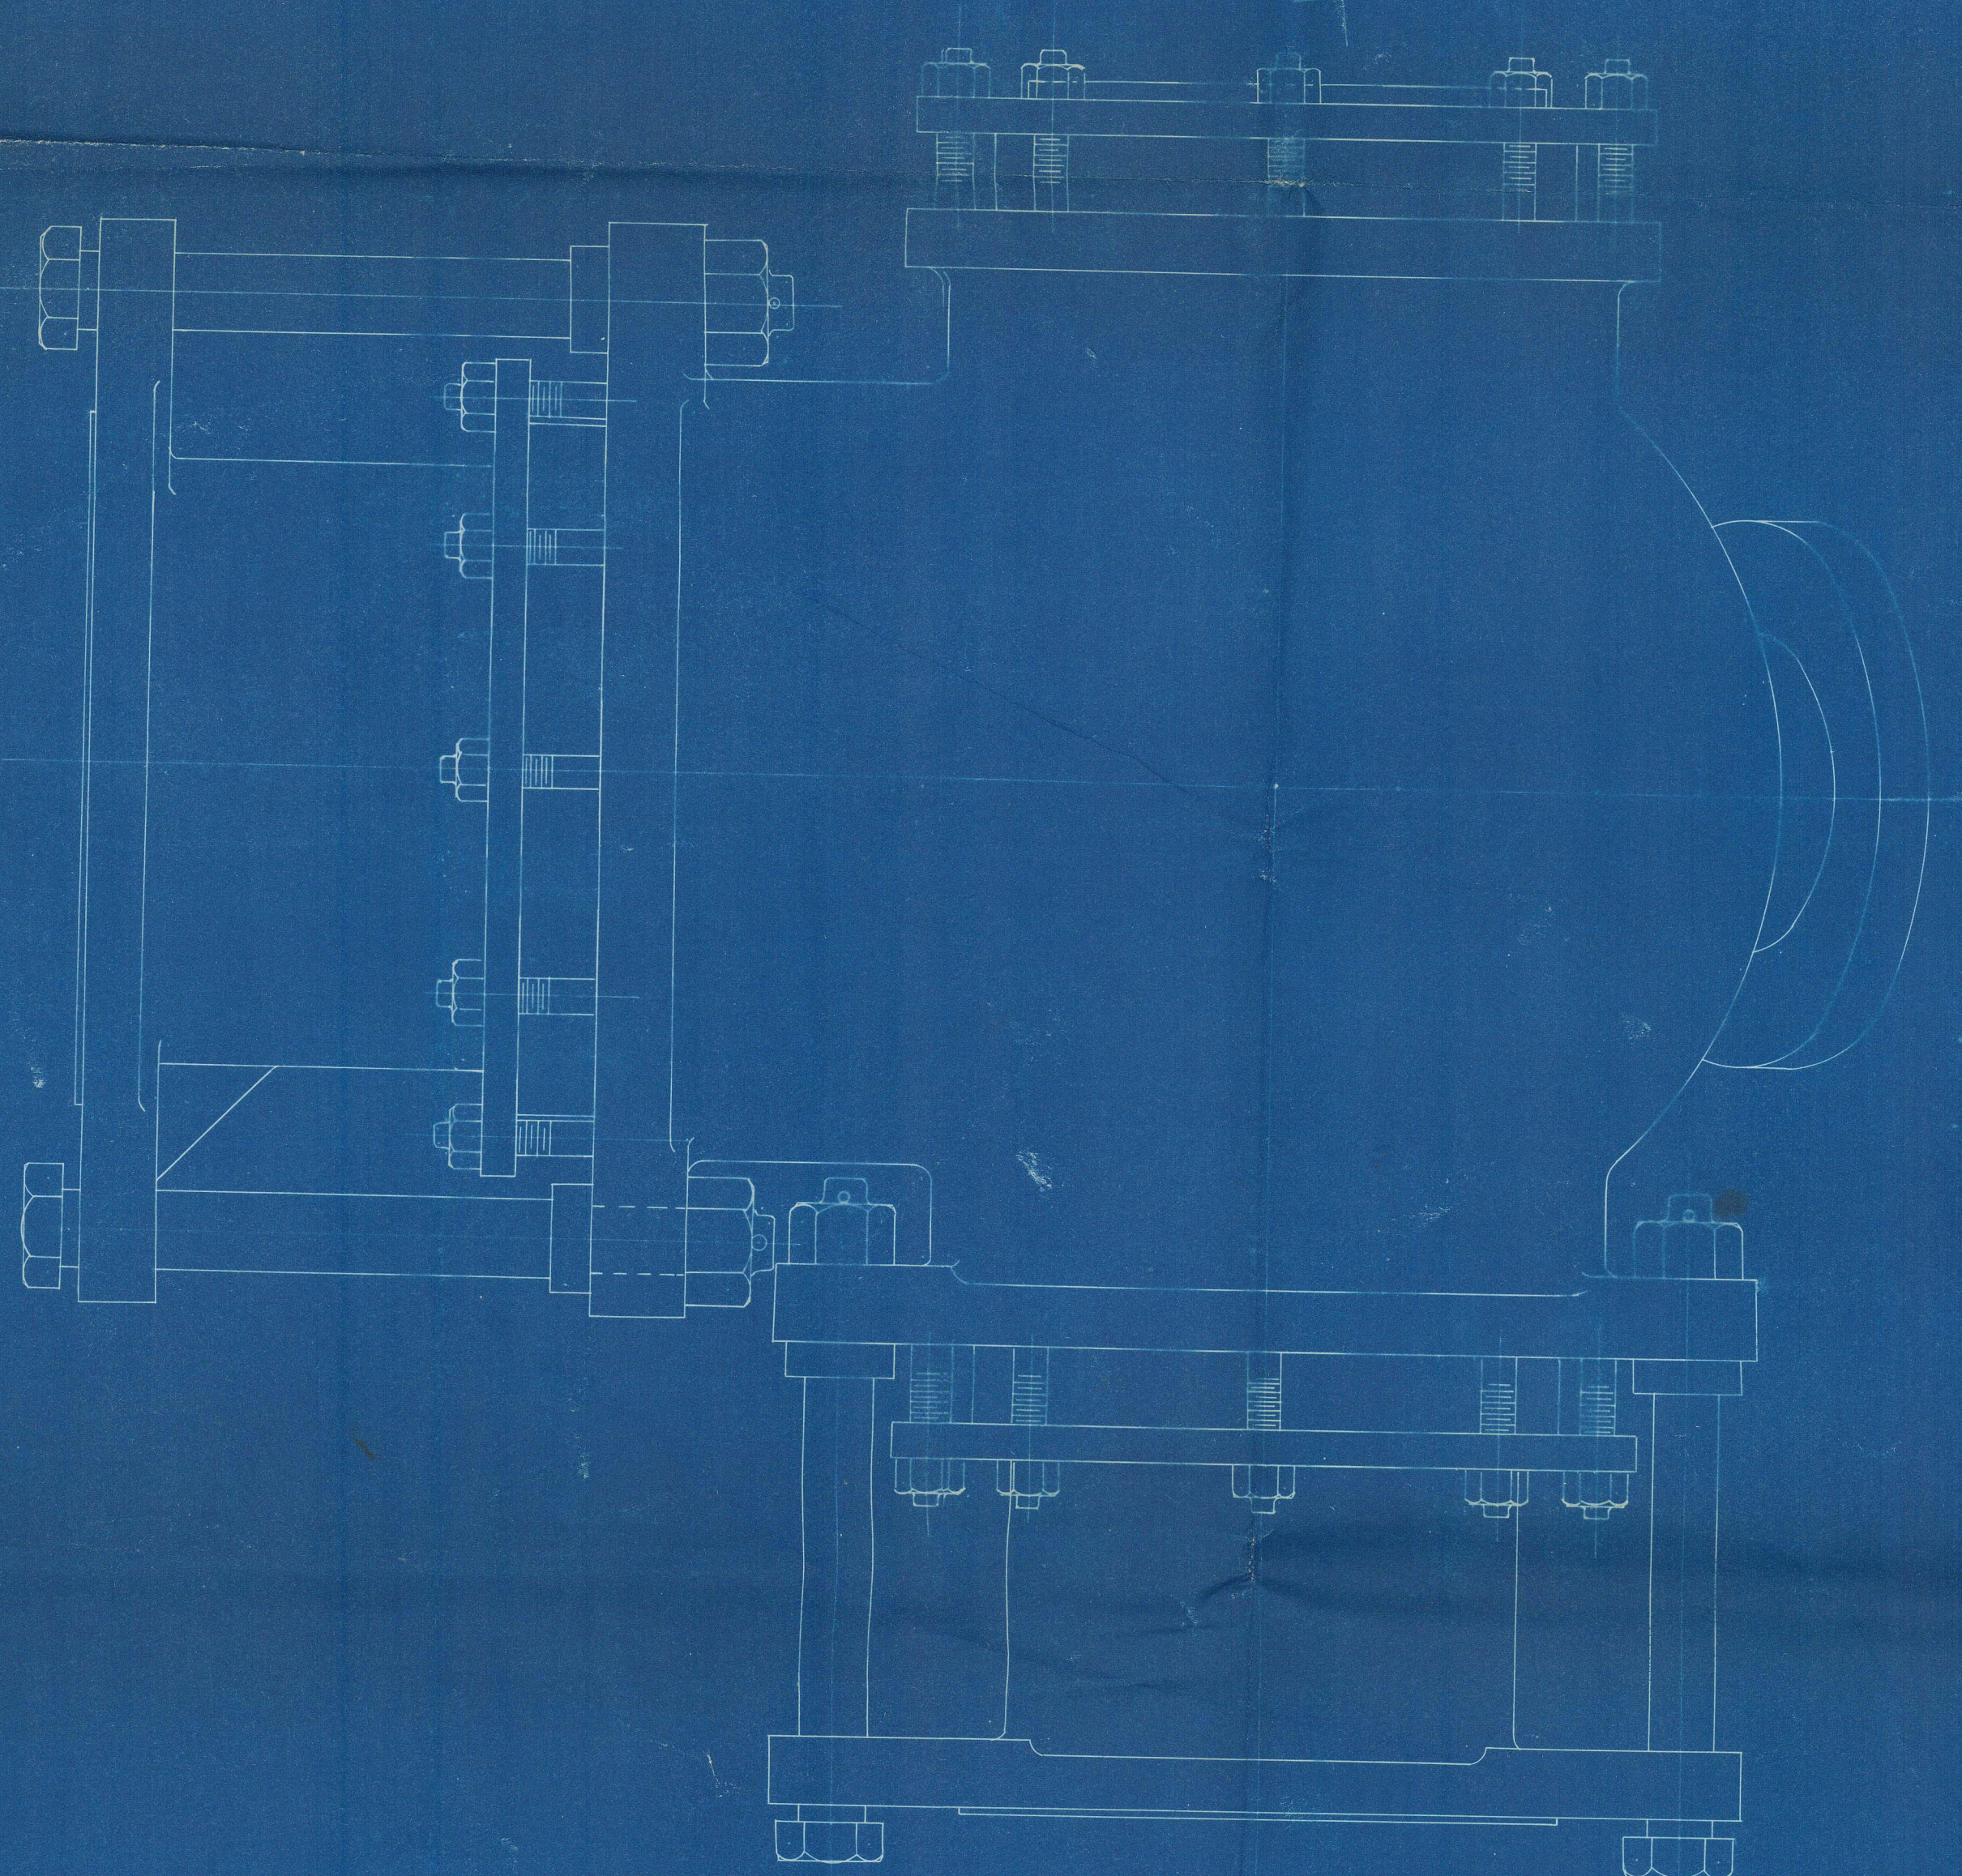
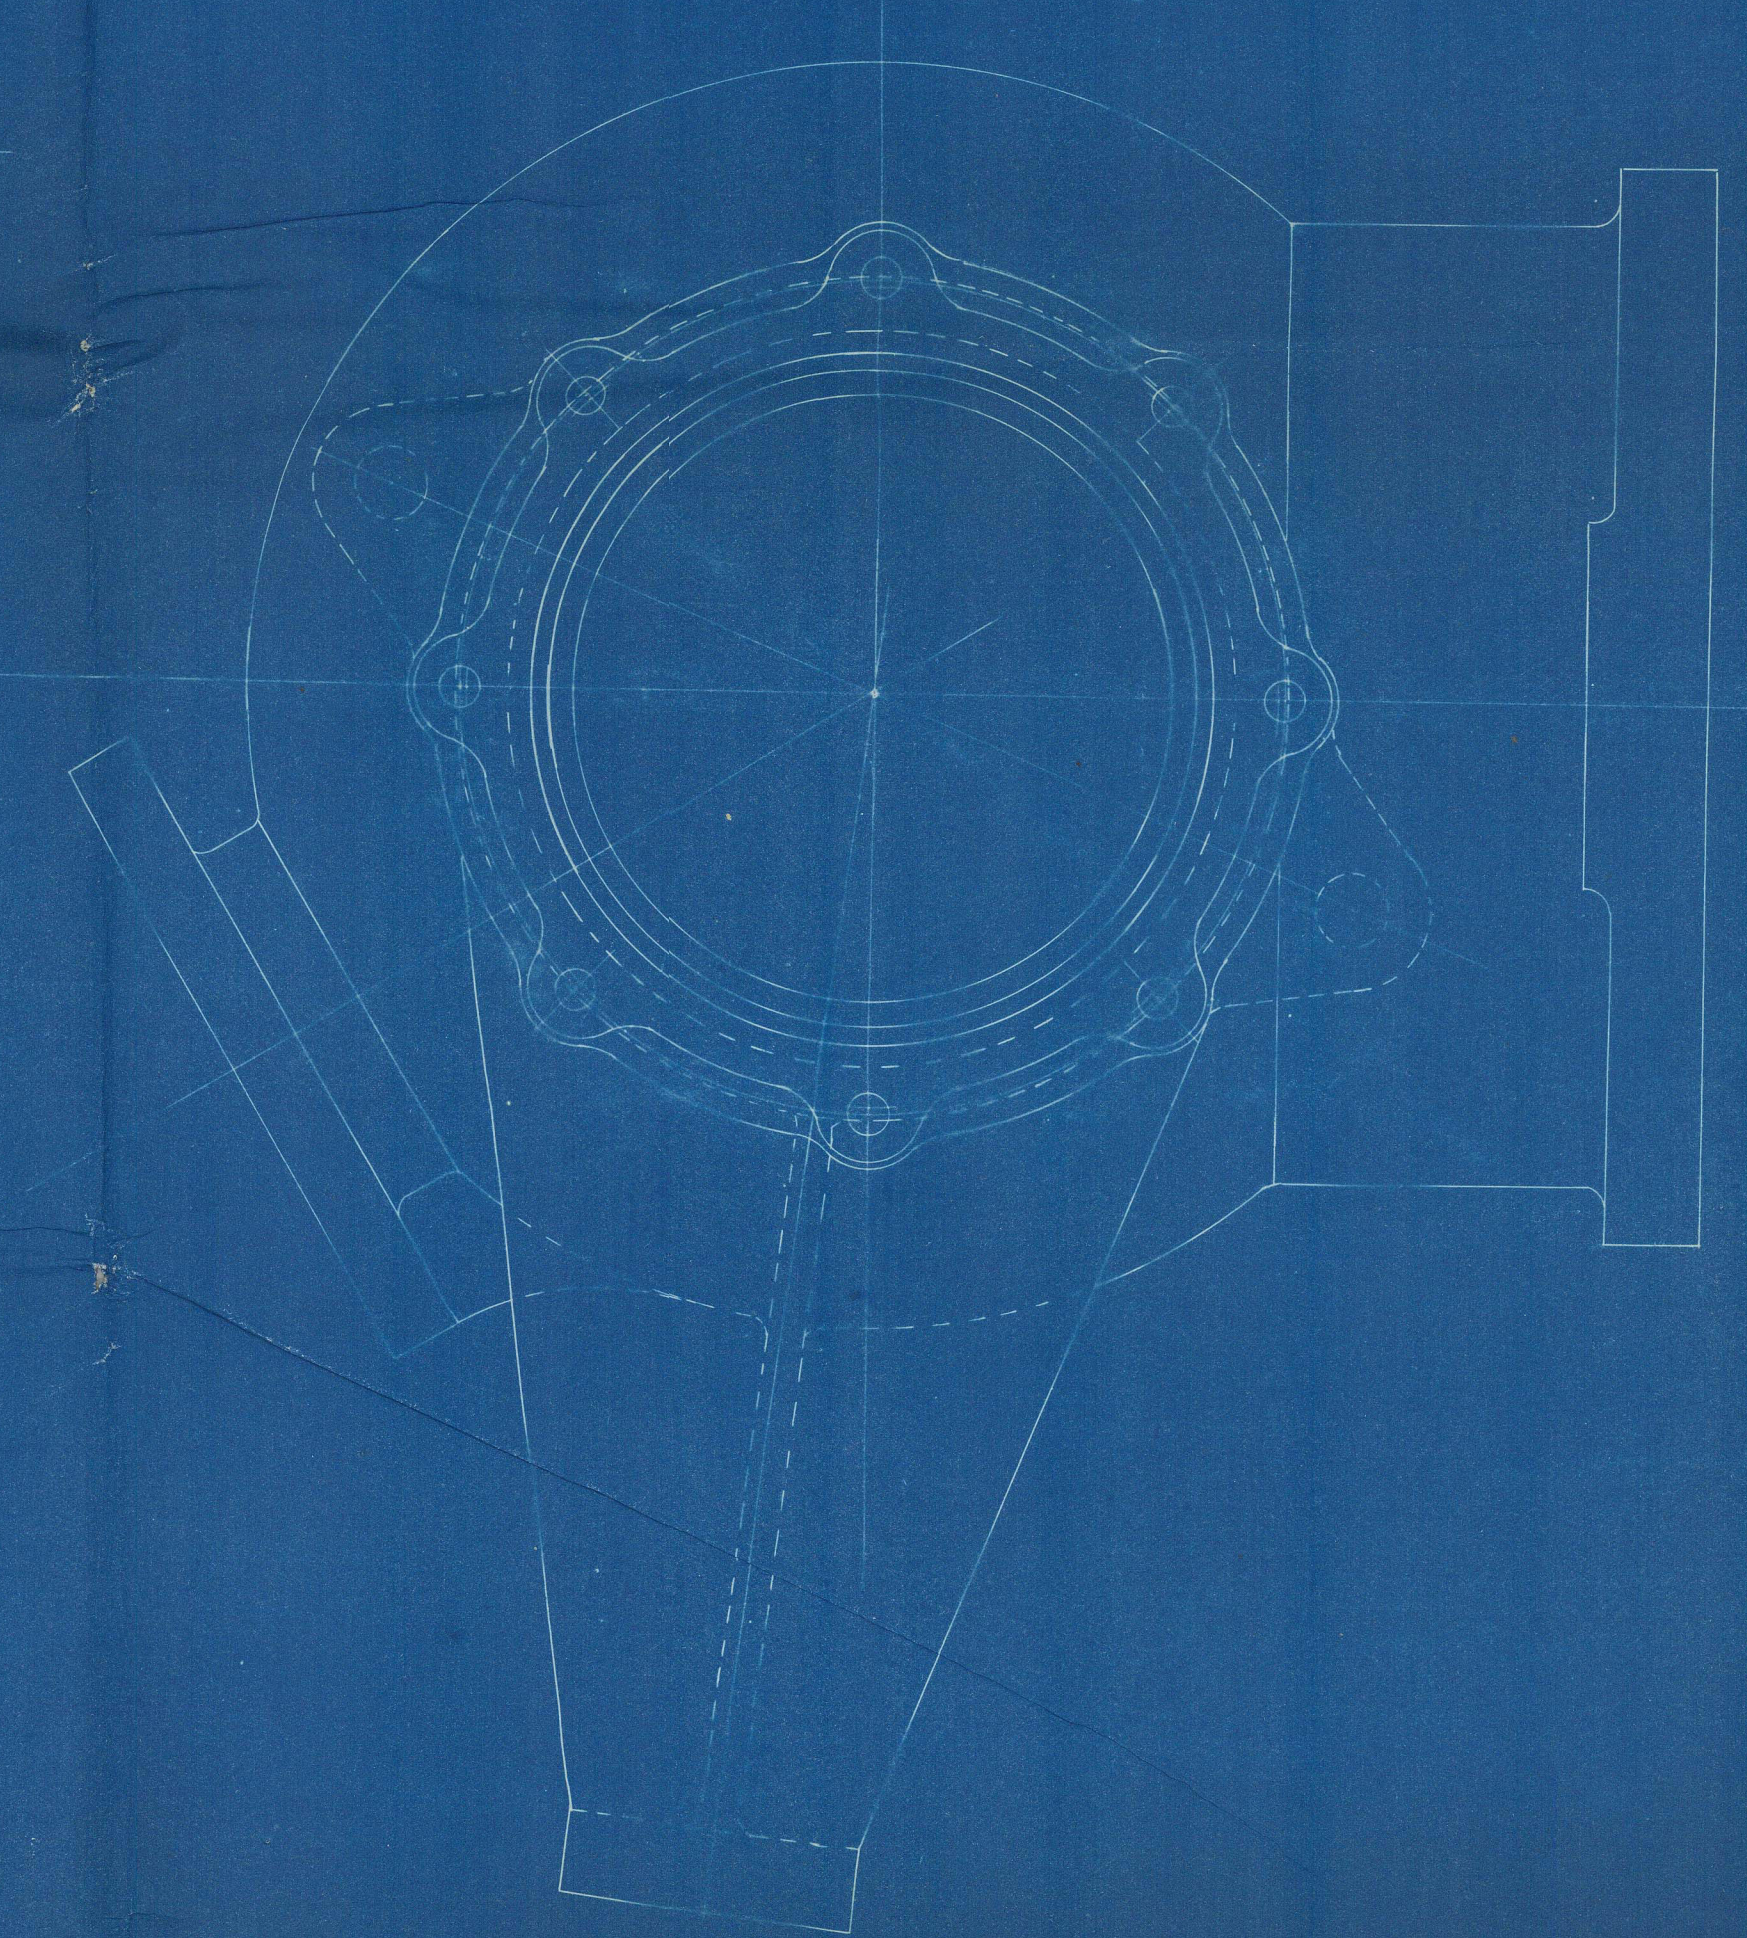
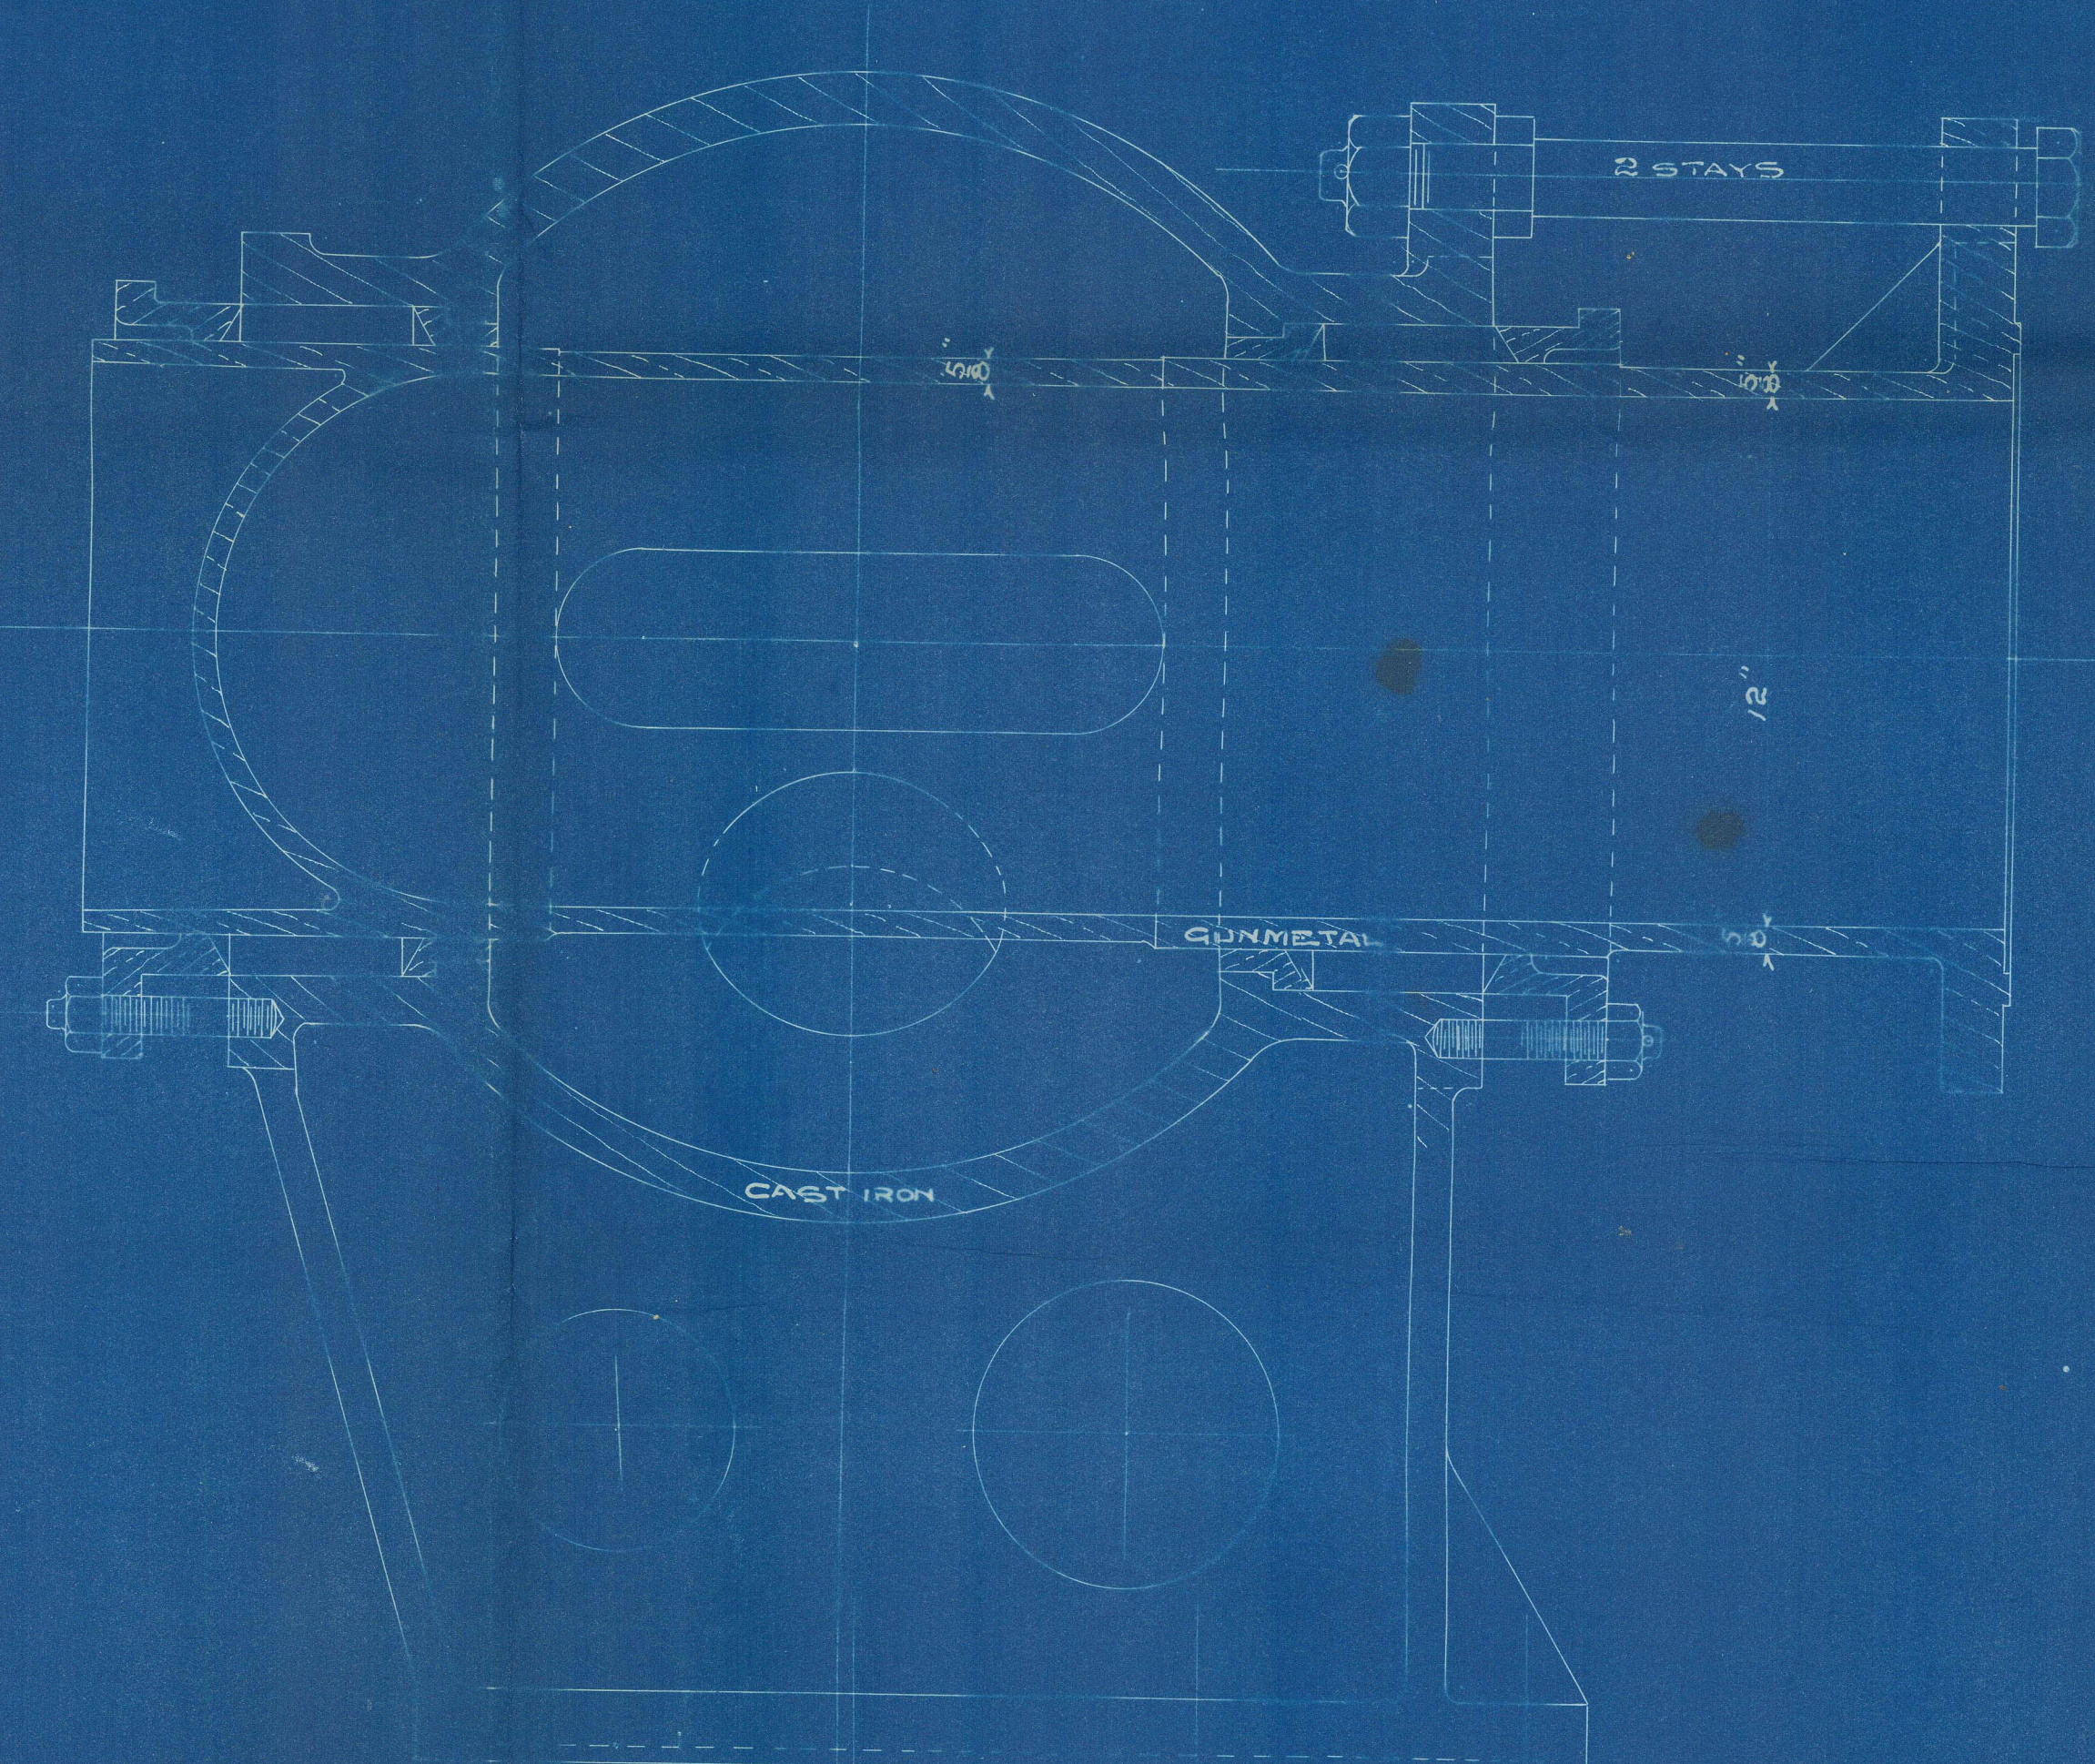



11/29/08
11/29/08
11/29/08

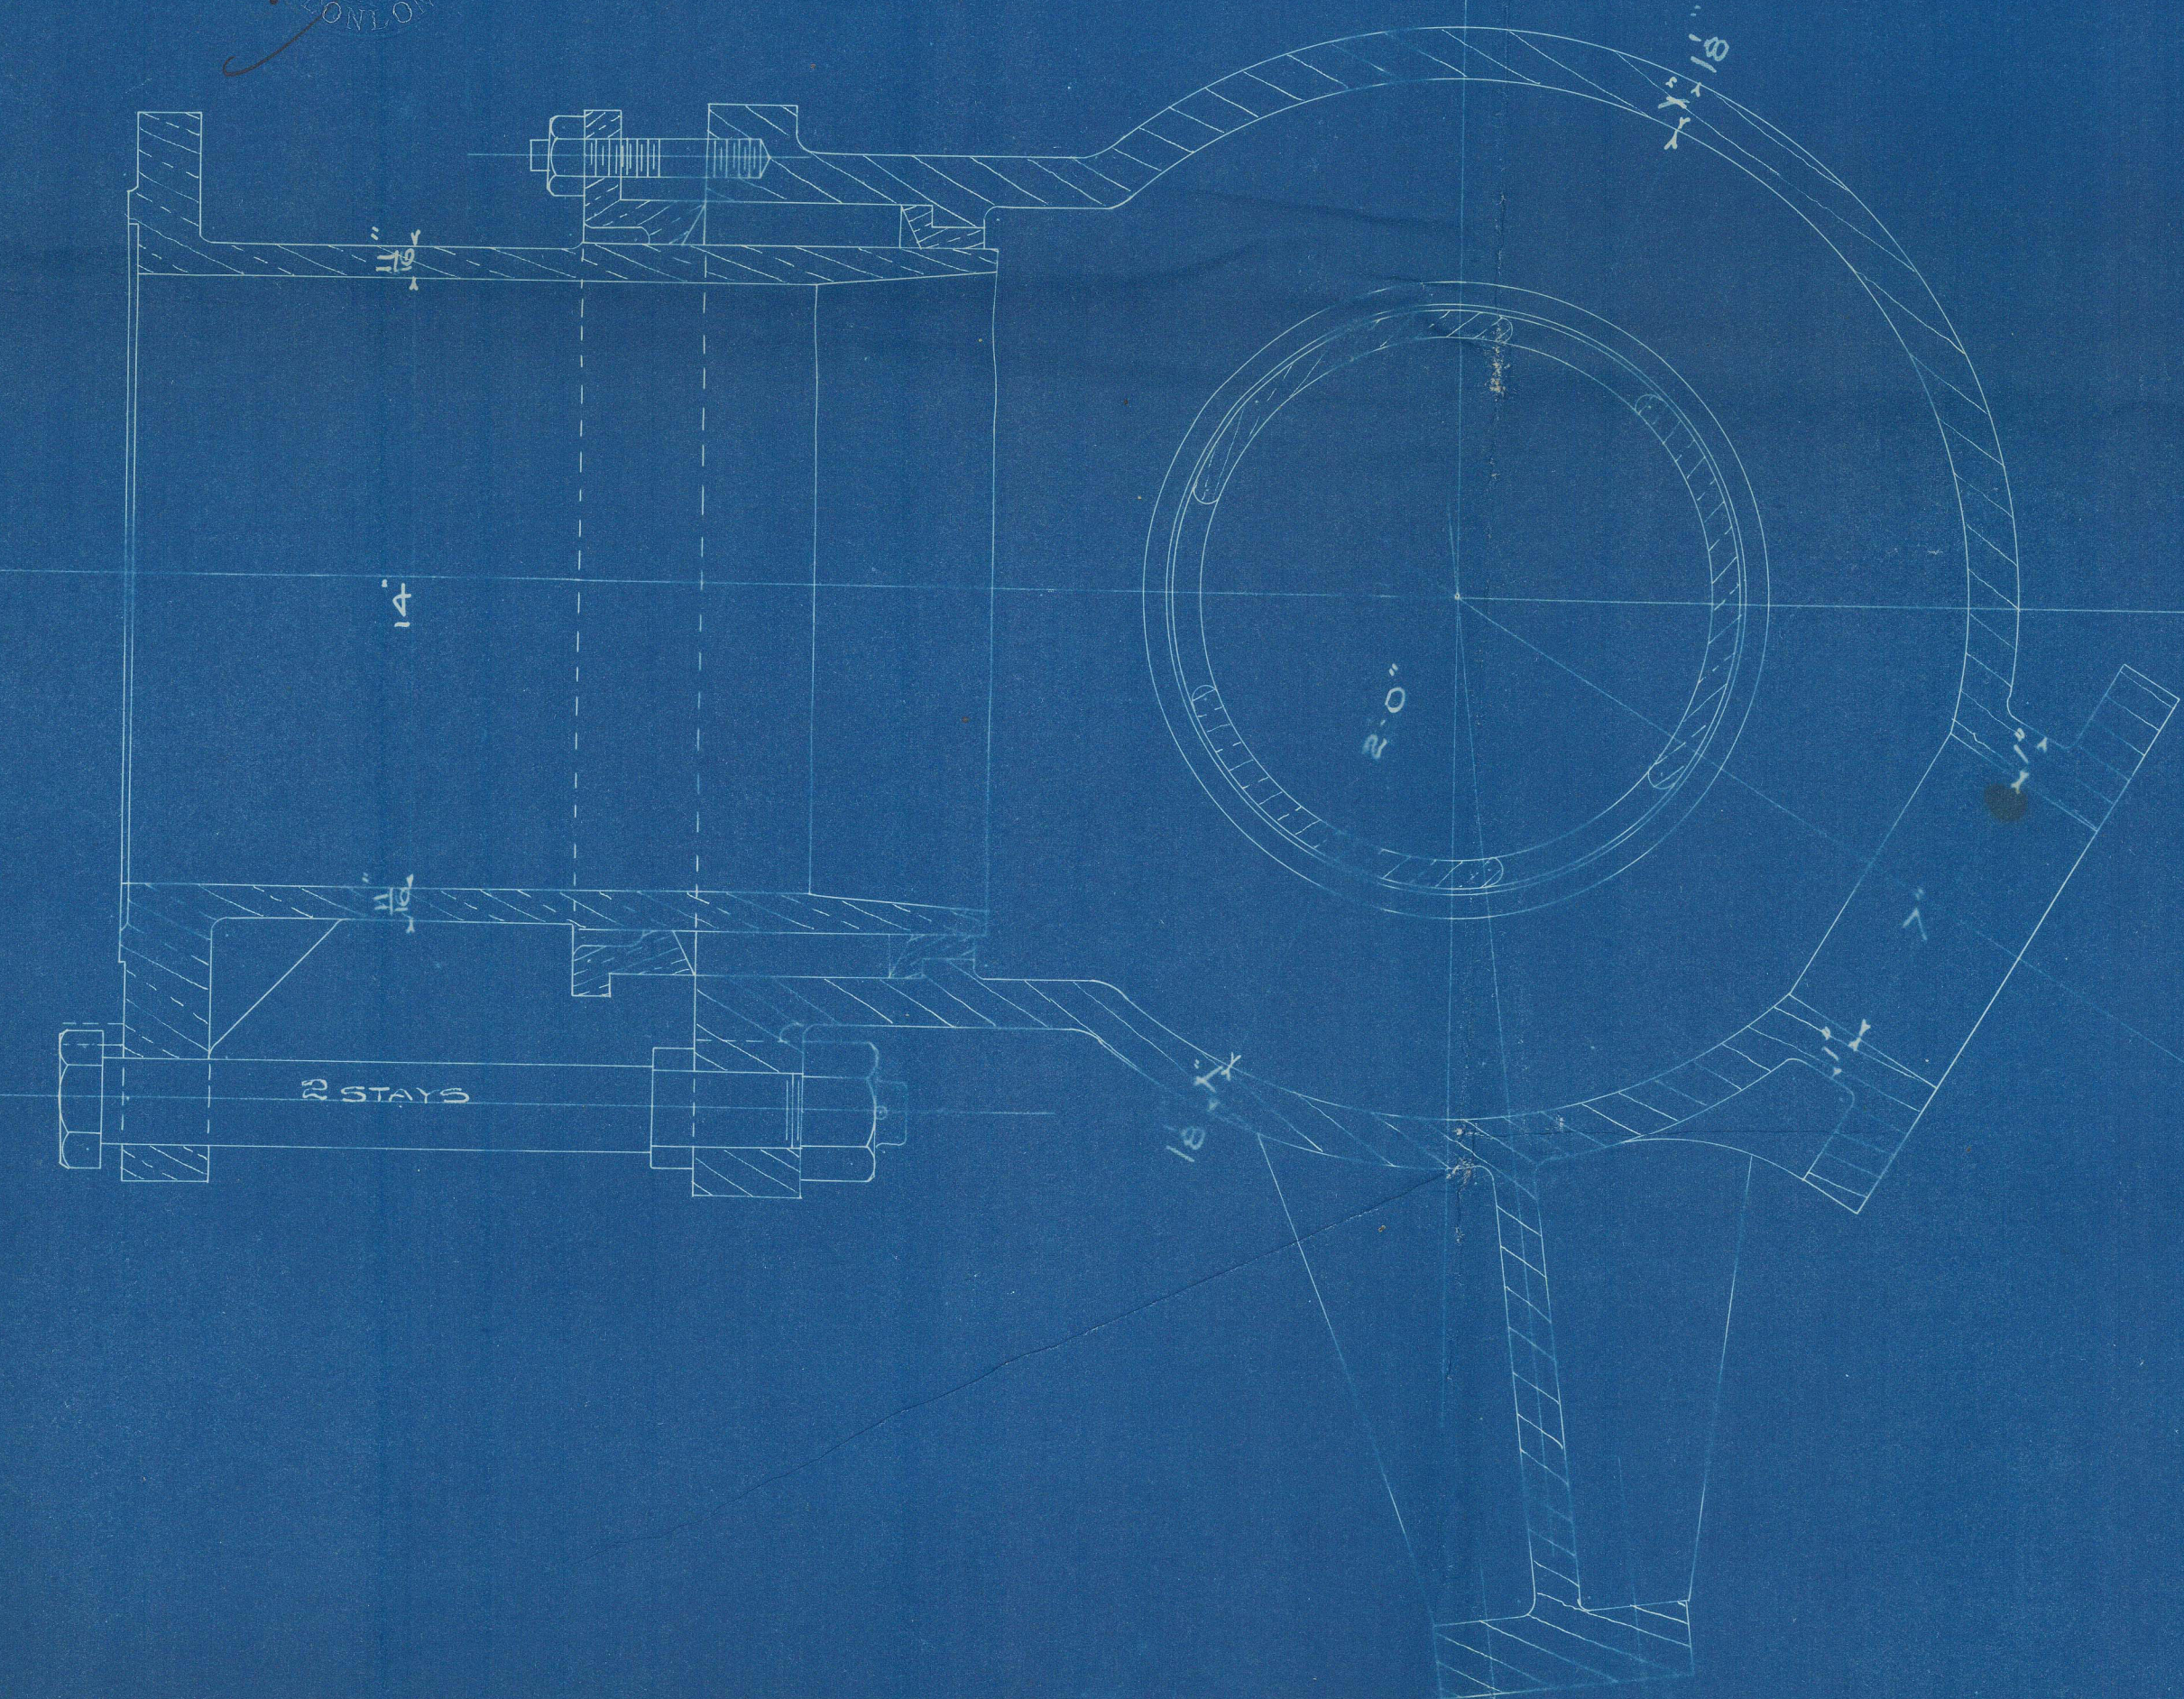

OFF "D"

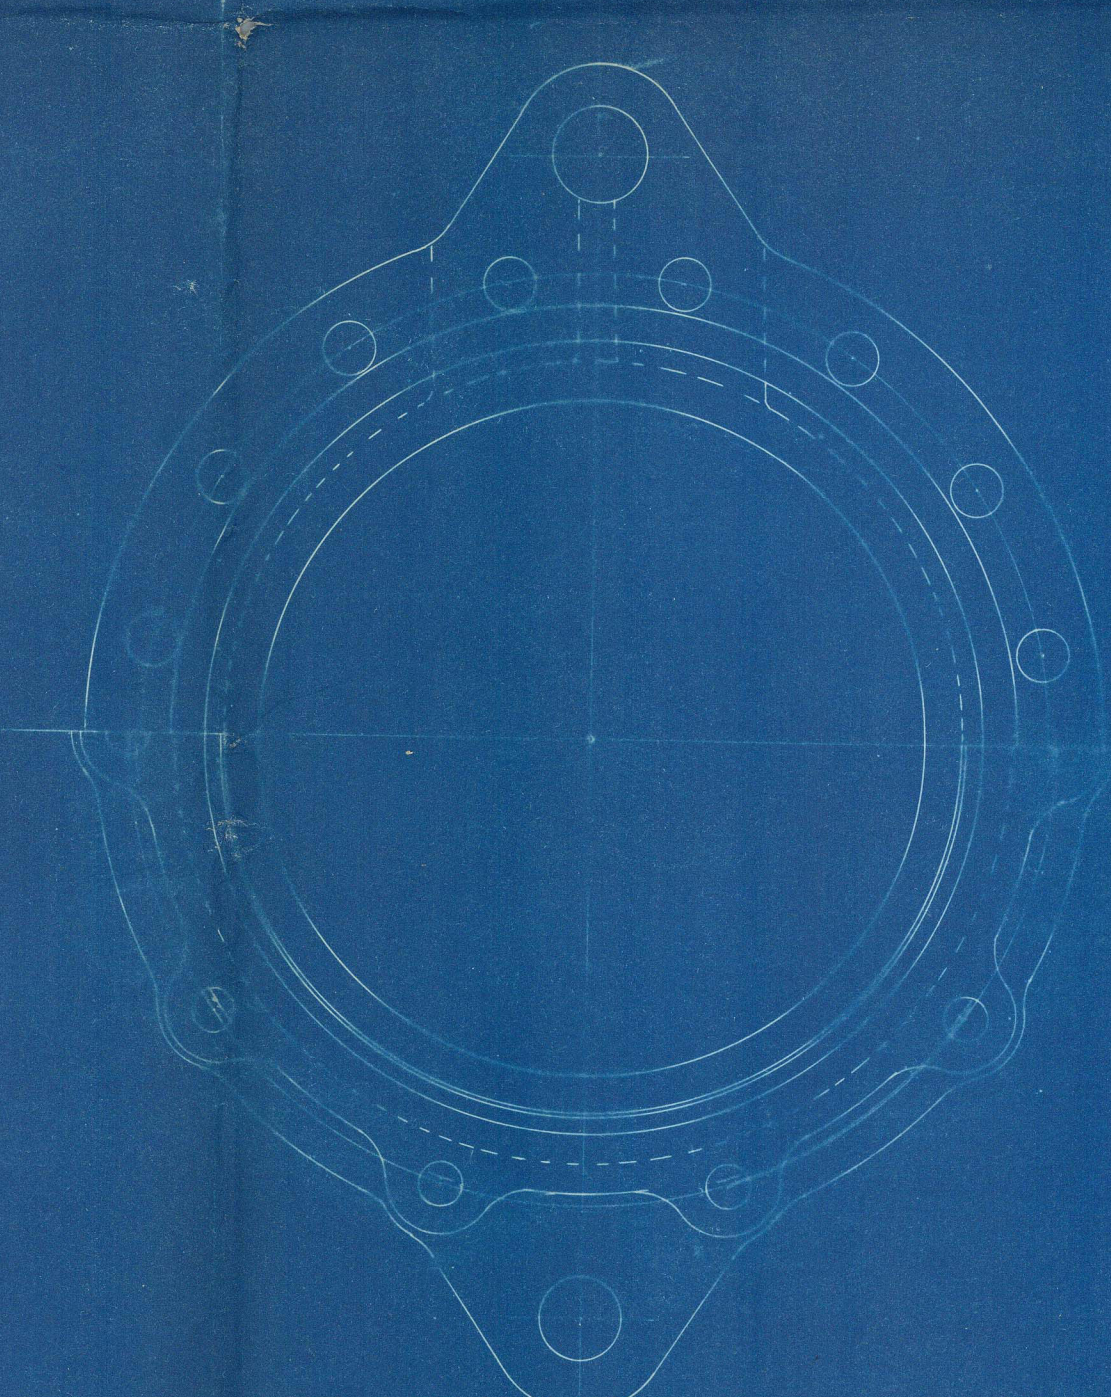

TEST PRESSURE 540 LBS PER SQ INCH

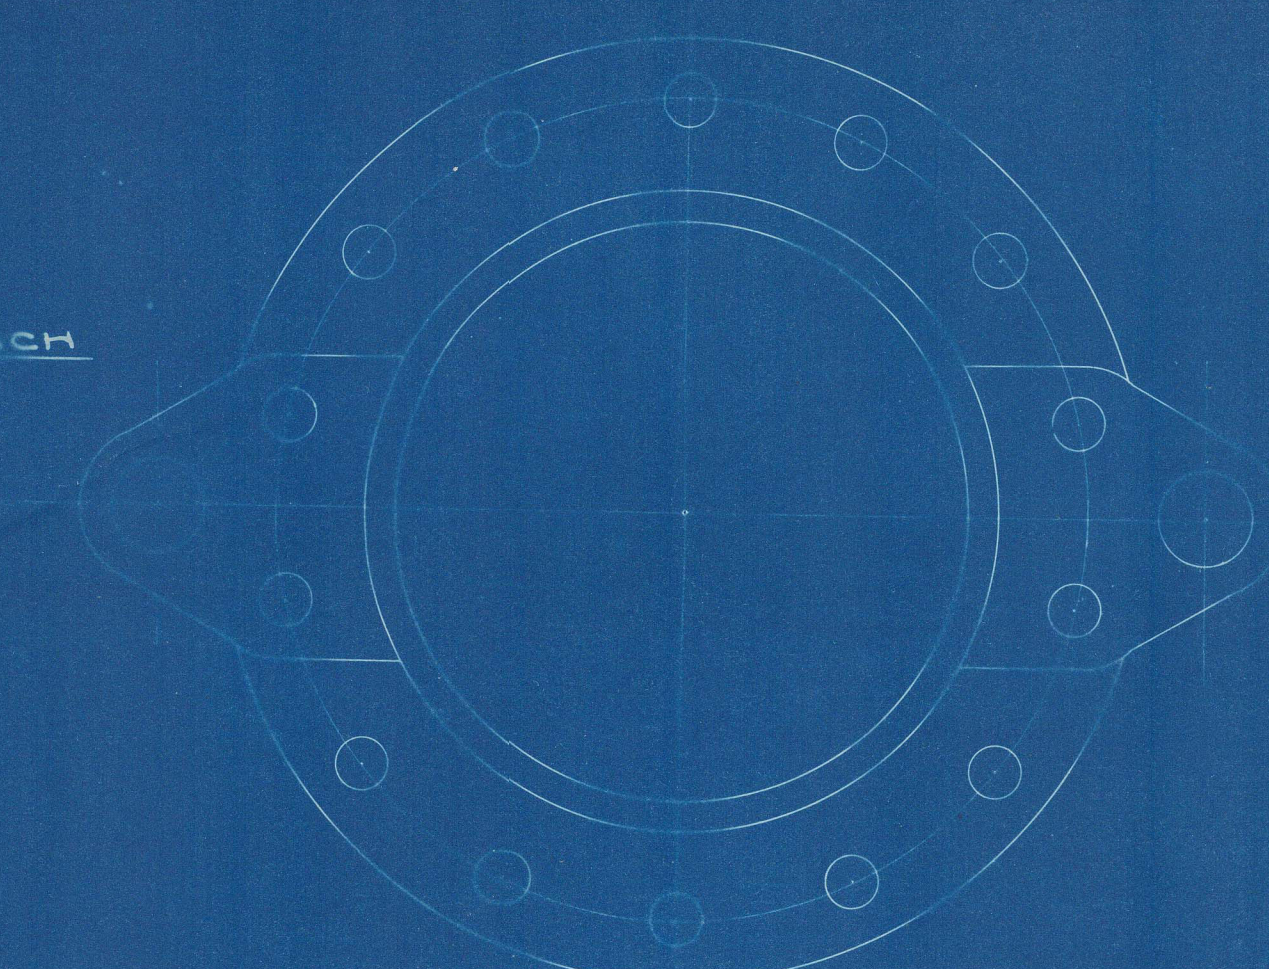

THE PATENT
BUILDING & ENGINEERING
LIMITED
ENGINE DEPARTMENT
- 3 AUG. 1908
GLASGOW, GLASGOW

Modified to meet S.P.D. requirements
23/10/08

— MAIN STEAM PIPES VALVES & TEE PIECES —
— ENGINE N°404 —
— SCALE 3/4" = 1 FOOT —
5 SHEETS SHEET 4

T1433
J.E.M.


Taipeia Ship to My 6th L.
H^o 404 vessel

Plan of stop values etc

D

S. S. Omrah

Is Apt. No. 16687

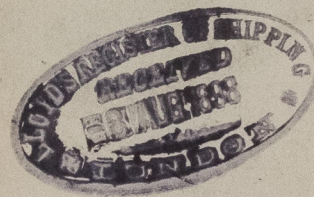

GLS273 - 0042



© 2021

Lloyd's Register
Foundation