
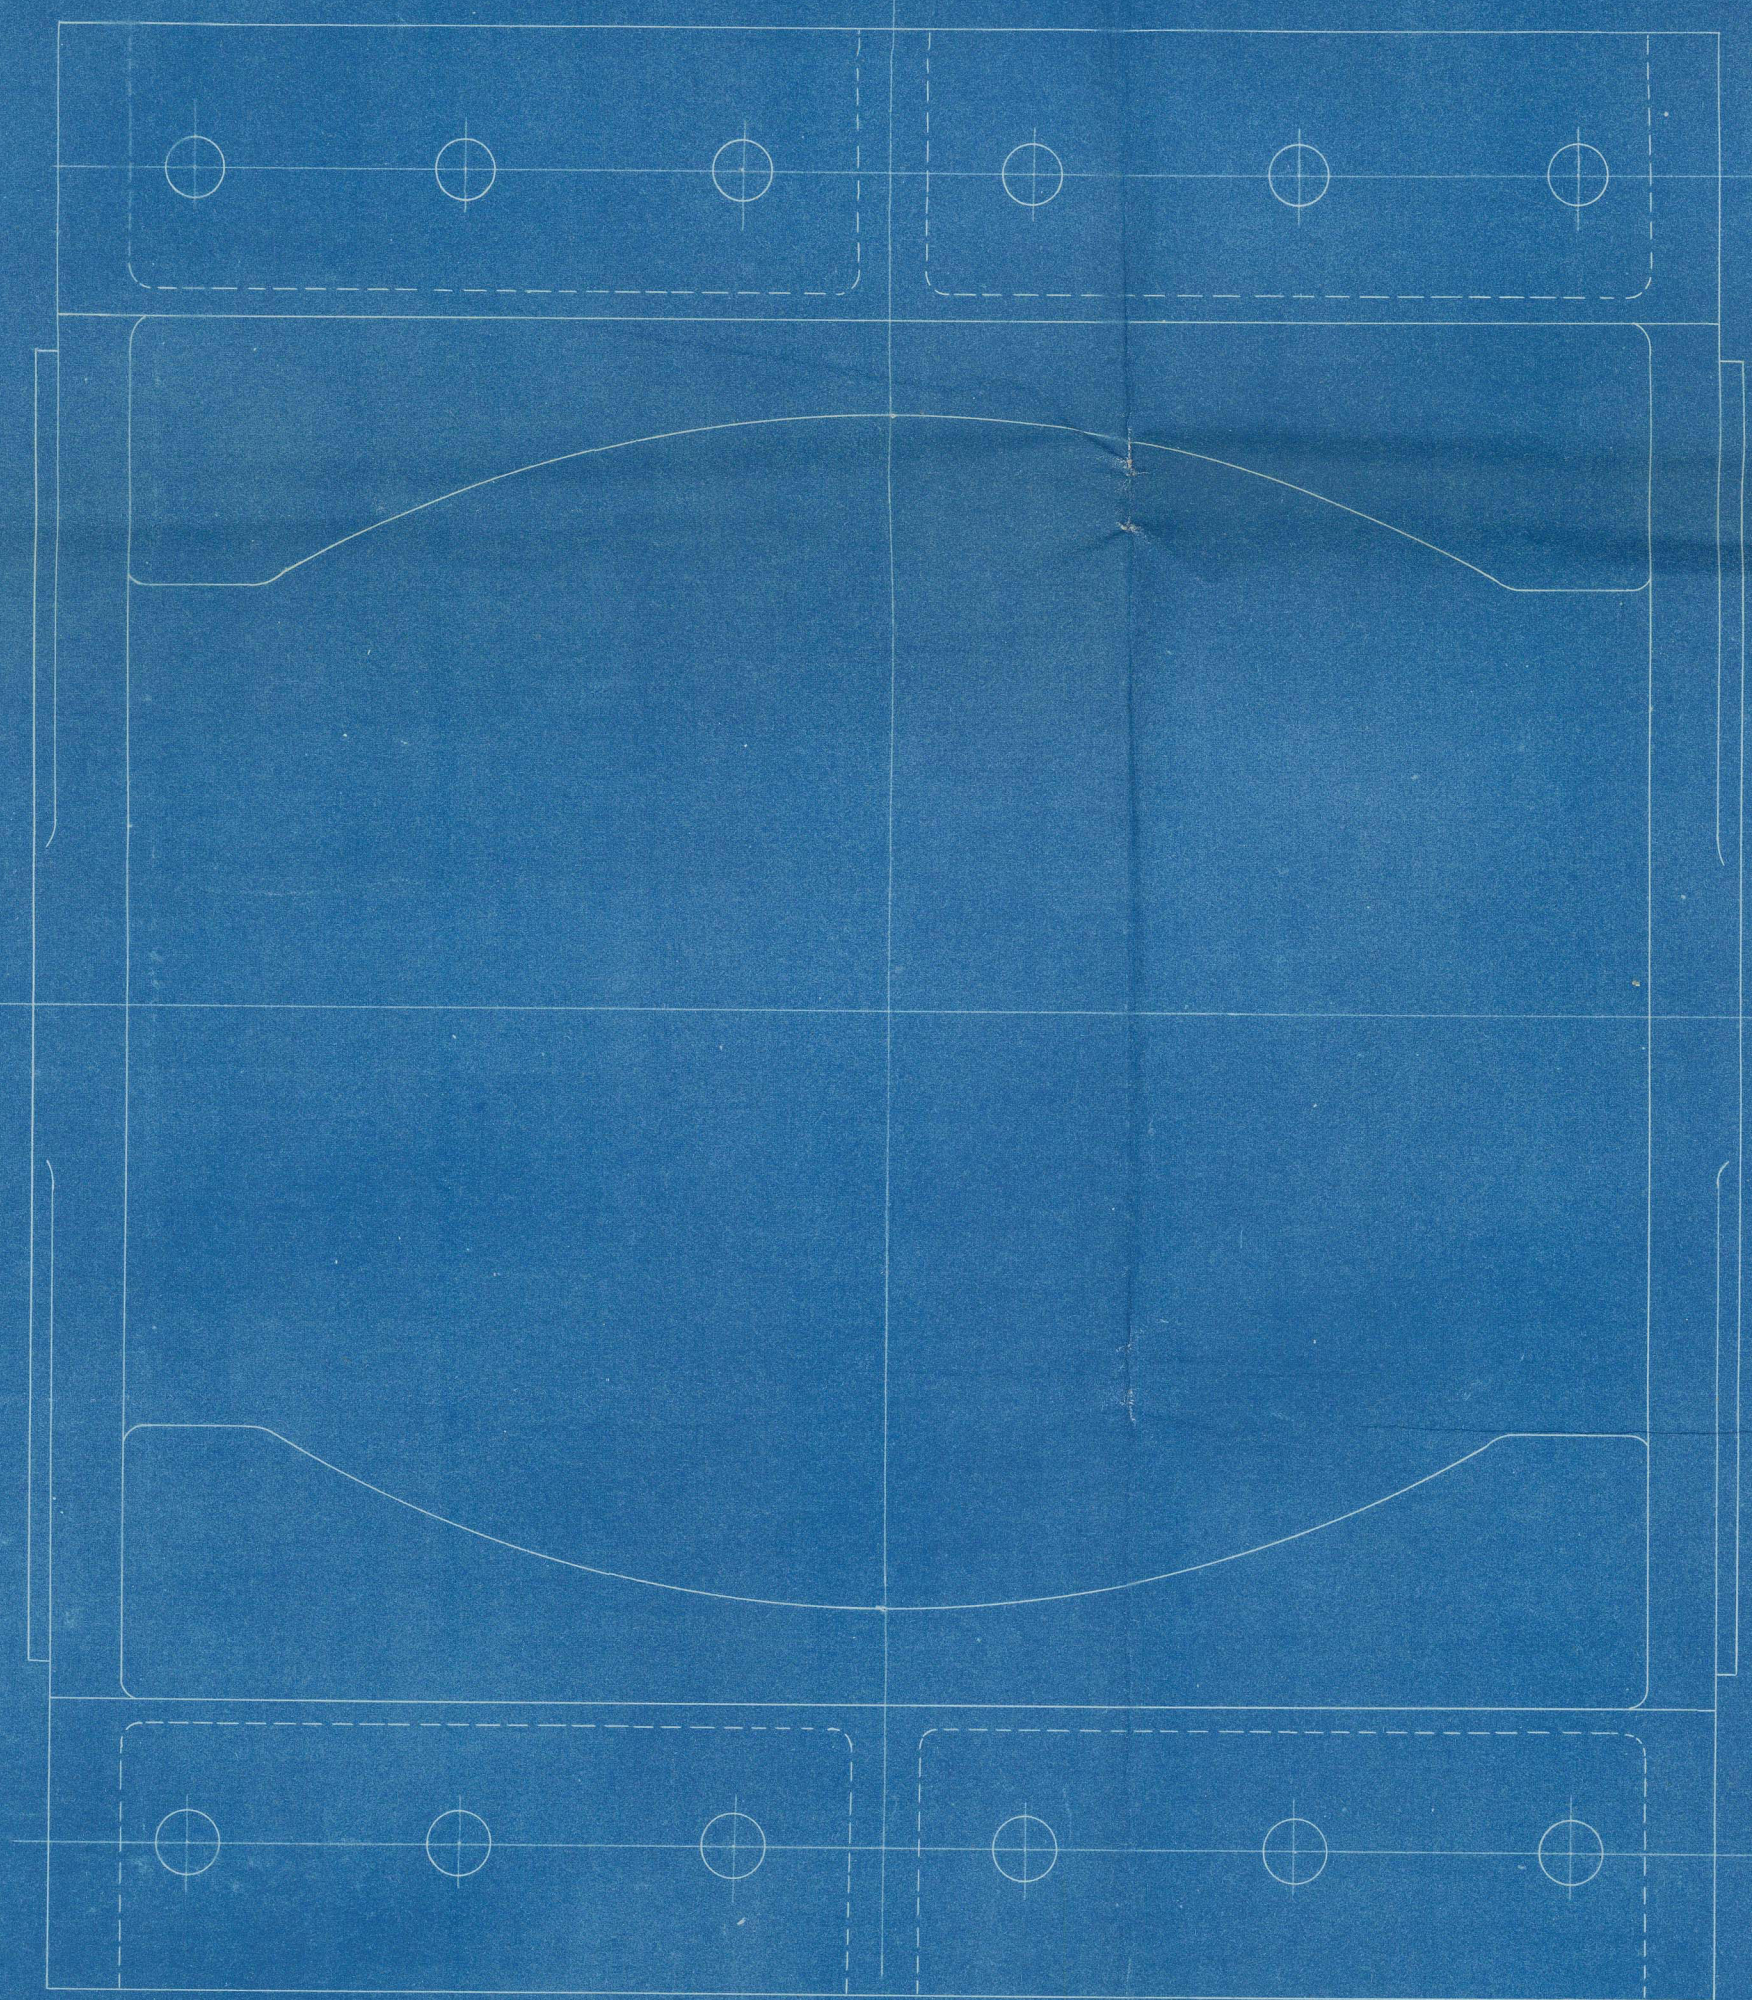
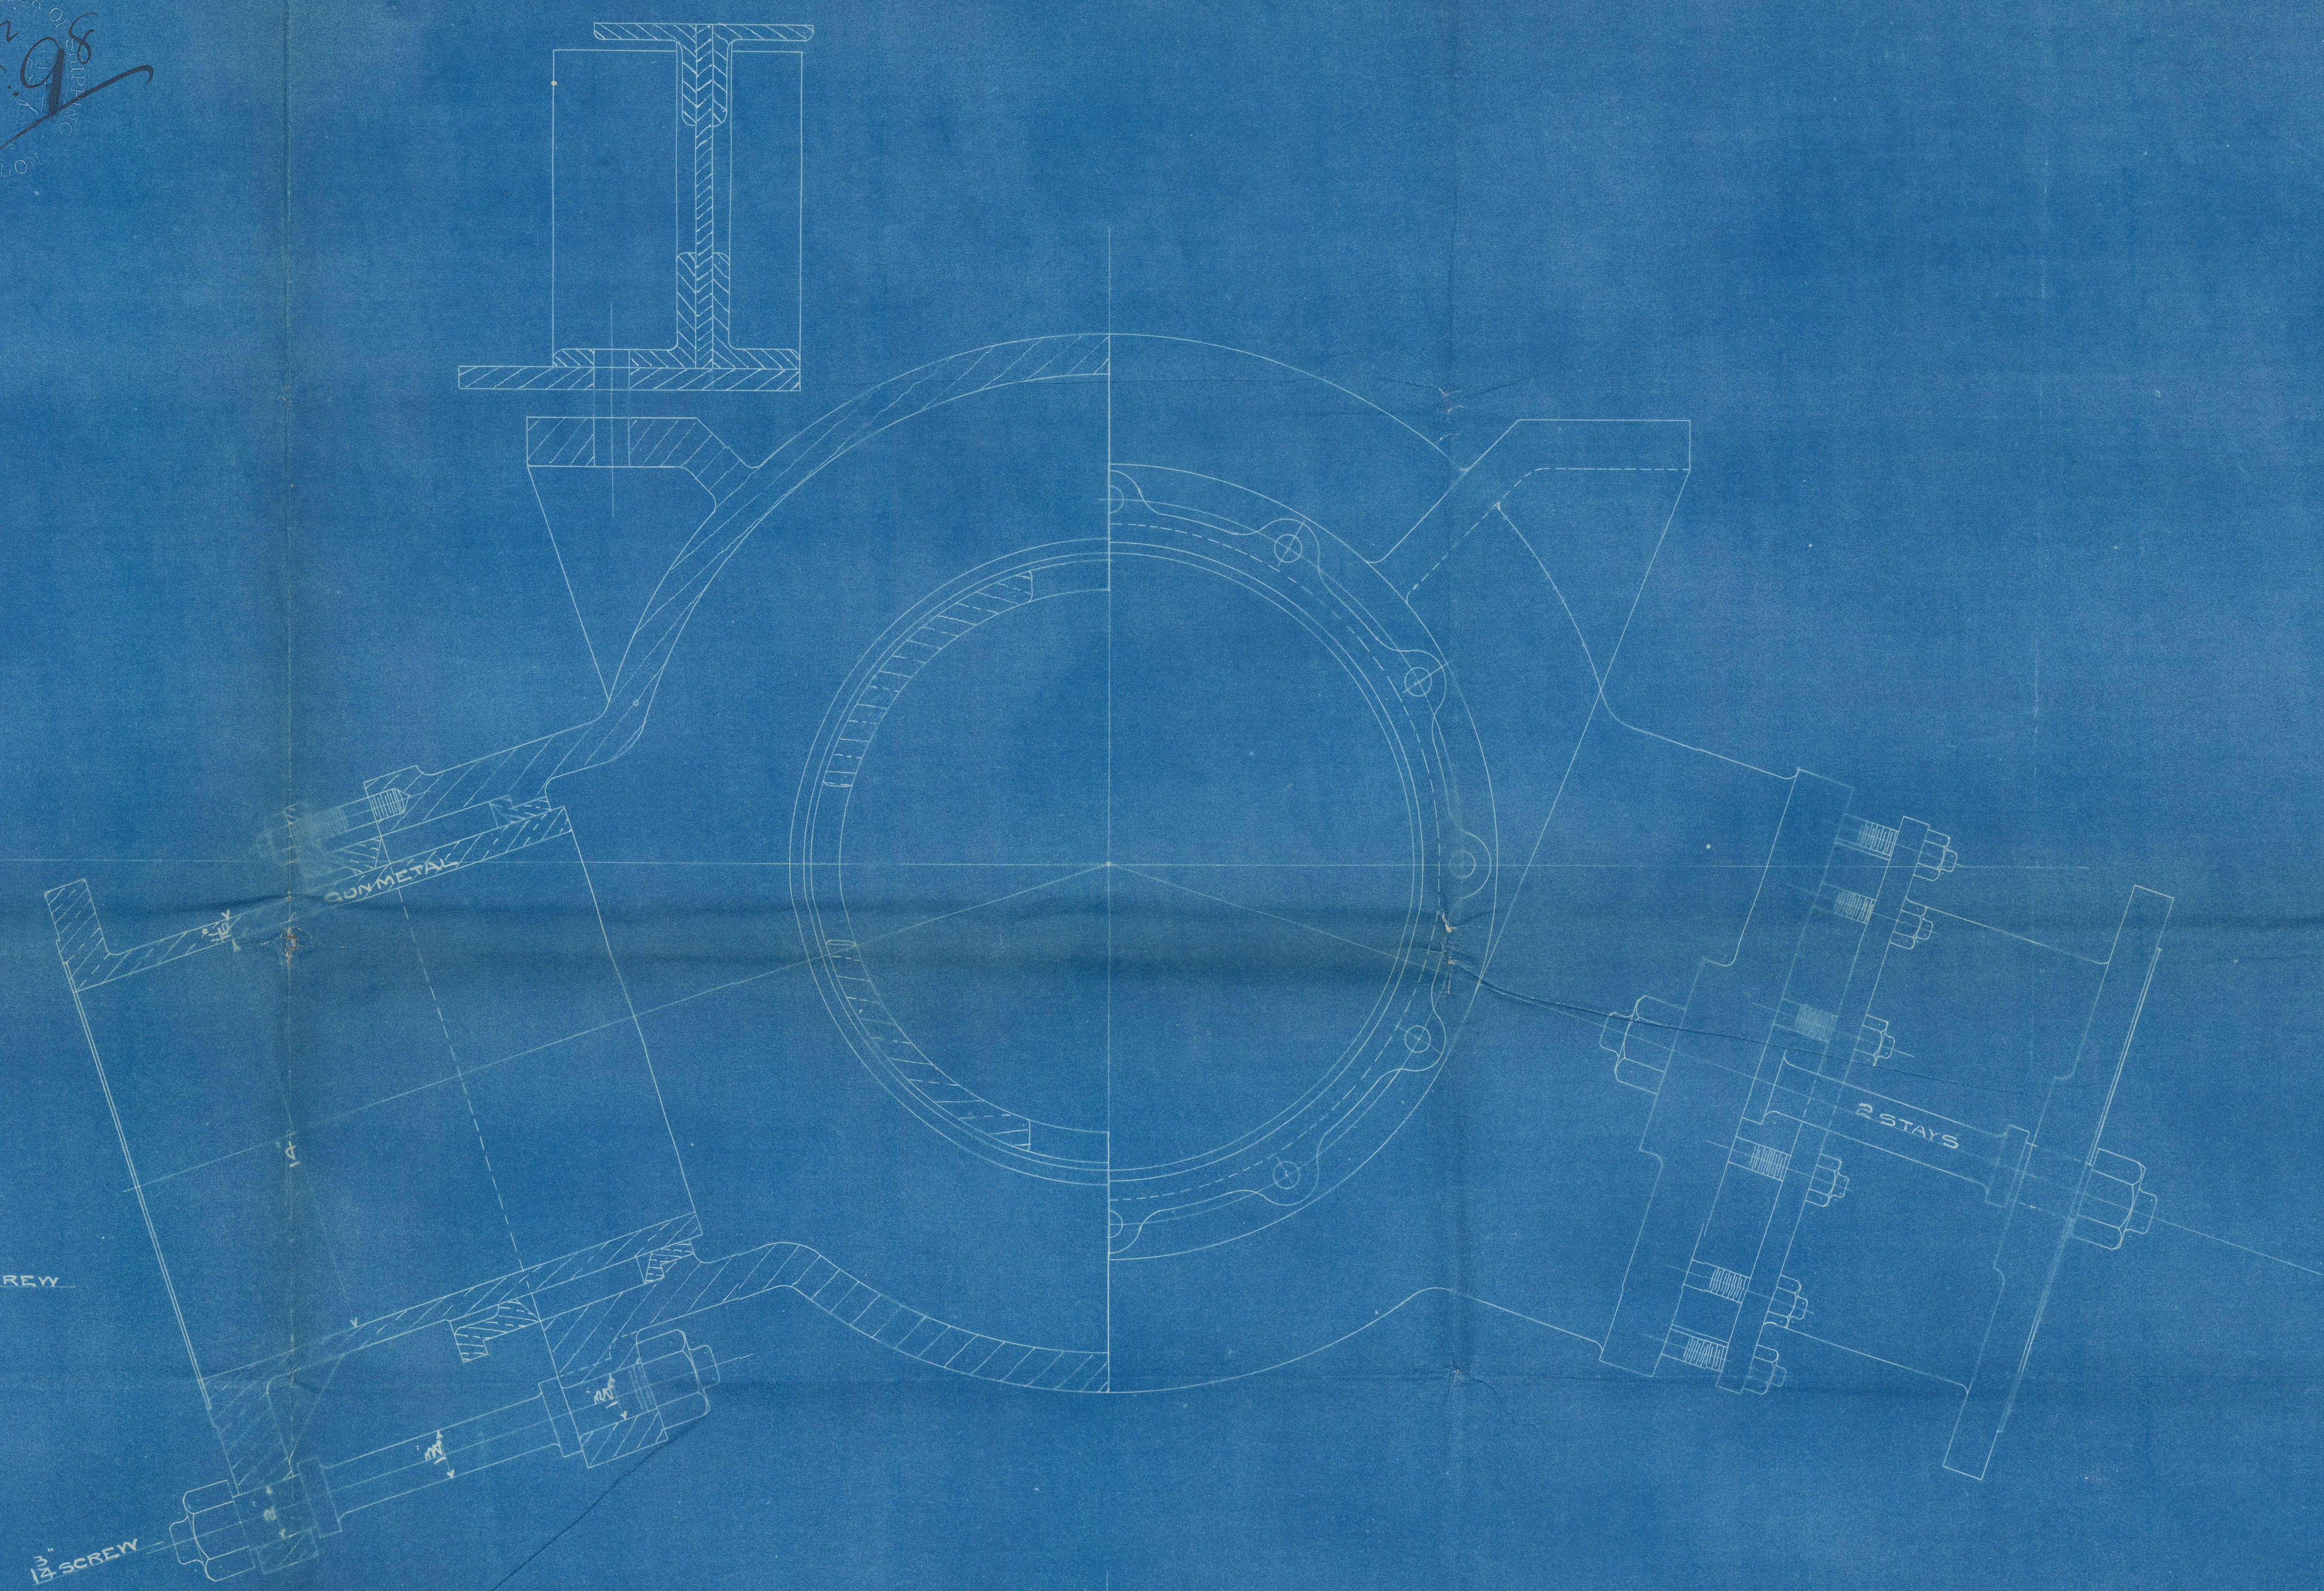



11.8.98
11.8.98

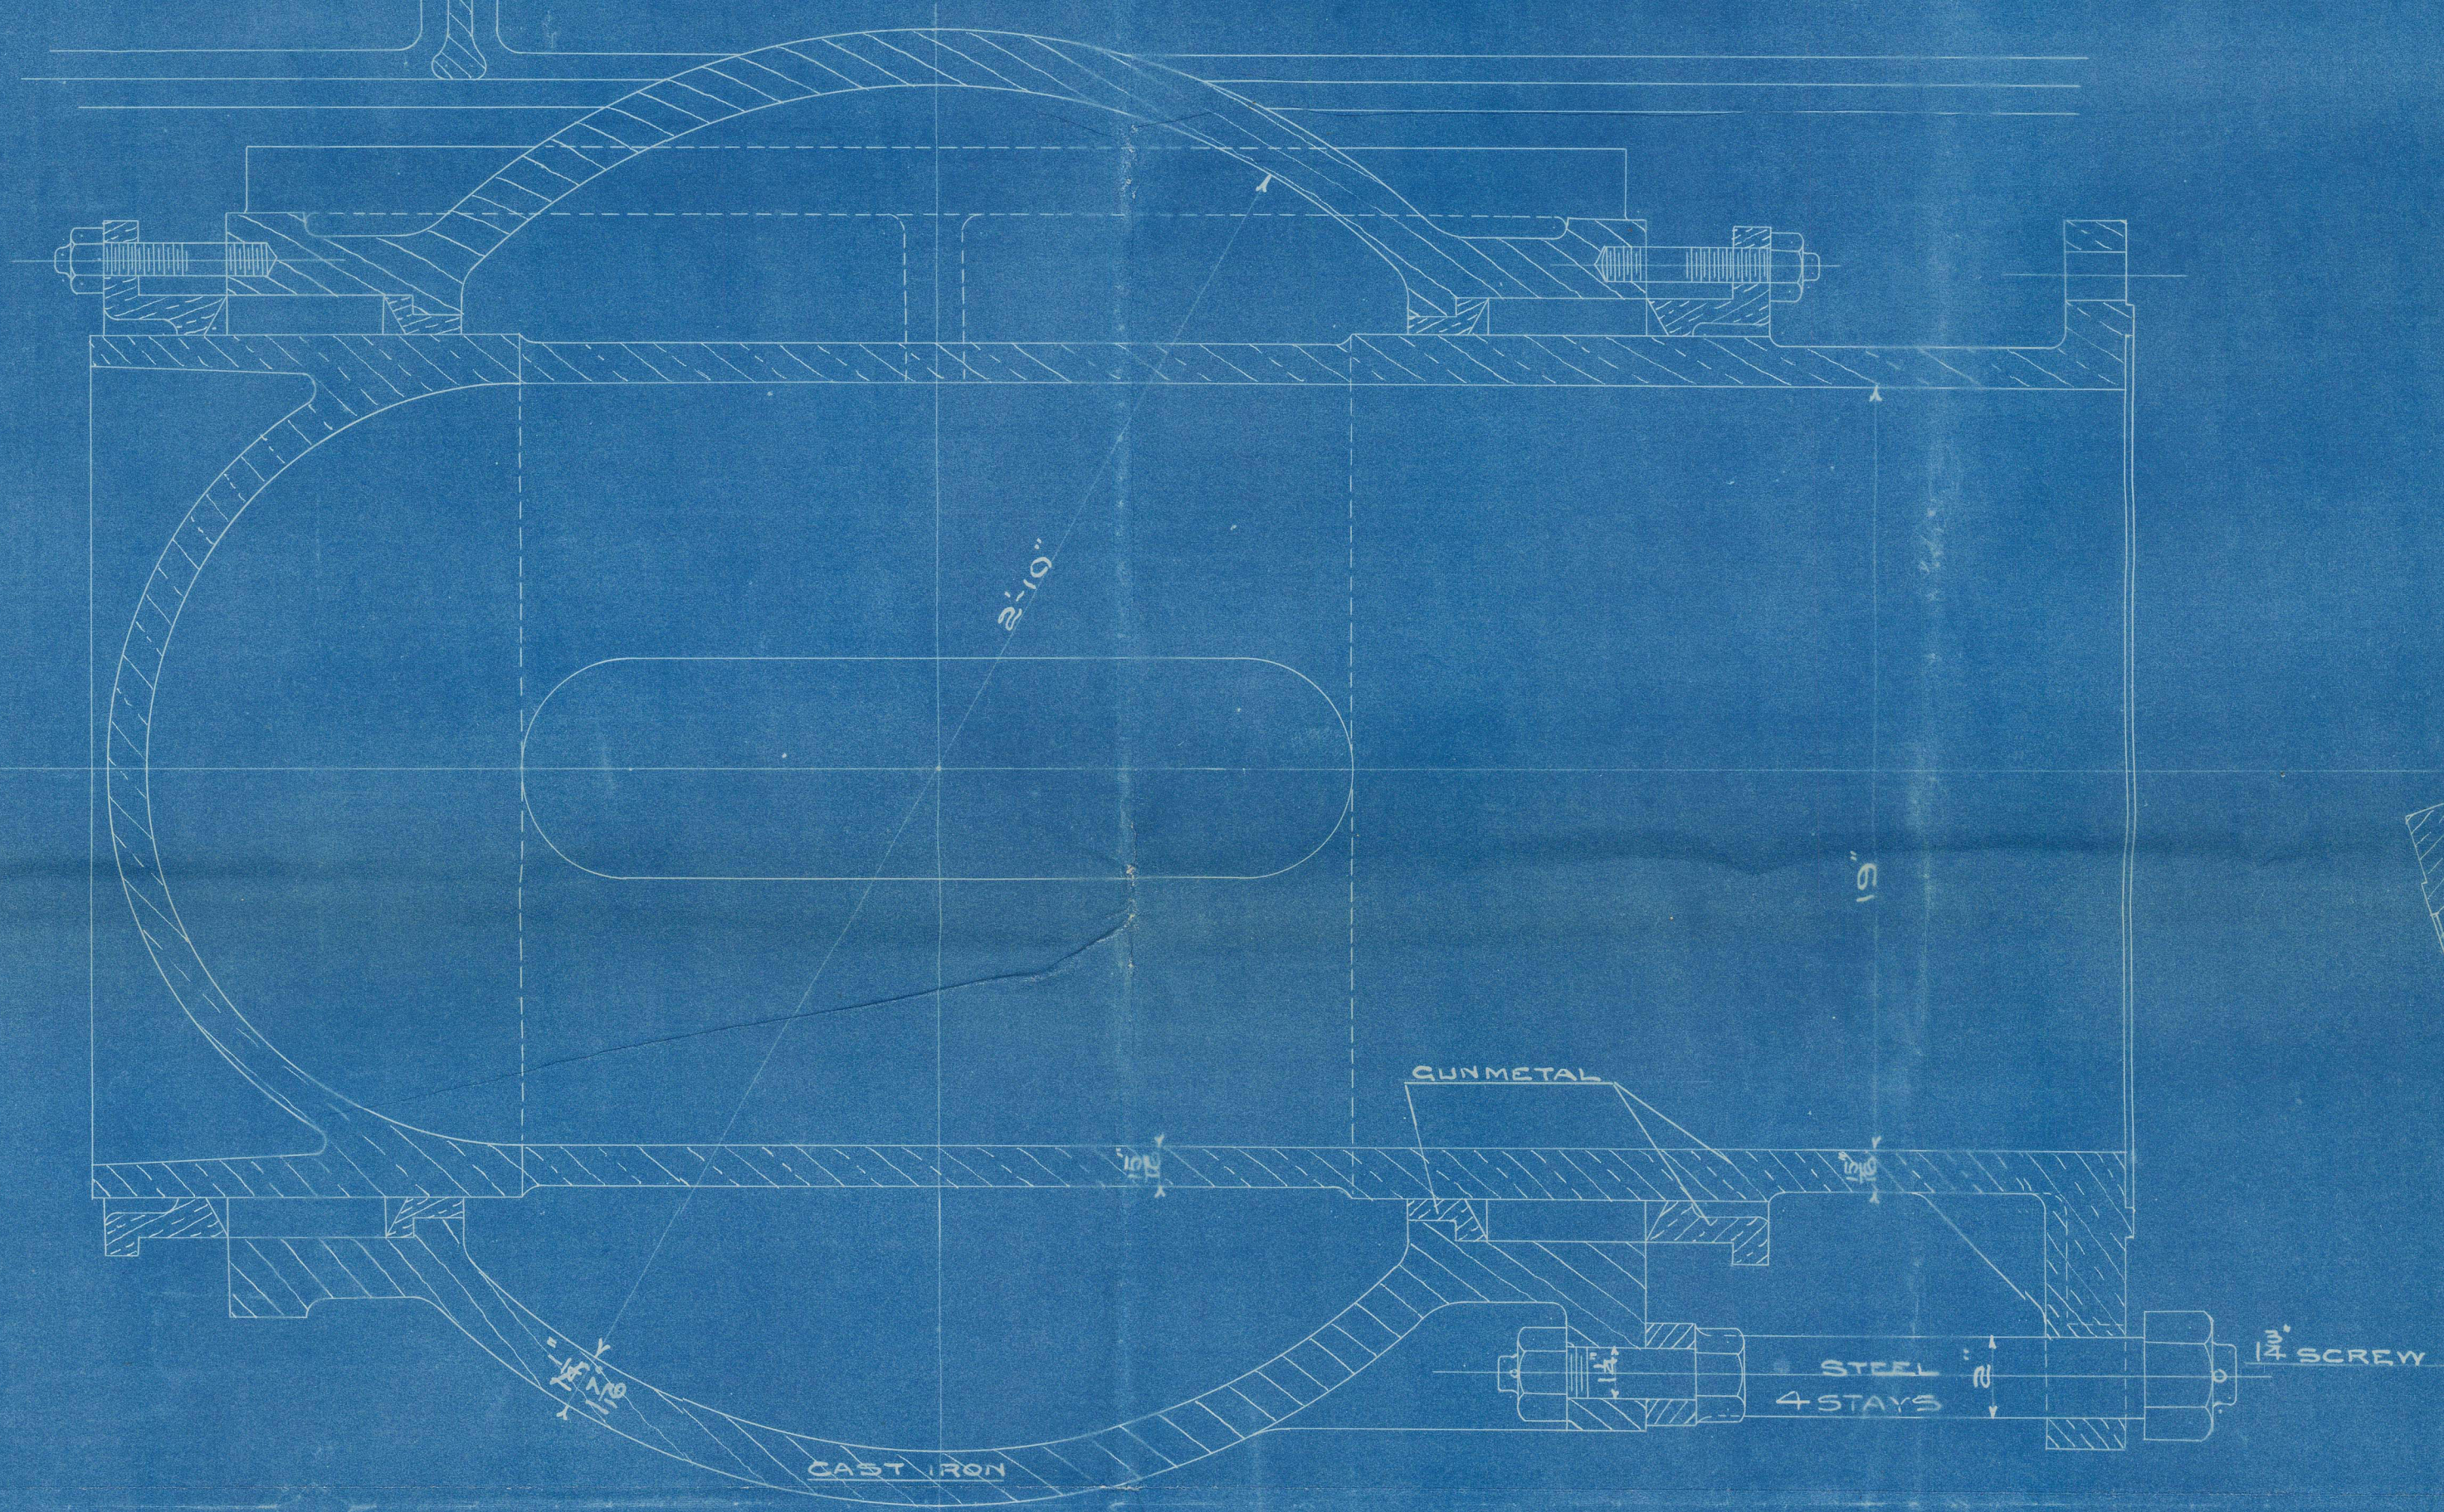

1 OFF "C"

TEST PRESSURE 540 LBS PER SQ IN

W.H. 11.8.98

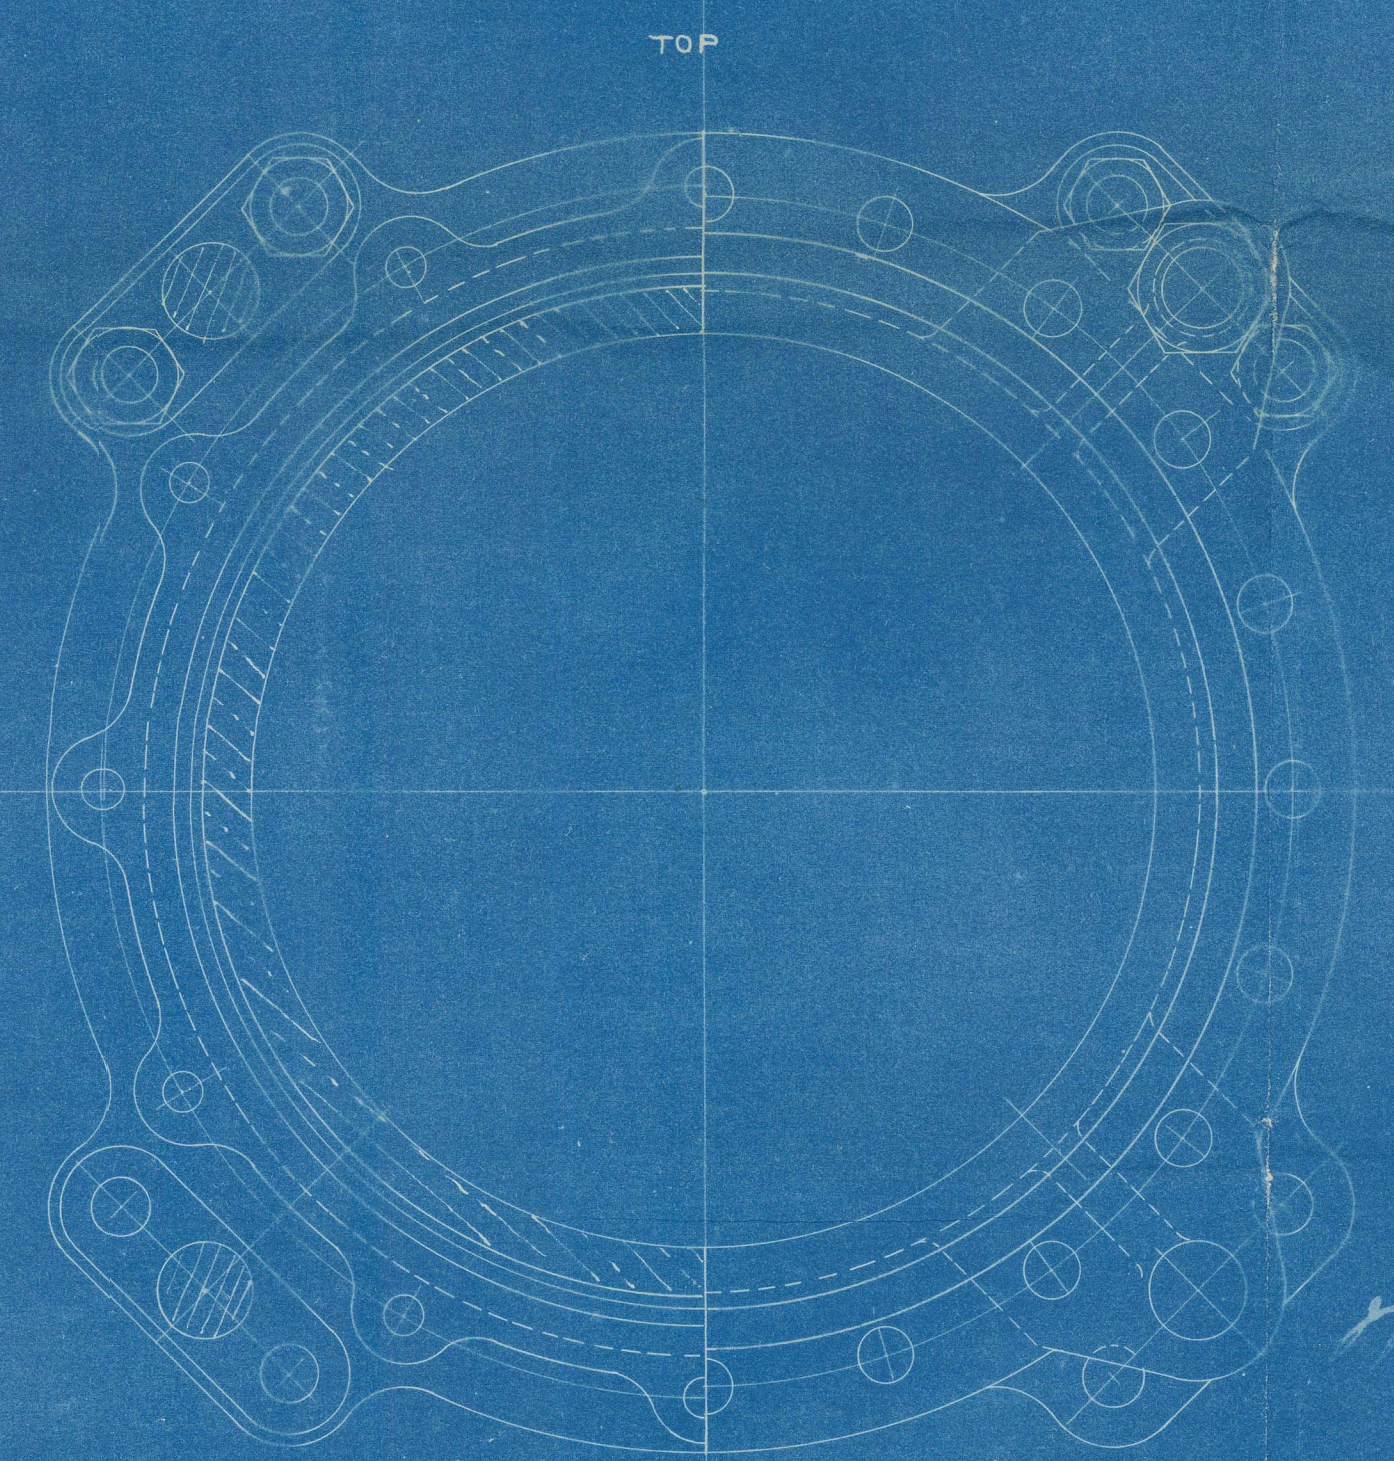

Modified to red to Bof. requirements
23/3/98



— MAIN STEAM PIPES VALVES & TEE PIECES —
— ENGINES N° 404 —

— SCALE 3" = 1 FOOT —

5 SHEETS SHEET 2

T.14559.



Fairfield St. N.Y. 67h° 404 1/2

Plan of the Palace etc "C"

S. S. "Omrah"

St. Rpt. No 16687



© 2021

Lloyd's Register
Foundation