

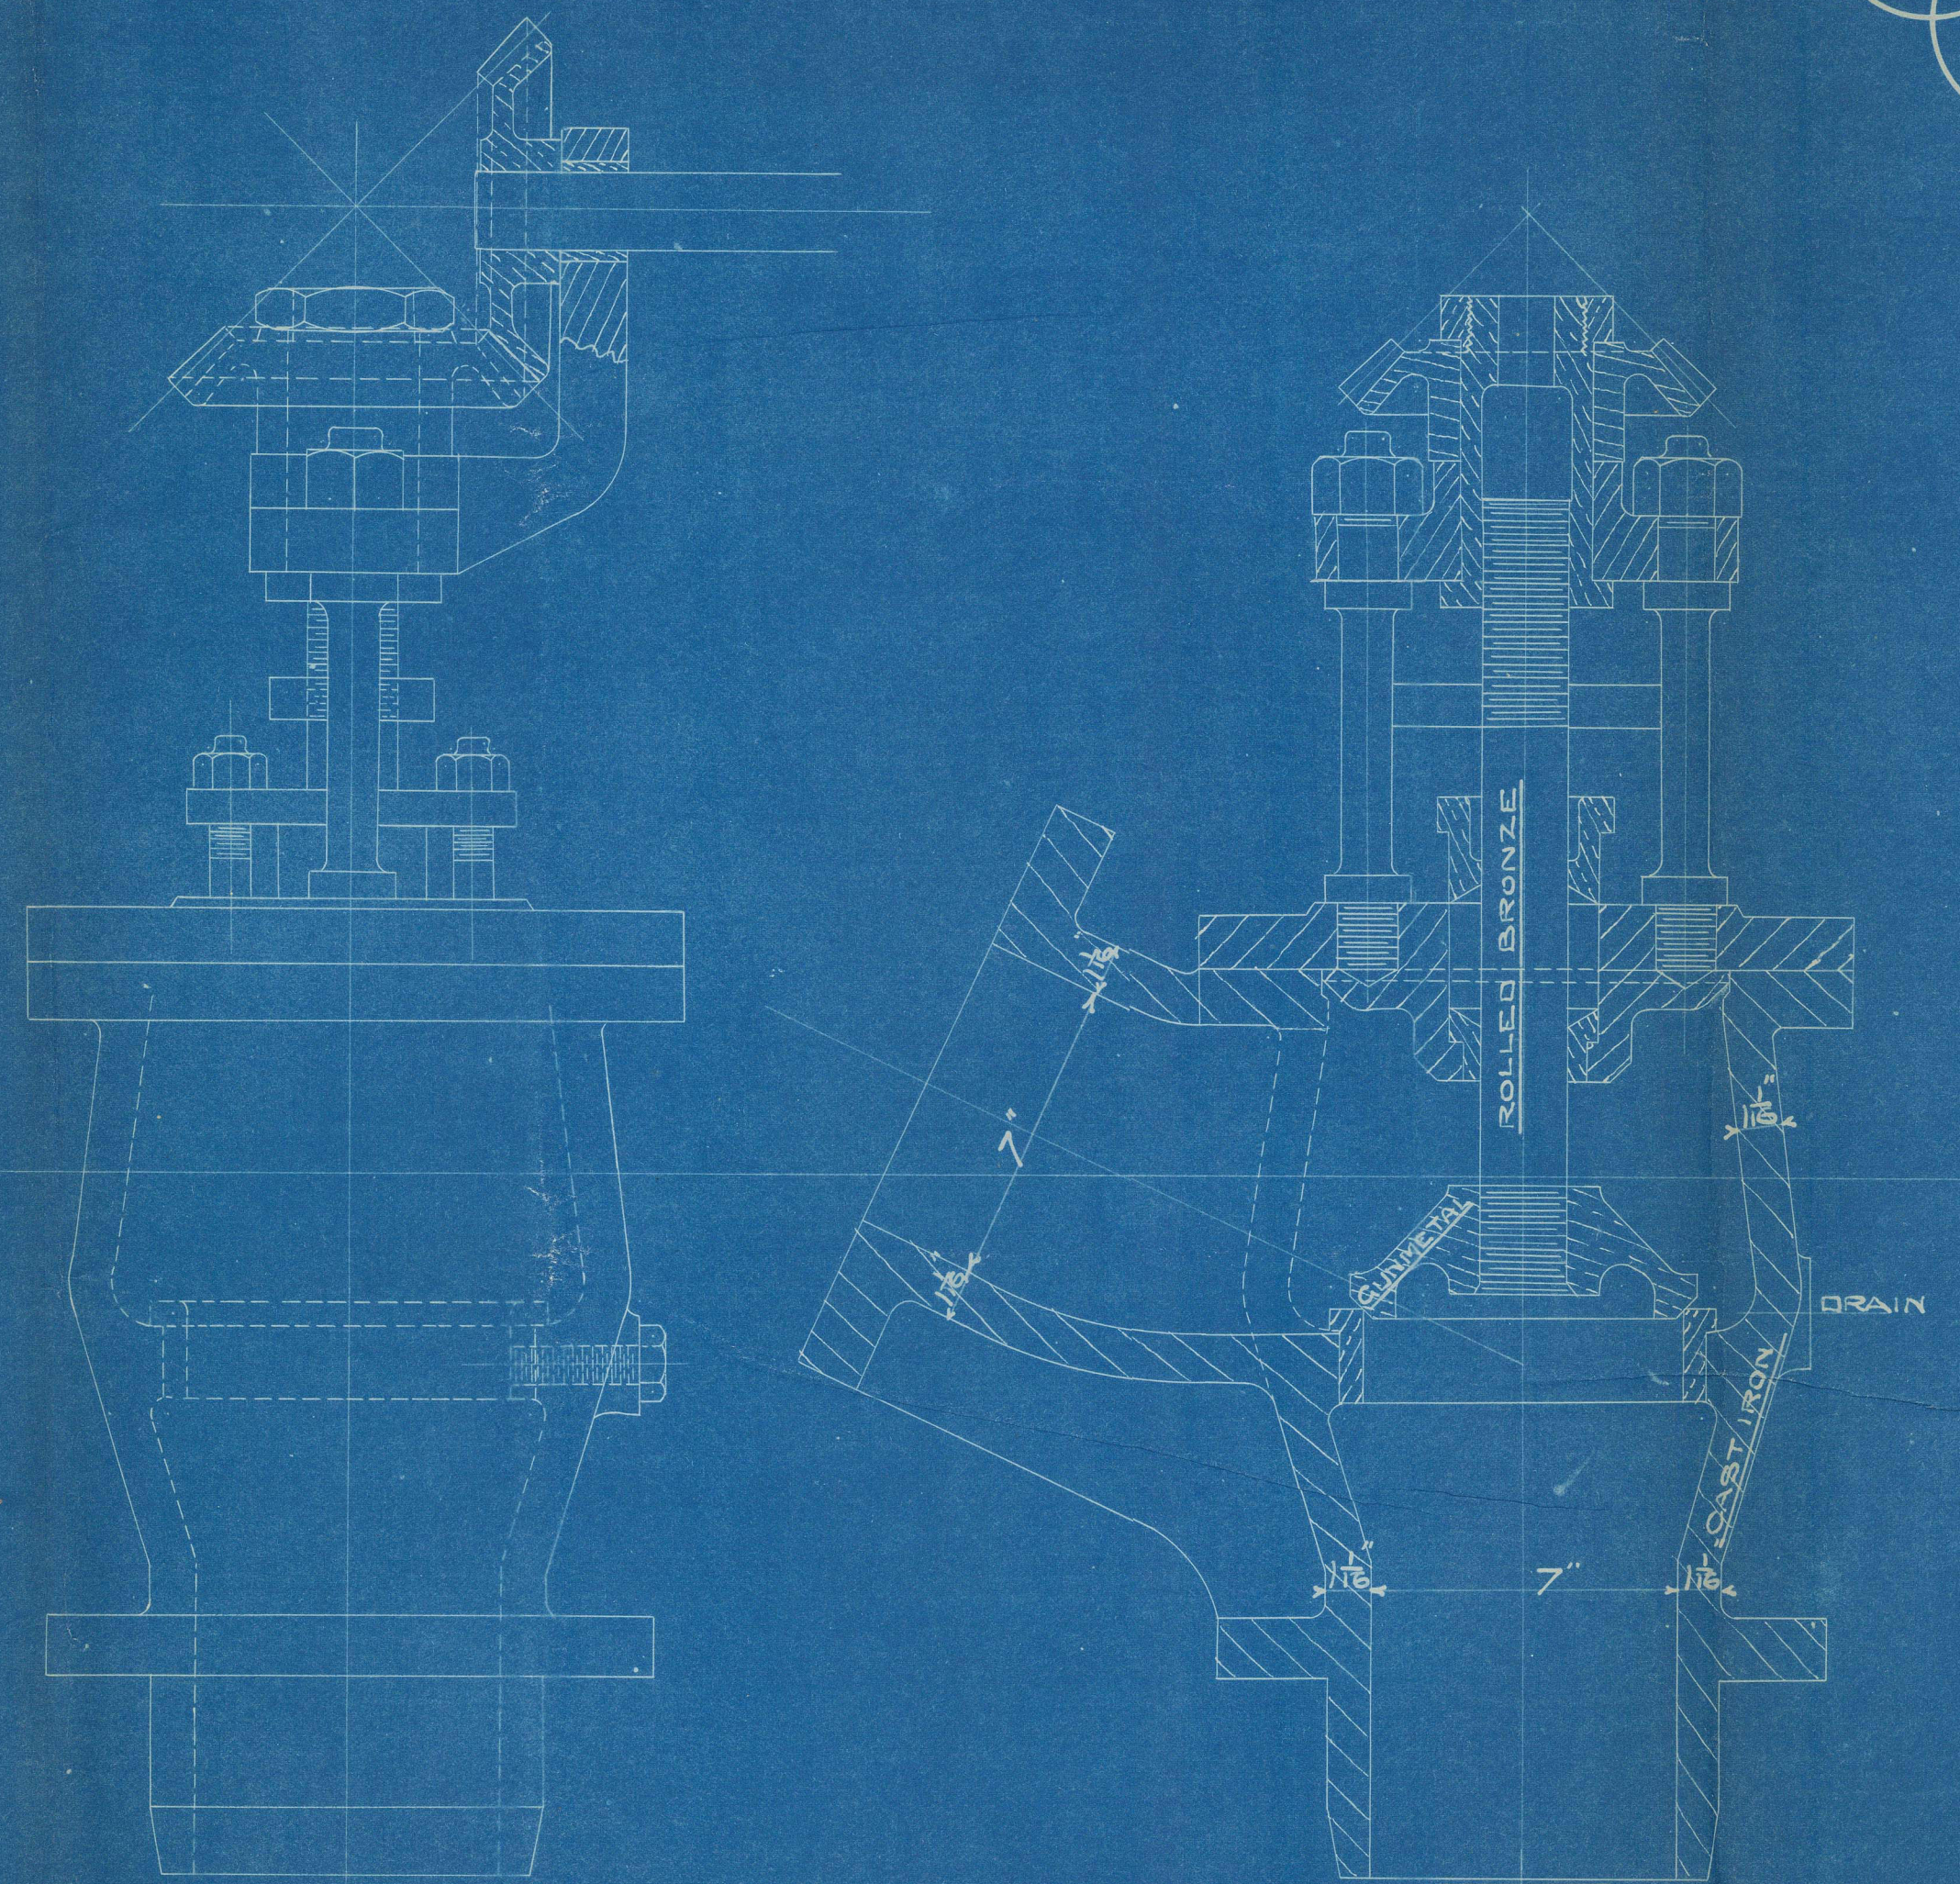
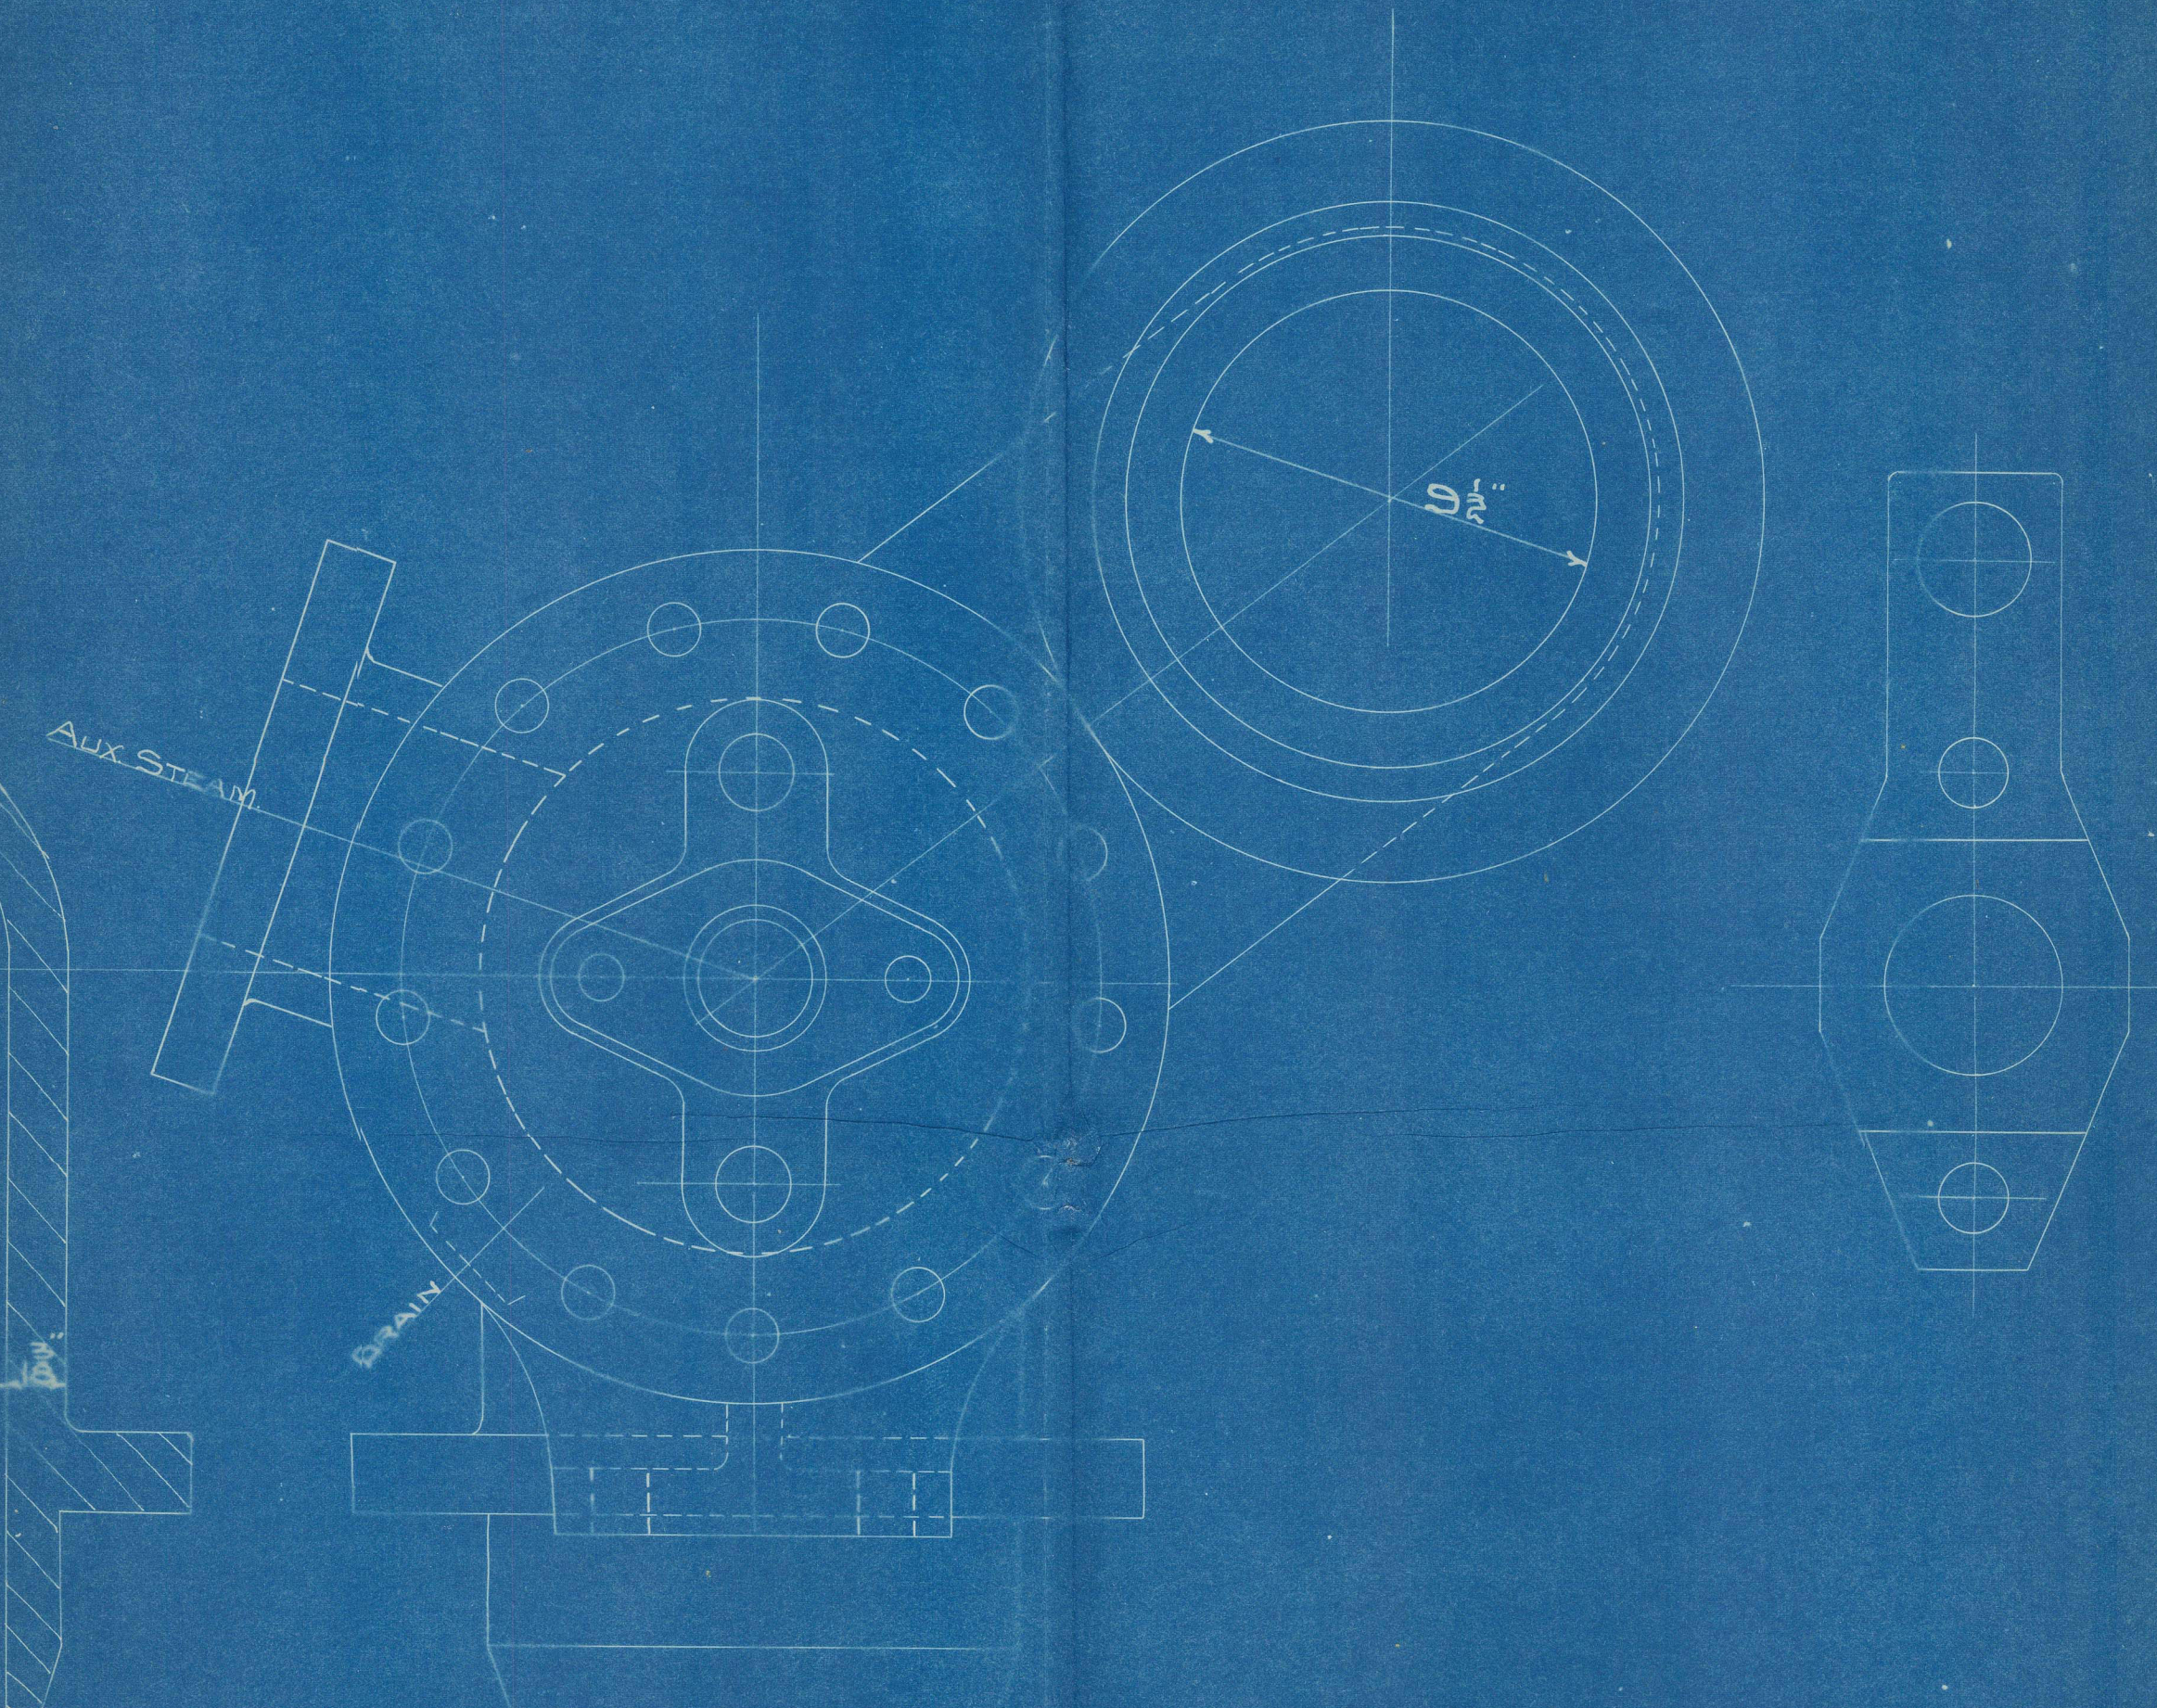
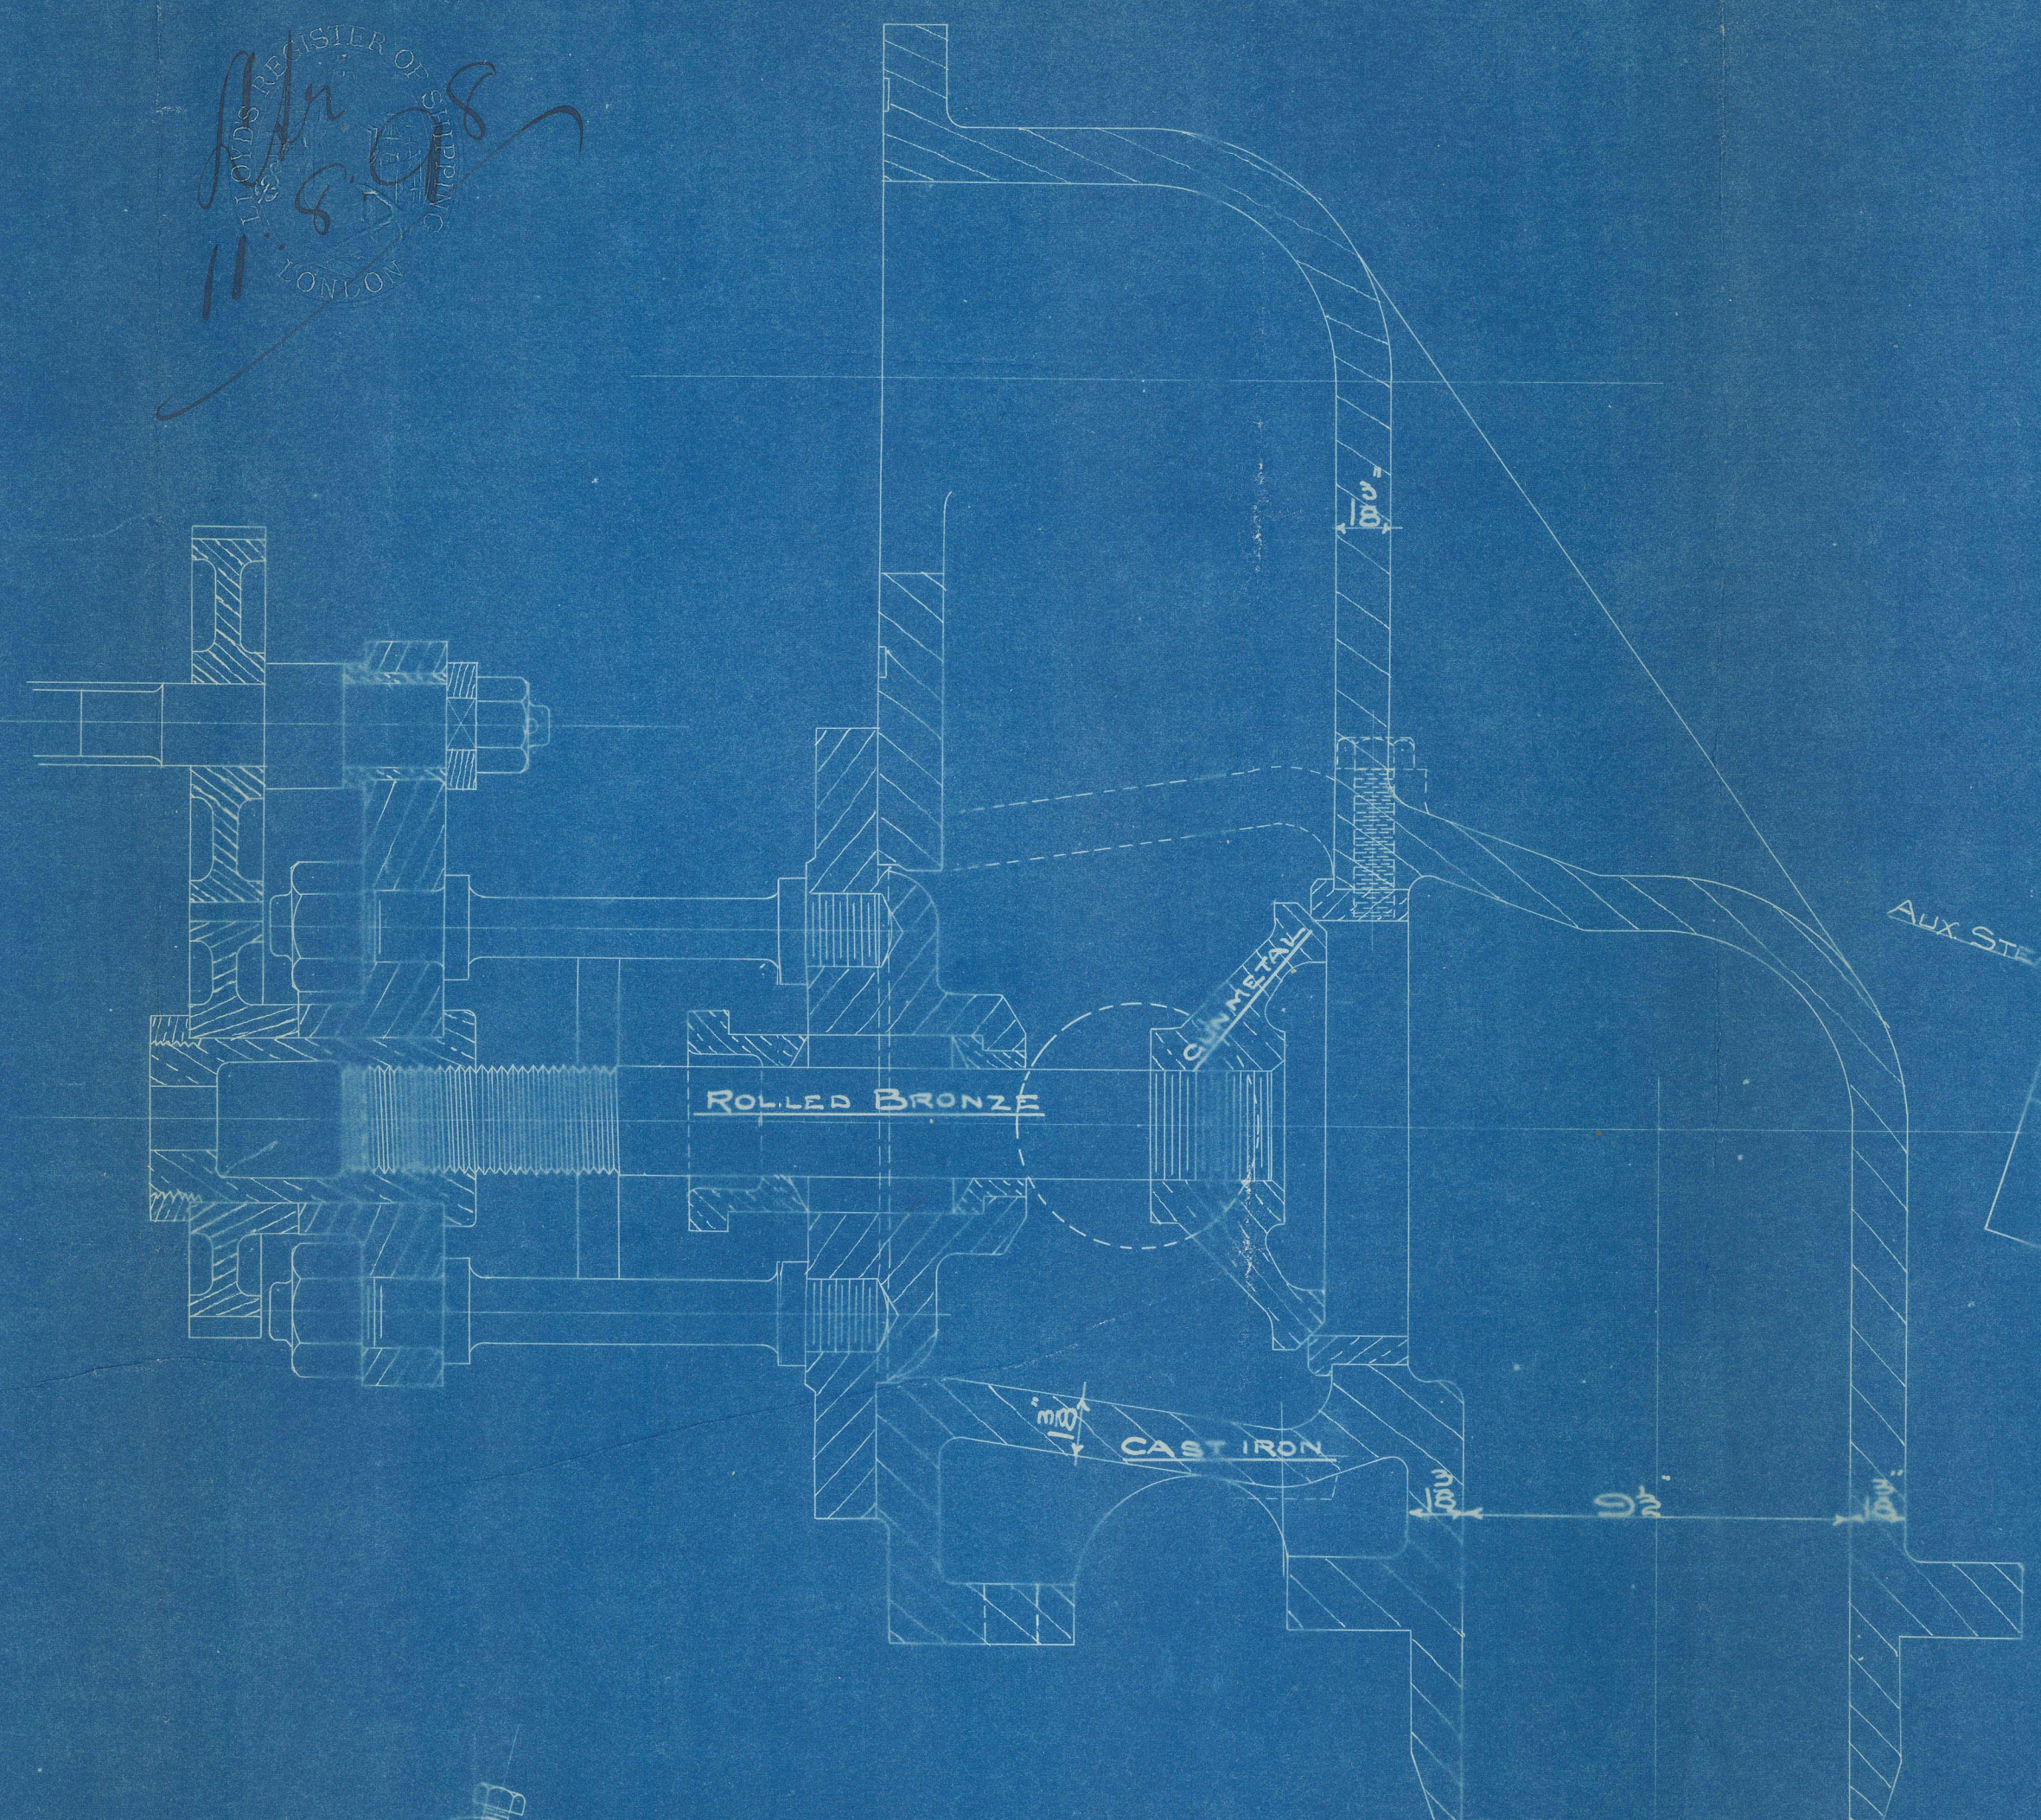


11-8-98  
11-8-98


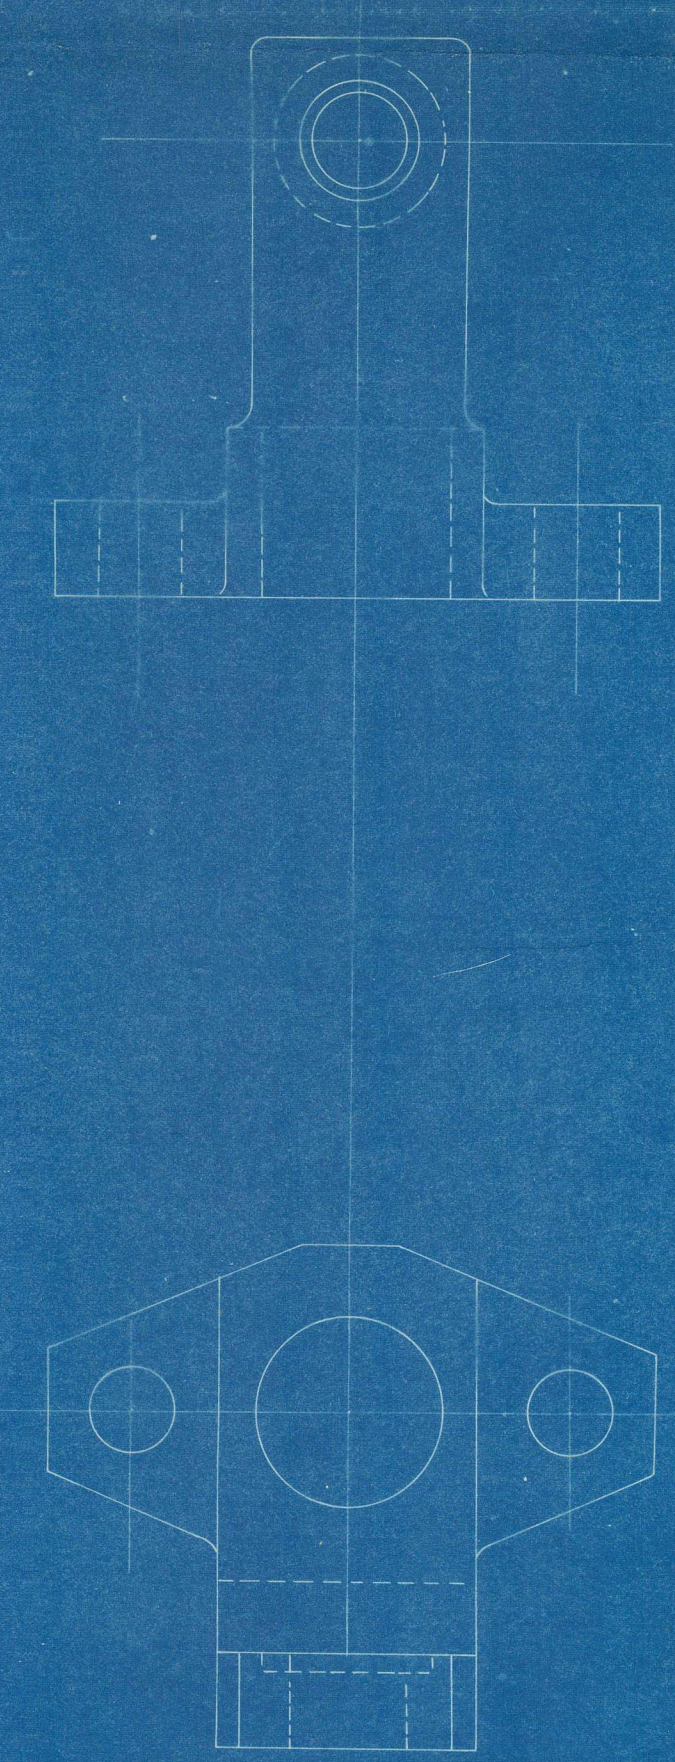


1 OFF AS DRAWN FOR PORT FOR<sup>d</sup> BOILER "H" WITH BRANCH FOR AUX. STEAM  
1 " TO OTHER HAND " STAR<sup>d</sup> " " " " " " " " " " " "

1 OFF FOR AFT. SE. BOILER "E"

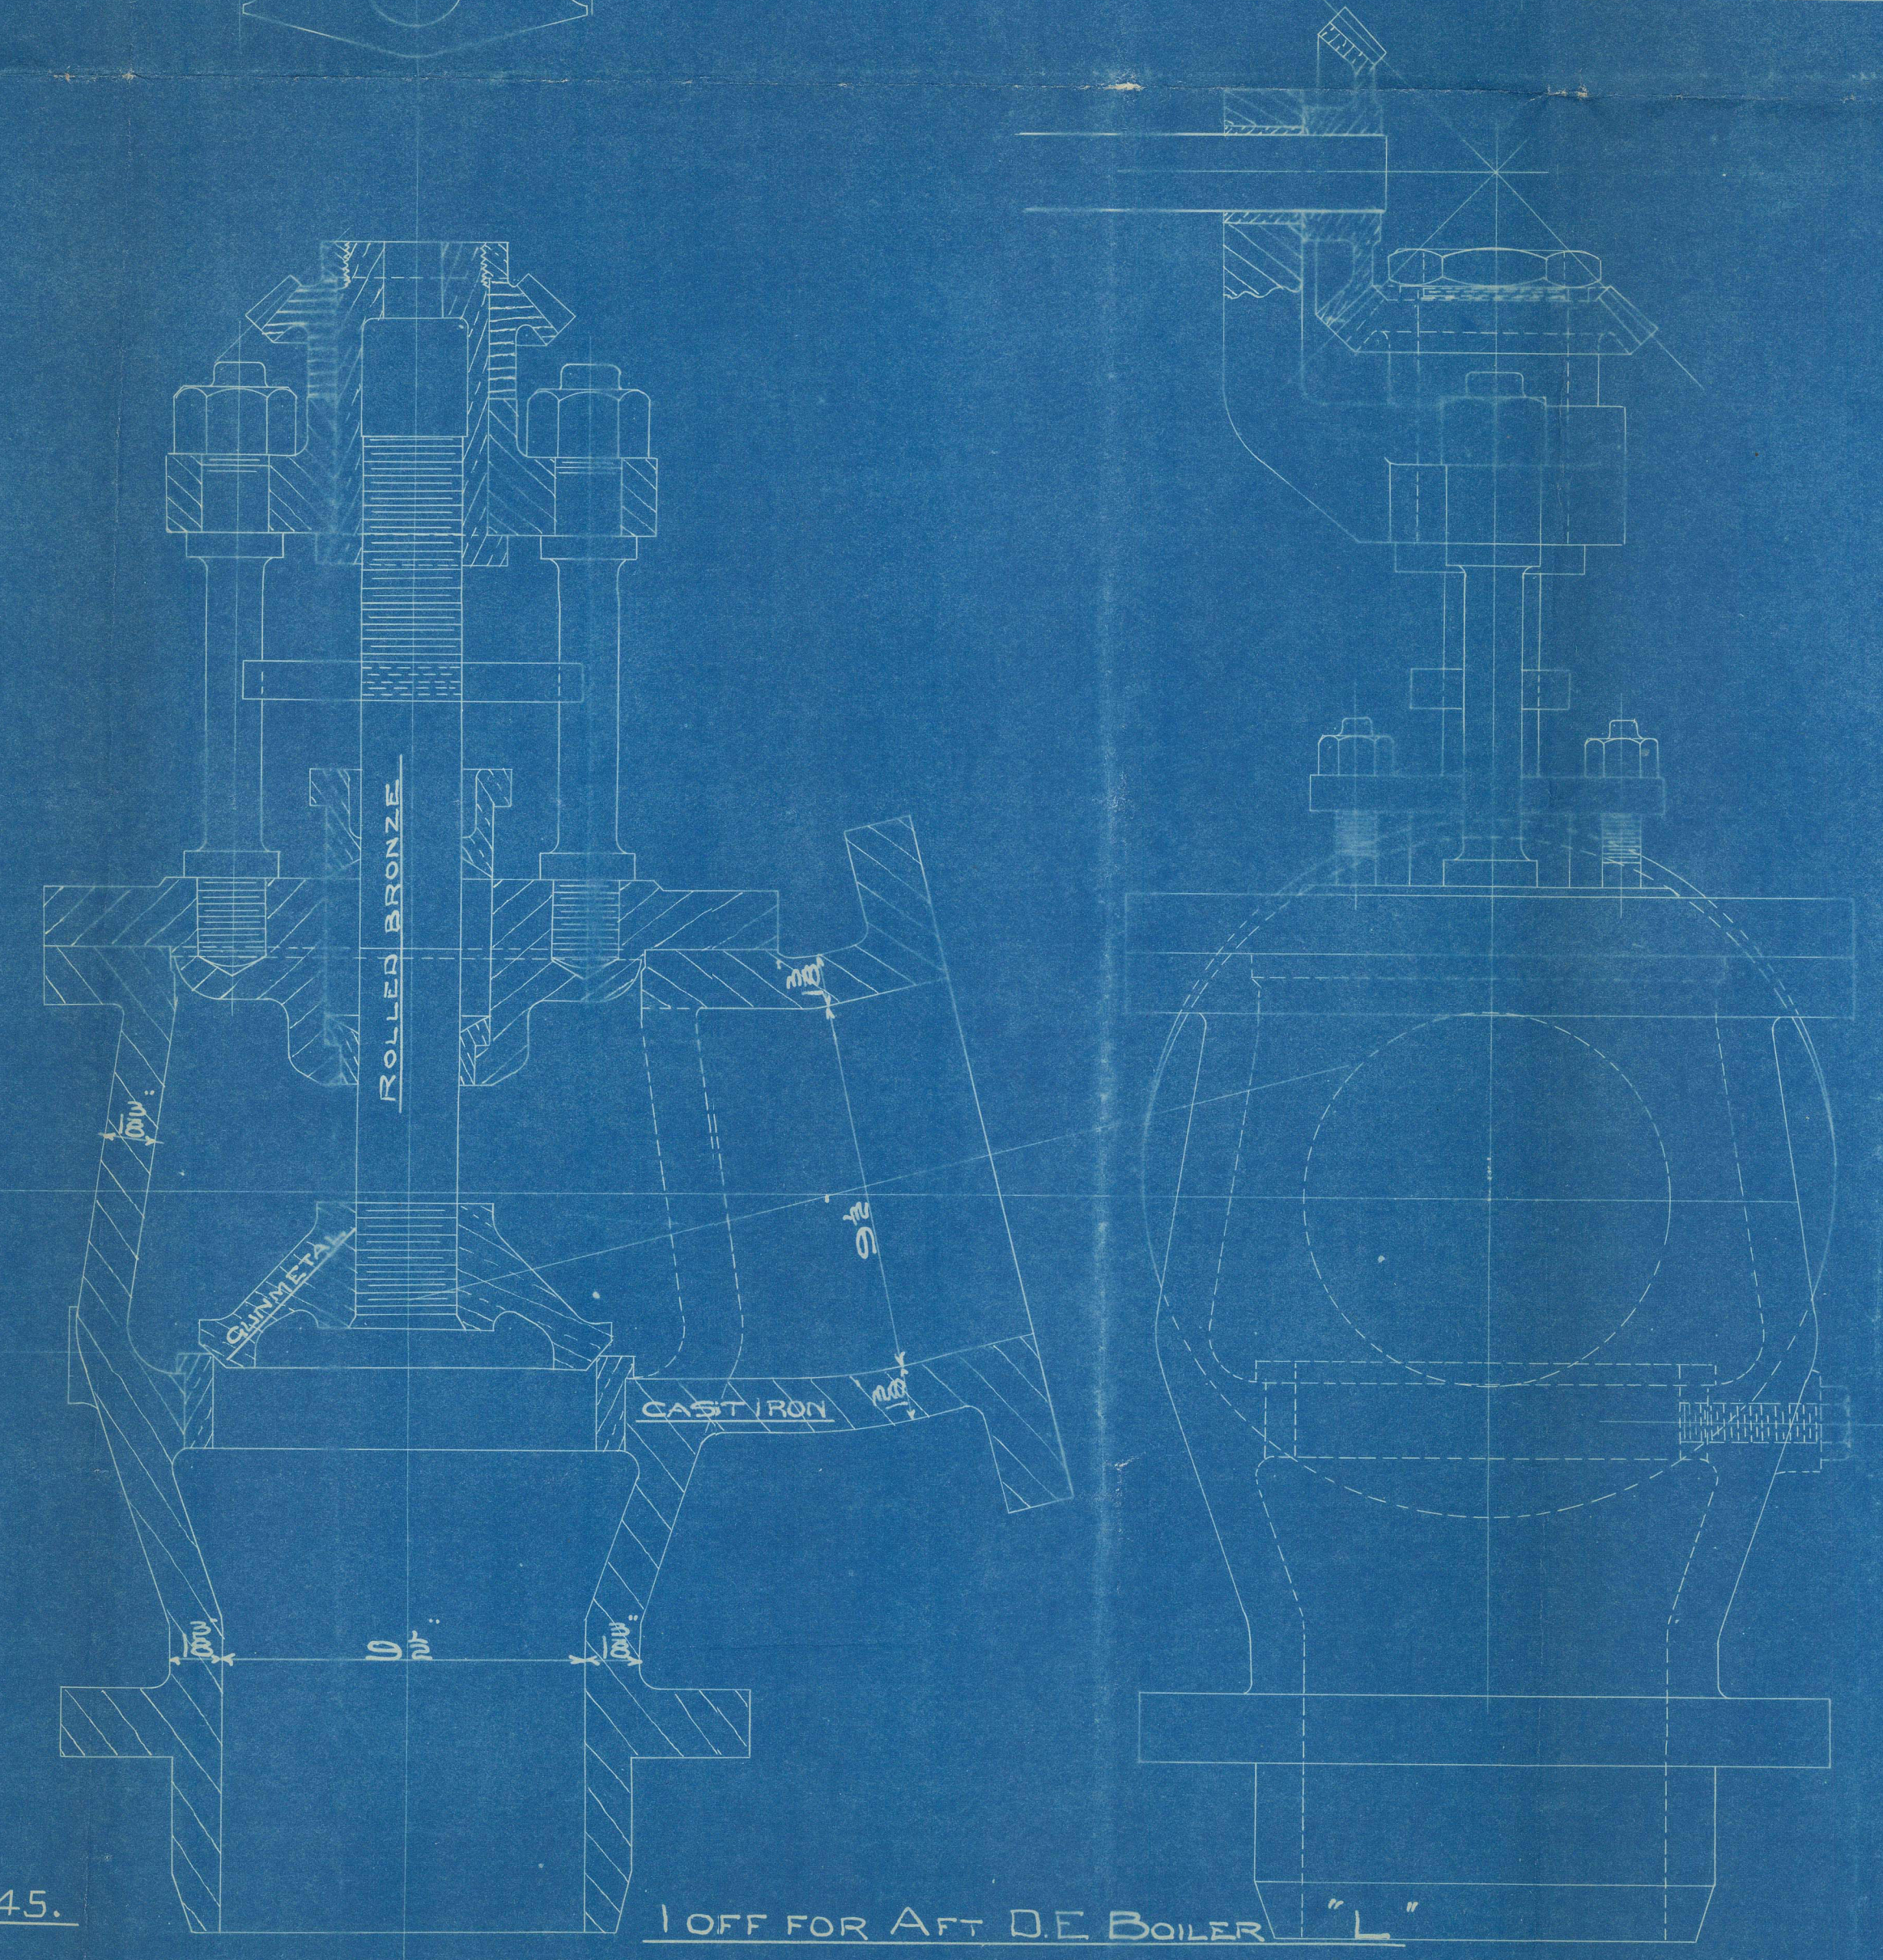

WORKING PRESSURE 180 LBS PER SQ. INCH  
TEST " 540 " " " " " " "

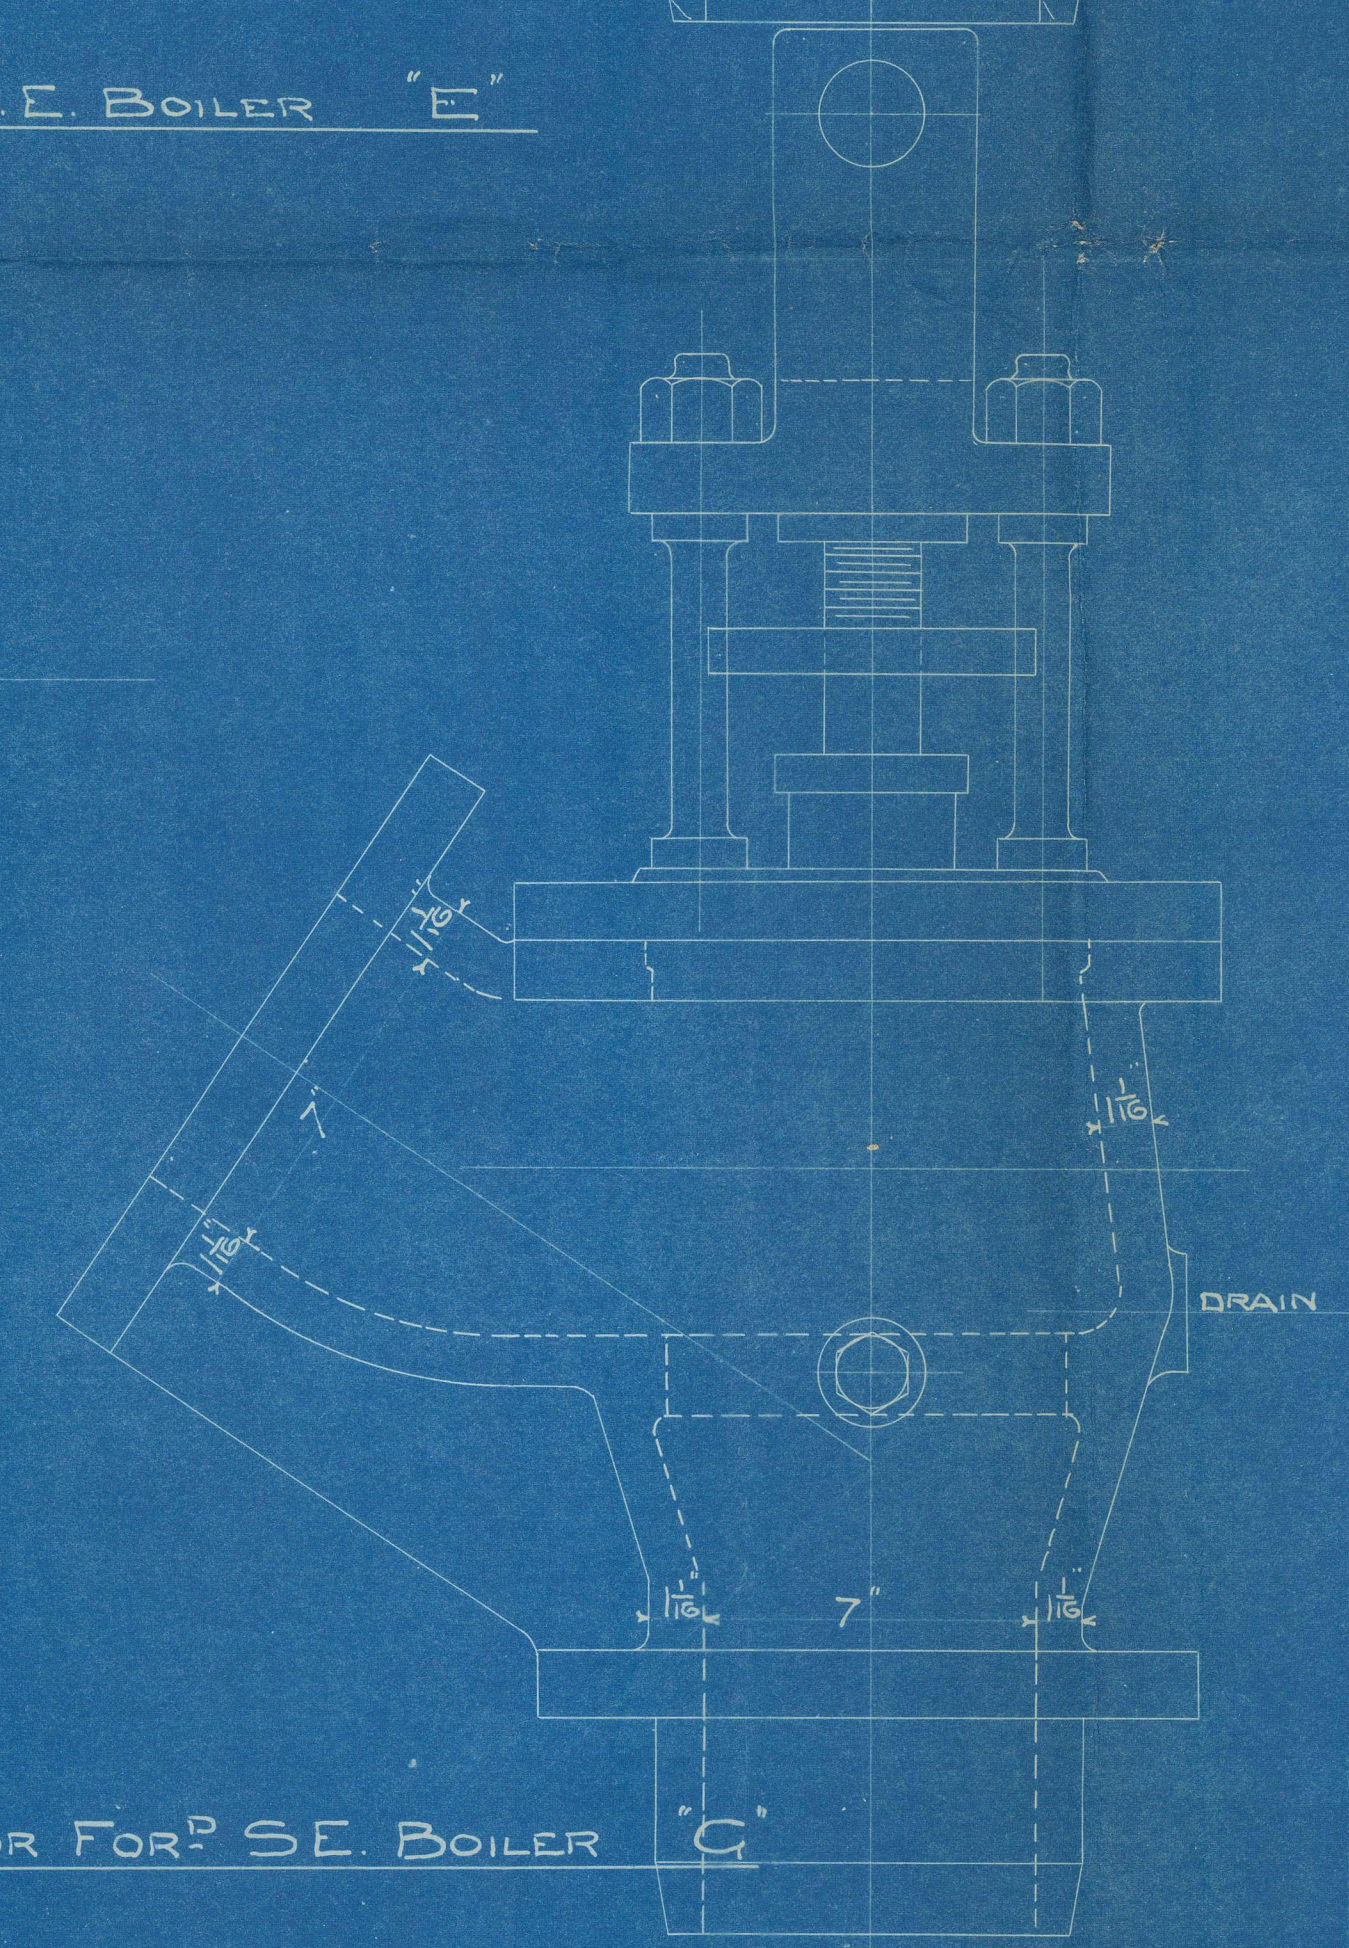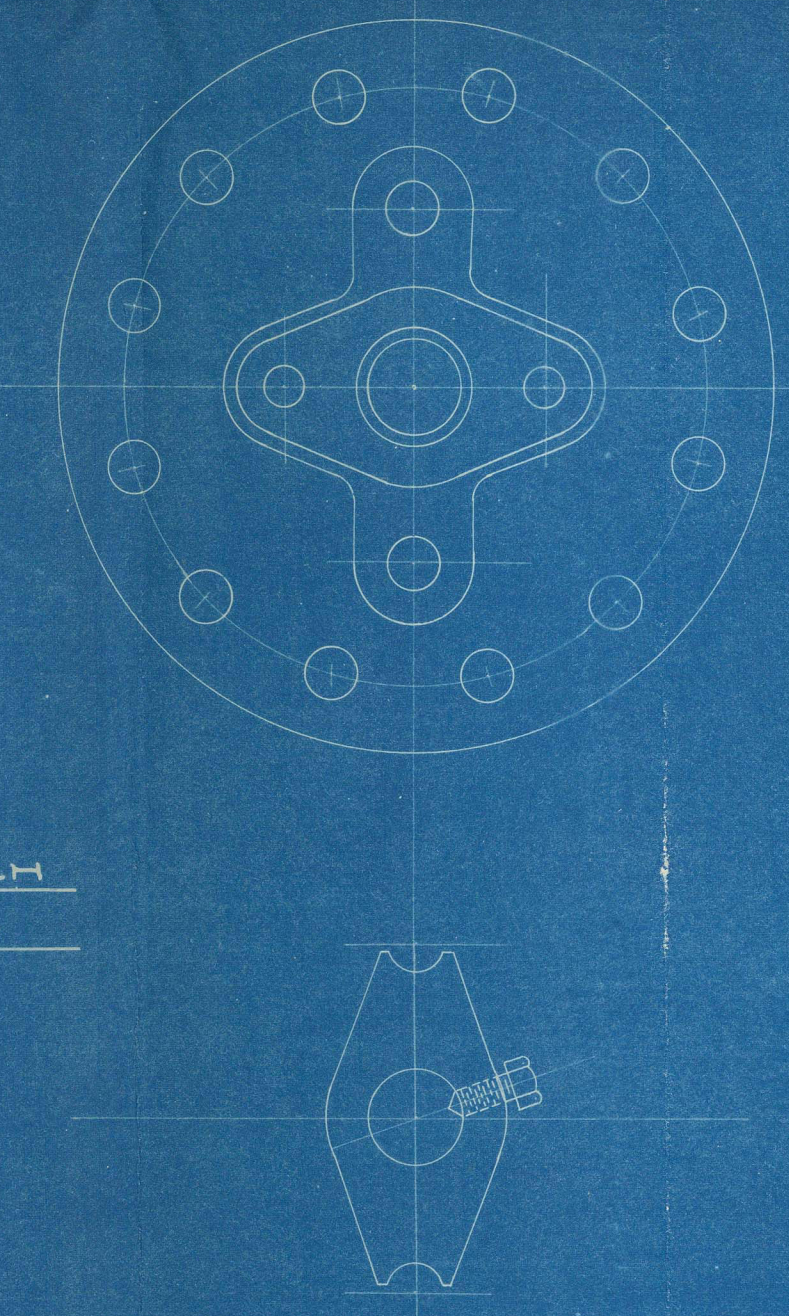

1 OFF FOR FOR<sup>d</sup> SE. BOILER "G"

BOILER STOP VALVES  
— ENGINES N<sup>o</sup> 404 —  
— SCALE 3" = 1 FOOT —

Passed by B.P. 33/10/11

T. 1445.

1 OFF FOR AFT. DE. BOILER "L"



John Stewart 1911





Tanqueria & Co. Ltd.  
No. 404 vessel.

Sup value £100

"E.G.H.M." Ltd

Checked

S.S. "Omrah"

See Rpt. No. 16687

5400-£72579



© 2021

Lloyd's Register  
Foundation