


4.12.97

T.S.S. N° 404.


PROPOSED AMENDED ARRANGEMENT OF BRIDGE BEAMS

INTRODUCING BULB TEES ON ALTERNATE FRAMES IN LIEU OF BULB ANGLES ON EVERY FRAME.
AT FORE END.


ELEVATION
SCALE $\frac{1}{8}$ " = 1 FOOT

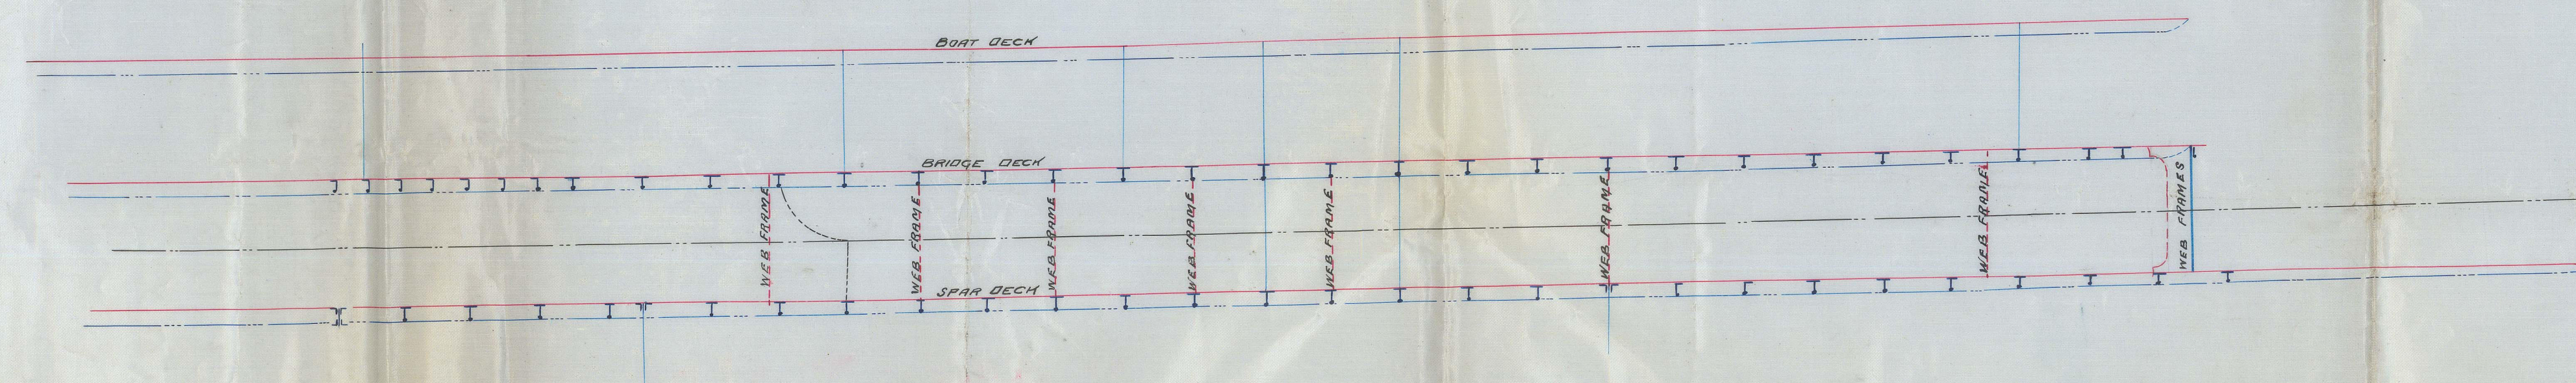

PLAN
SCALE $\frac{1}{8}$ " = 1 FOOT

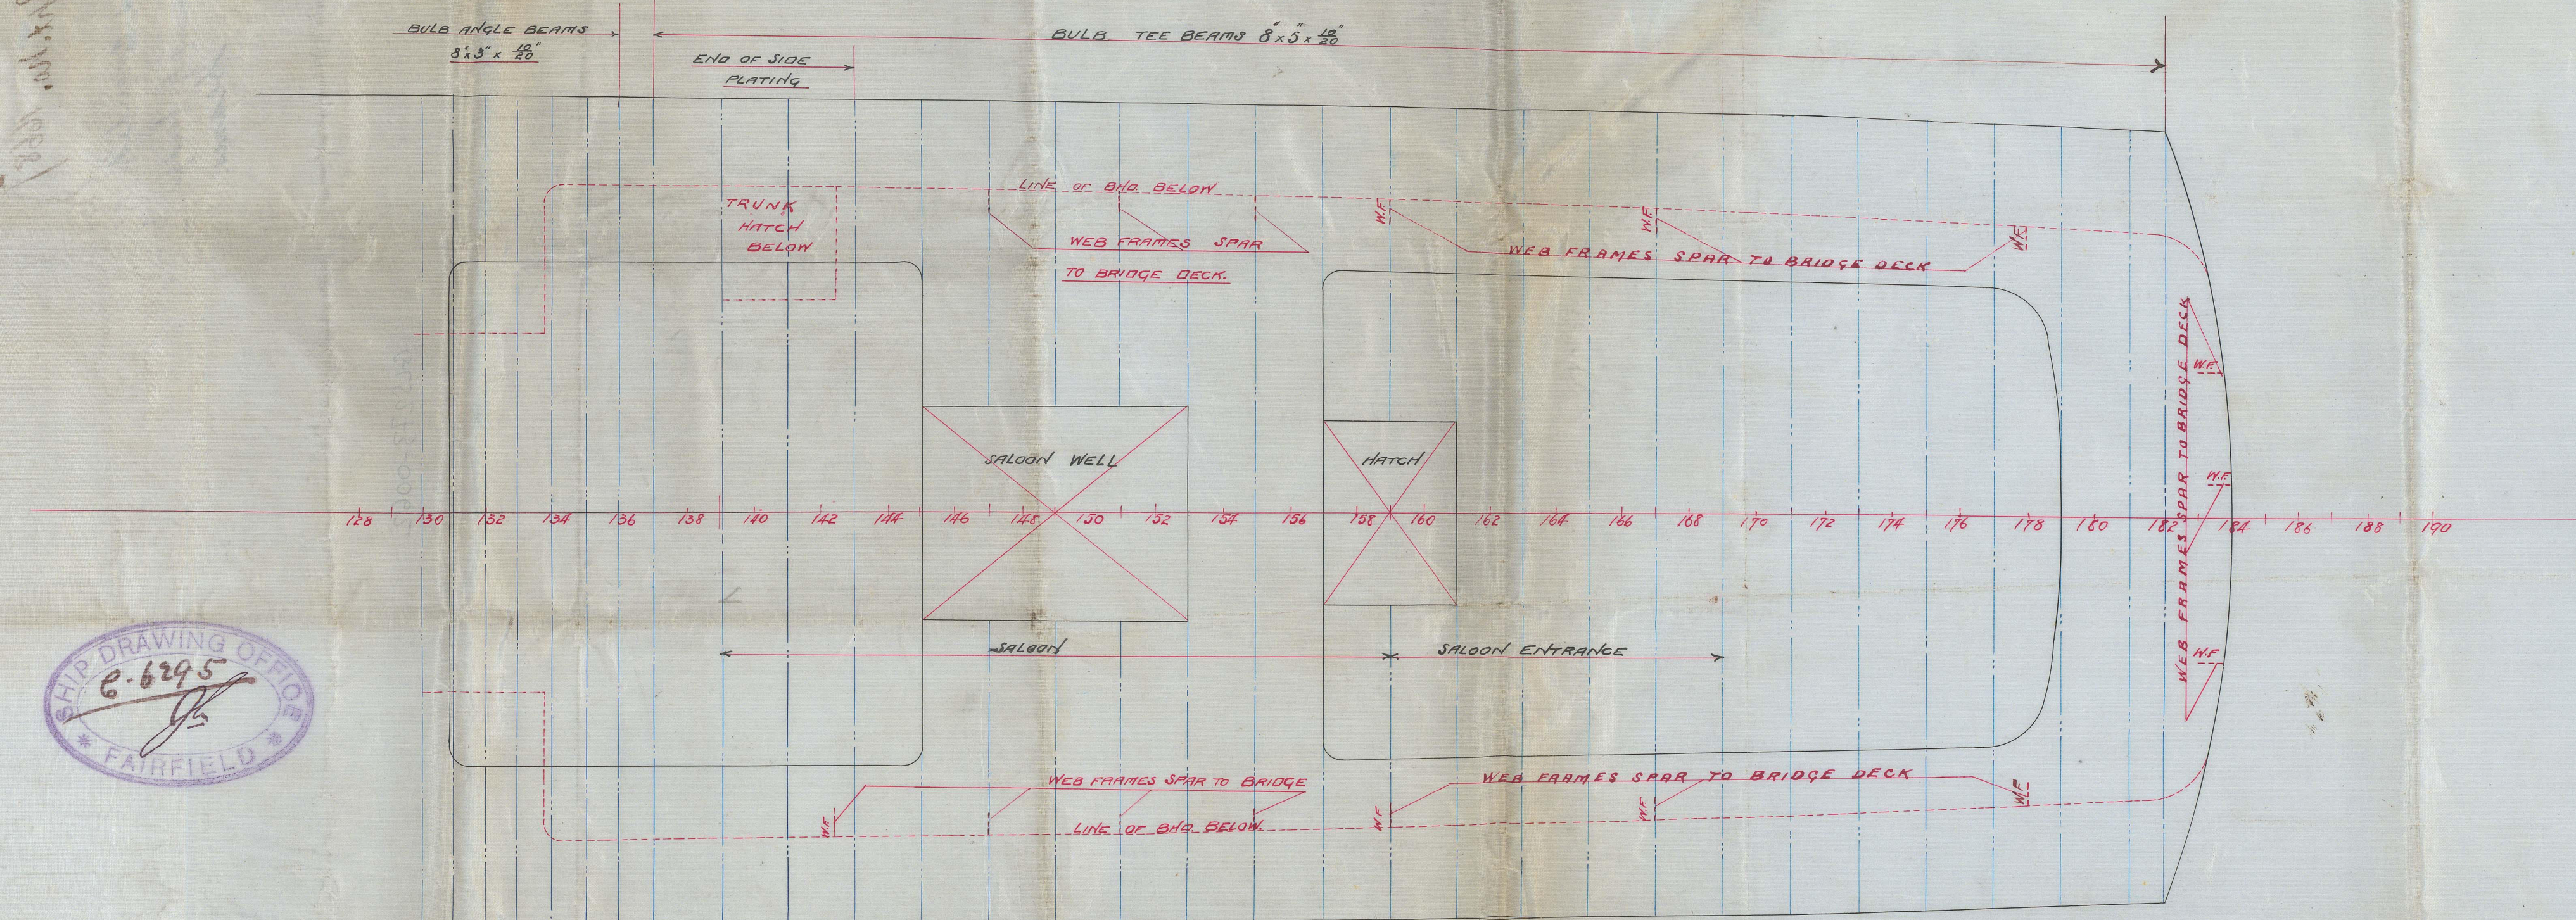

SECTION
SCALE $\frac{1}{4}$ " = 1 FOOT

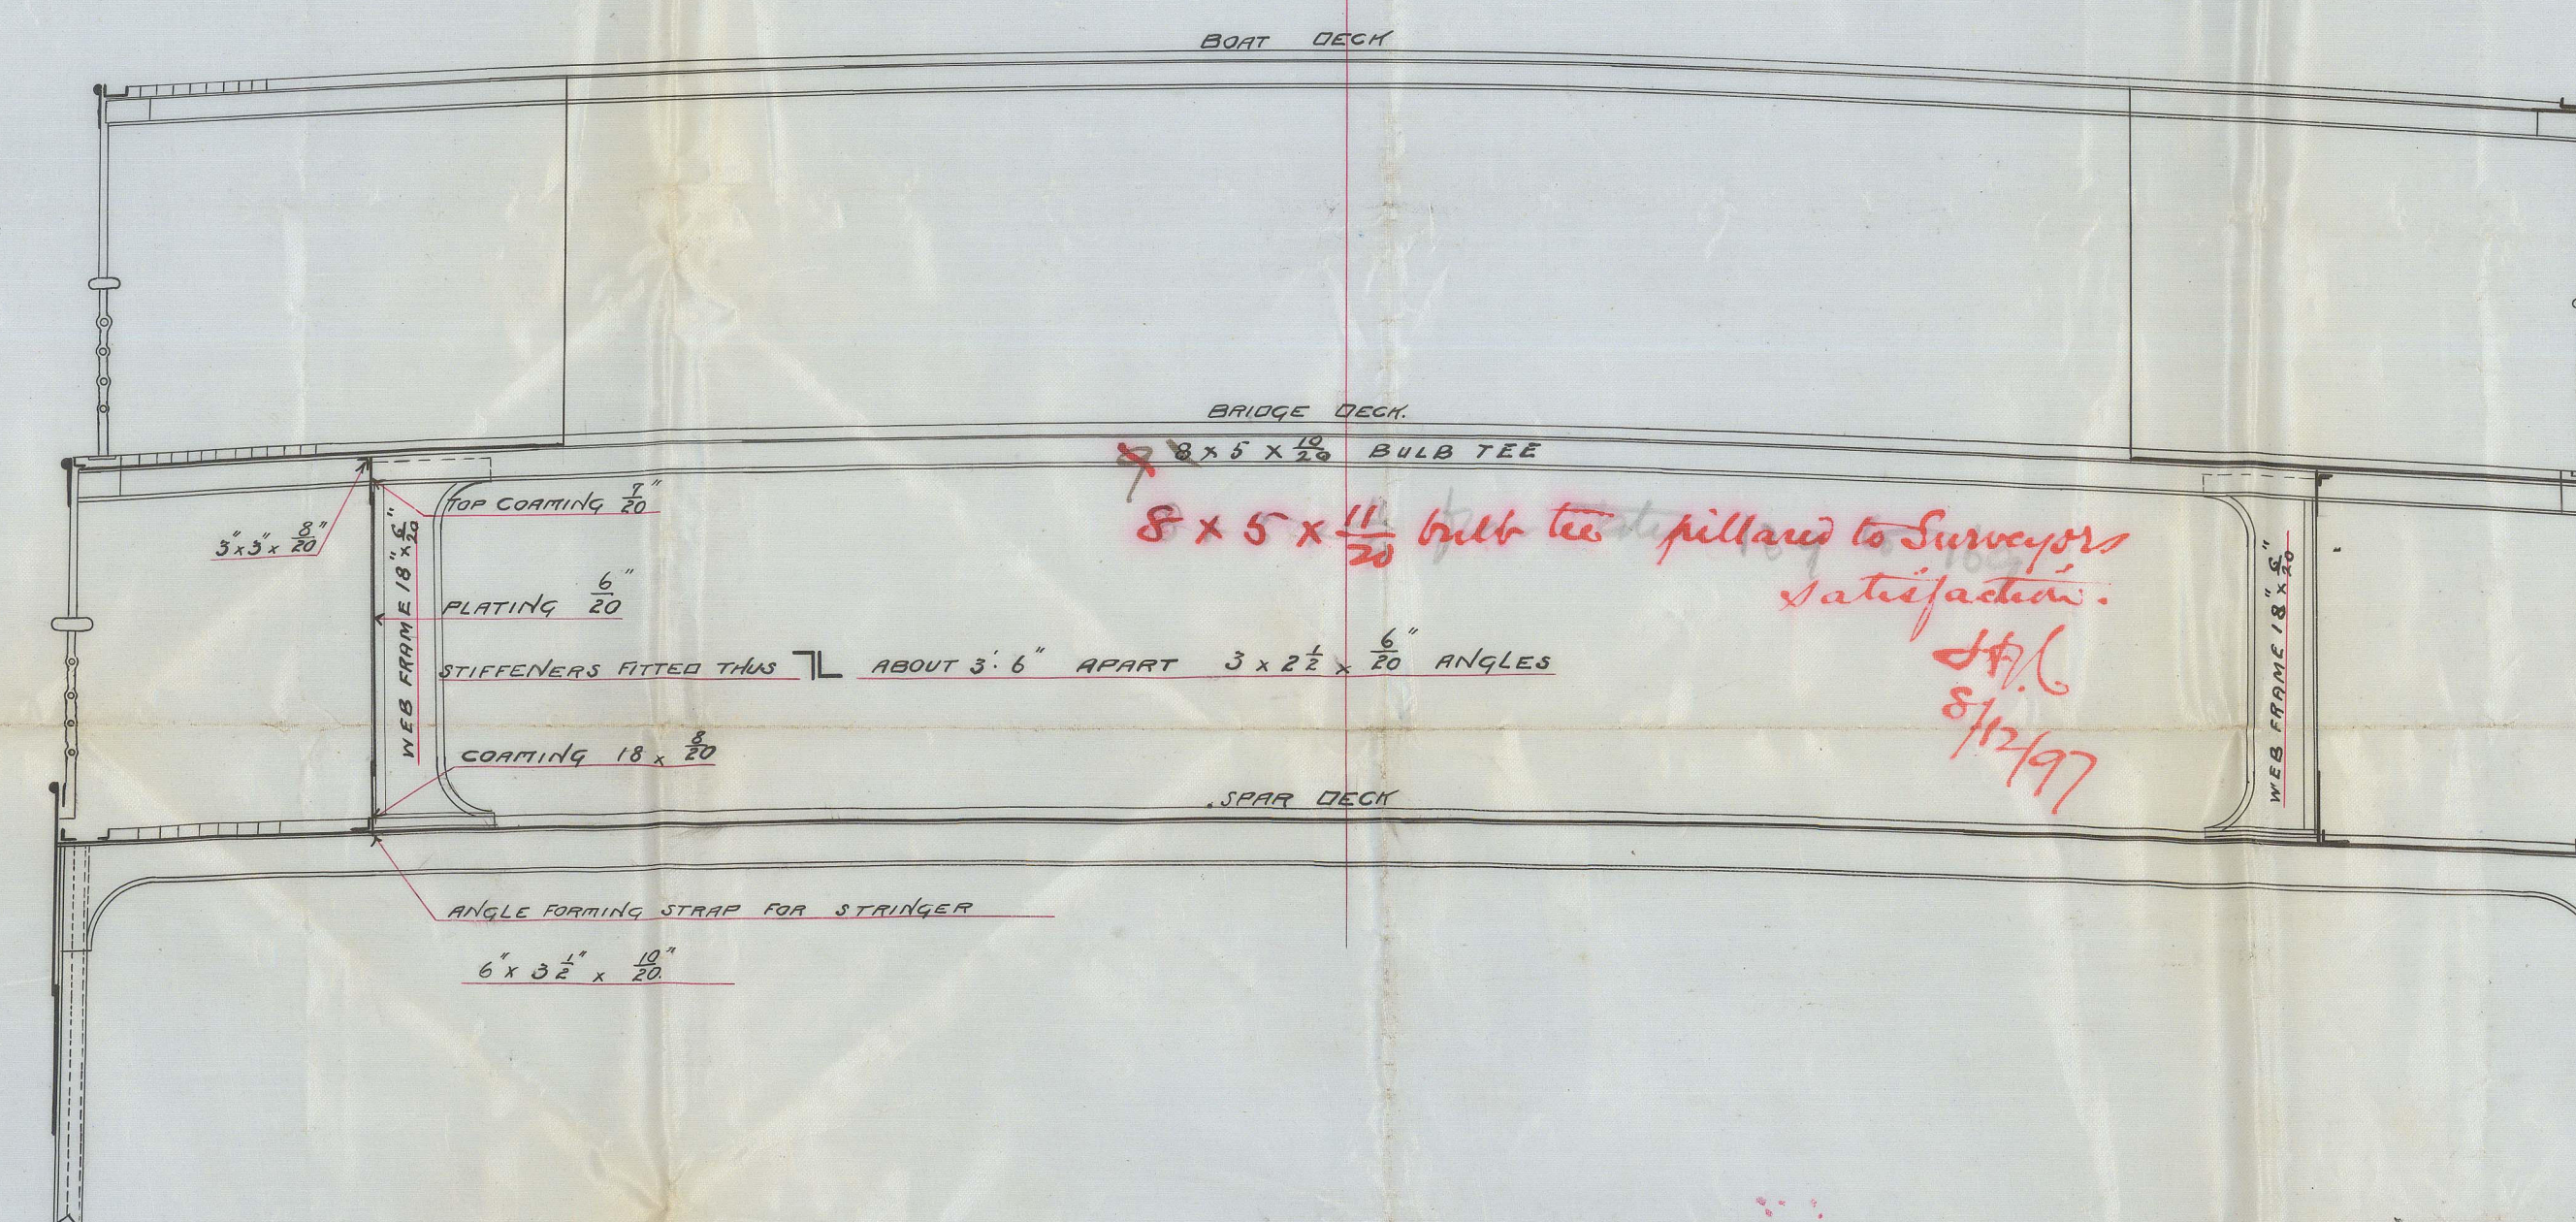


JH/L
3/12/97

Fairfield S. S.
Cr. No. 401

S. S. "Omrah"
Gls Rpt. No. 1668

Proposed amended
arrangement of bridge
beams.

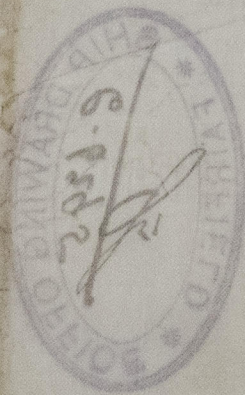

GLS273-0062



© 2021

Lloyd's Register
Foundation