


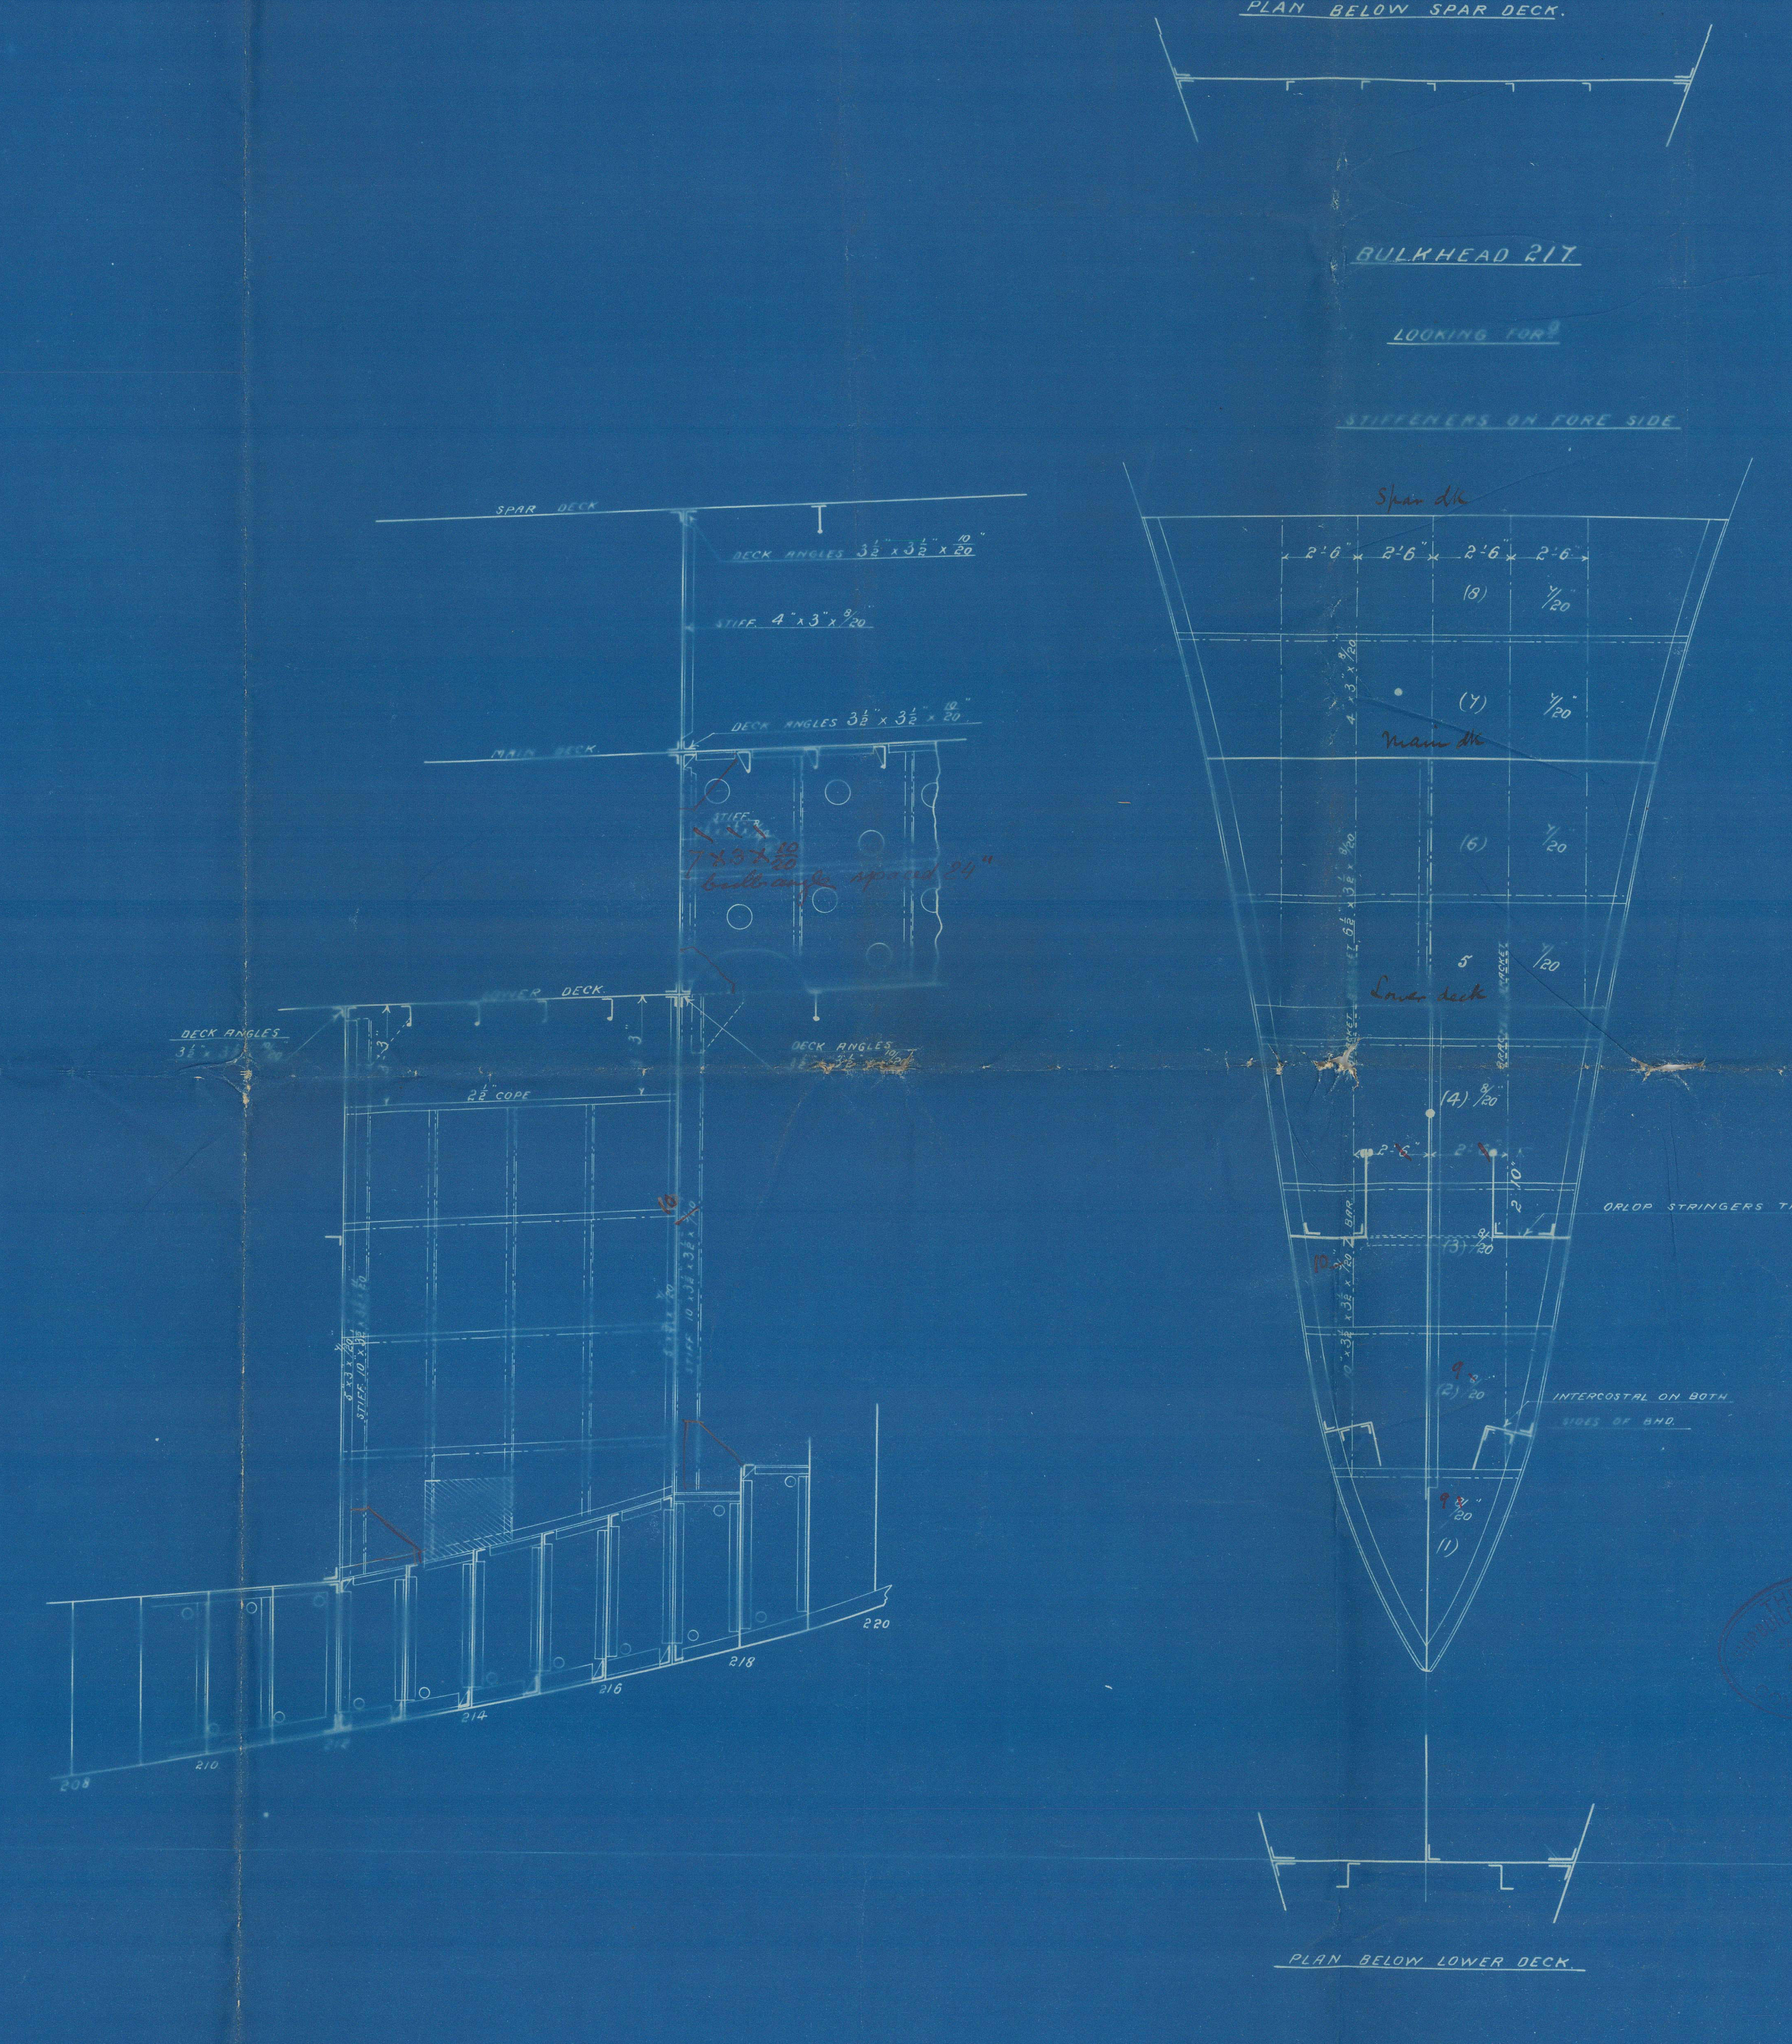



4-2-98

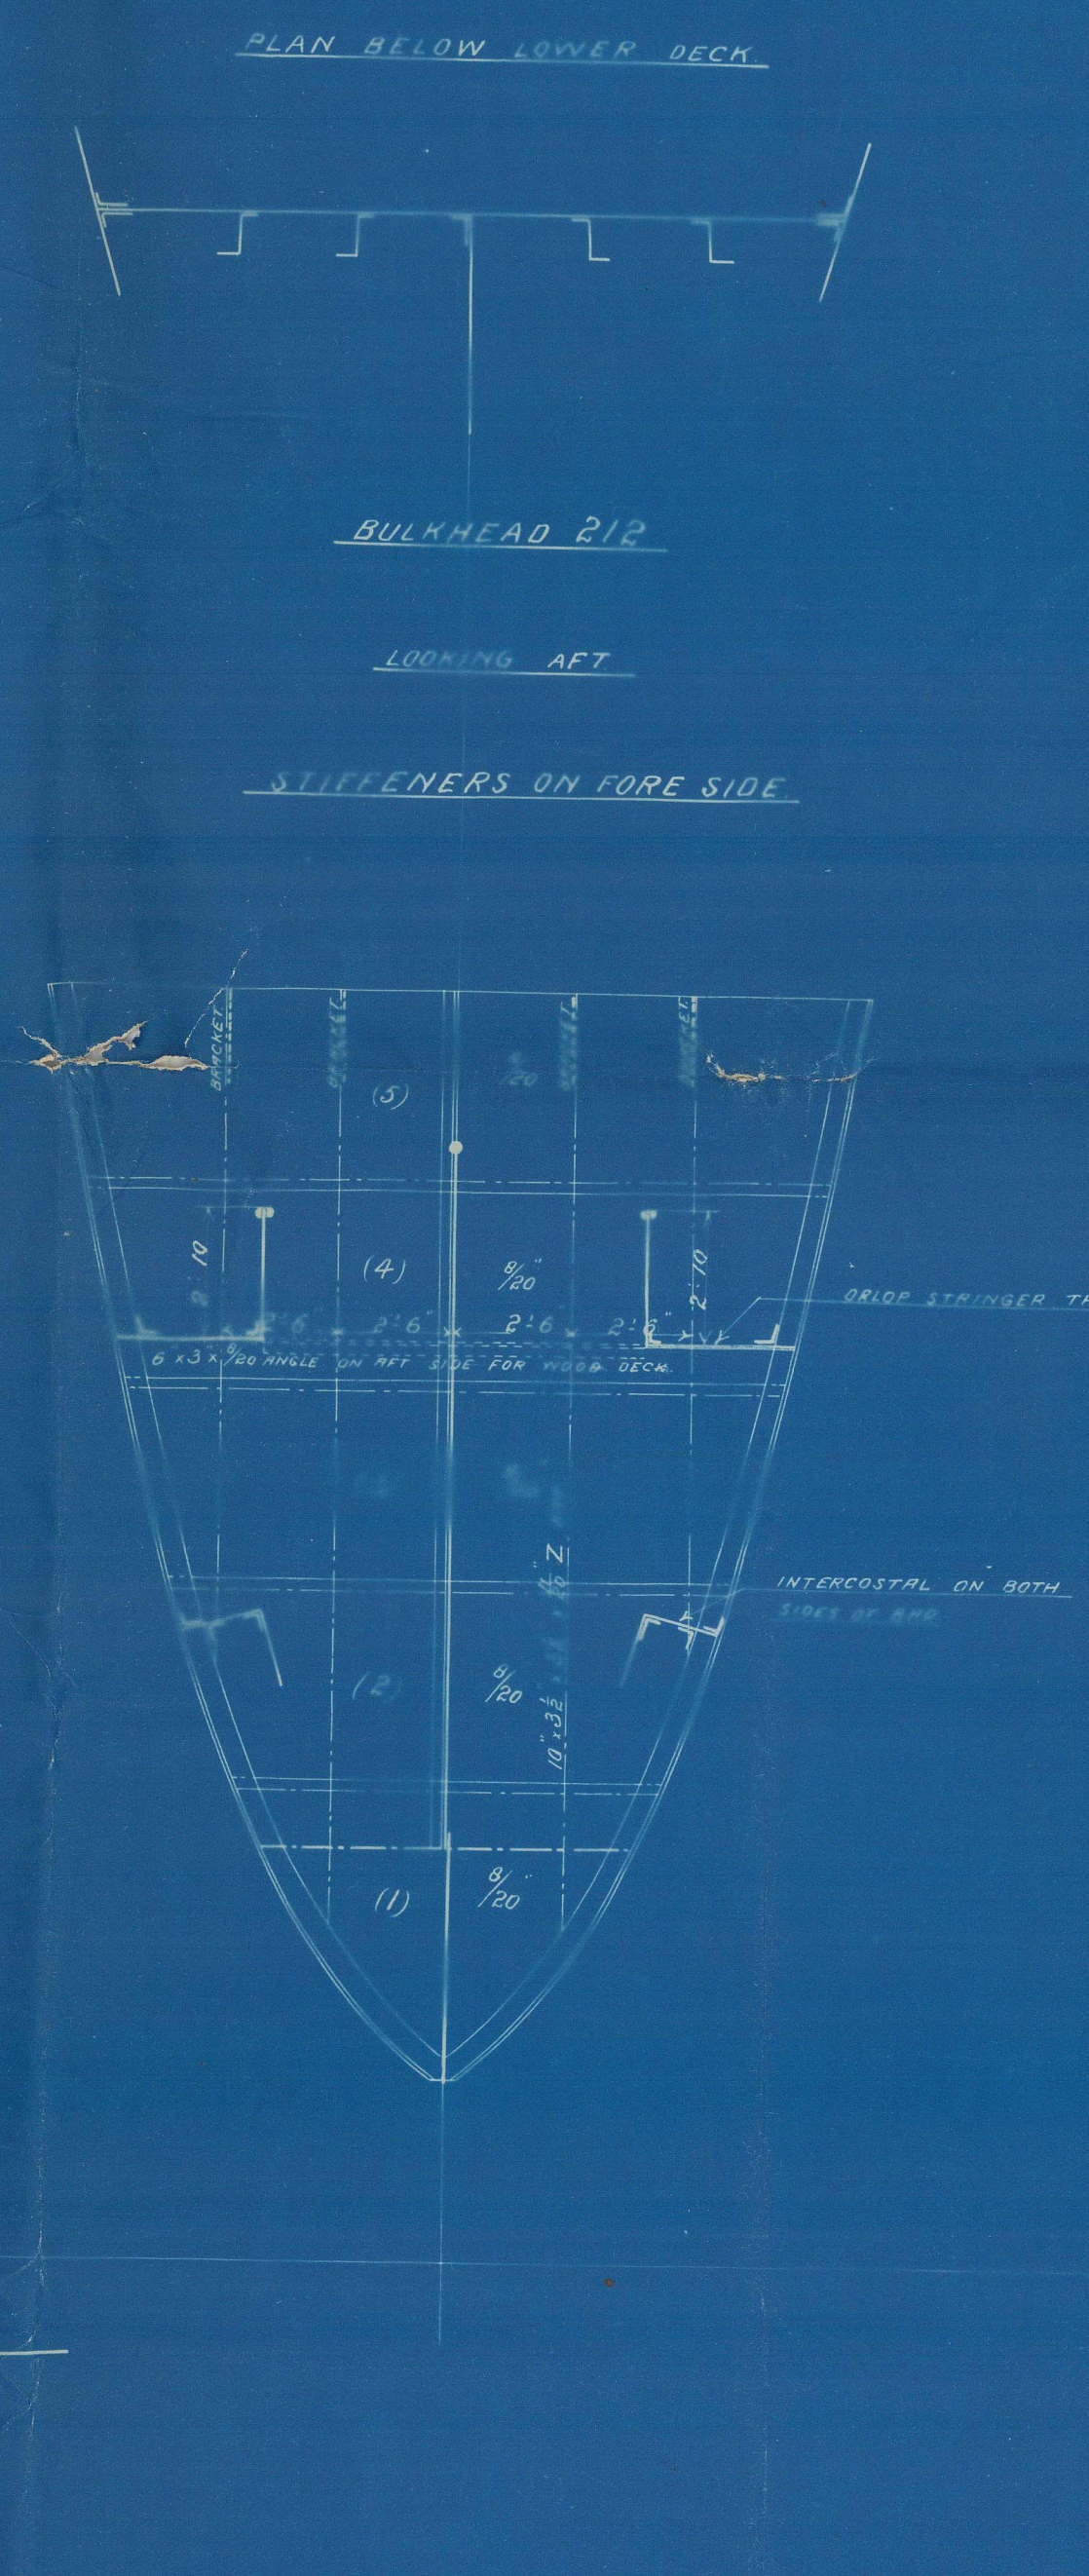

N<sup>o</sup>404  
FORE BODY BULKHEADS  
SCALE 1/4" = ONE FOOT

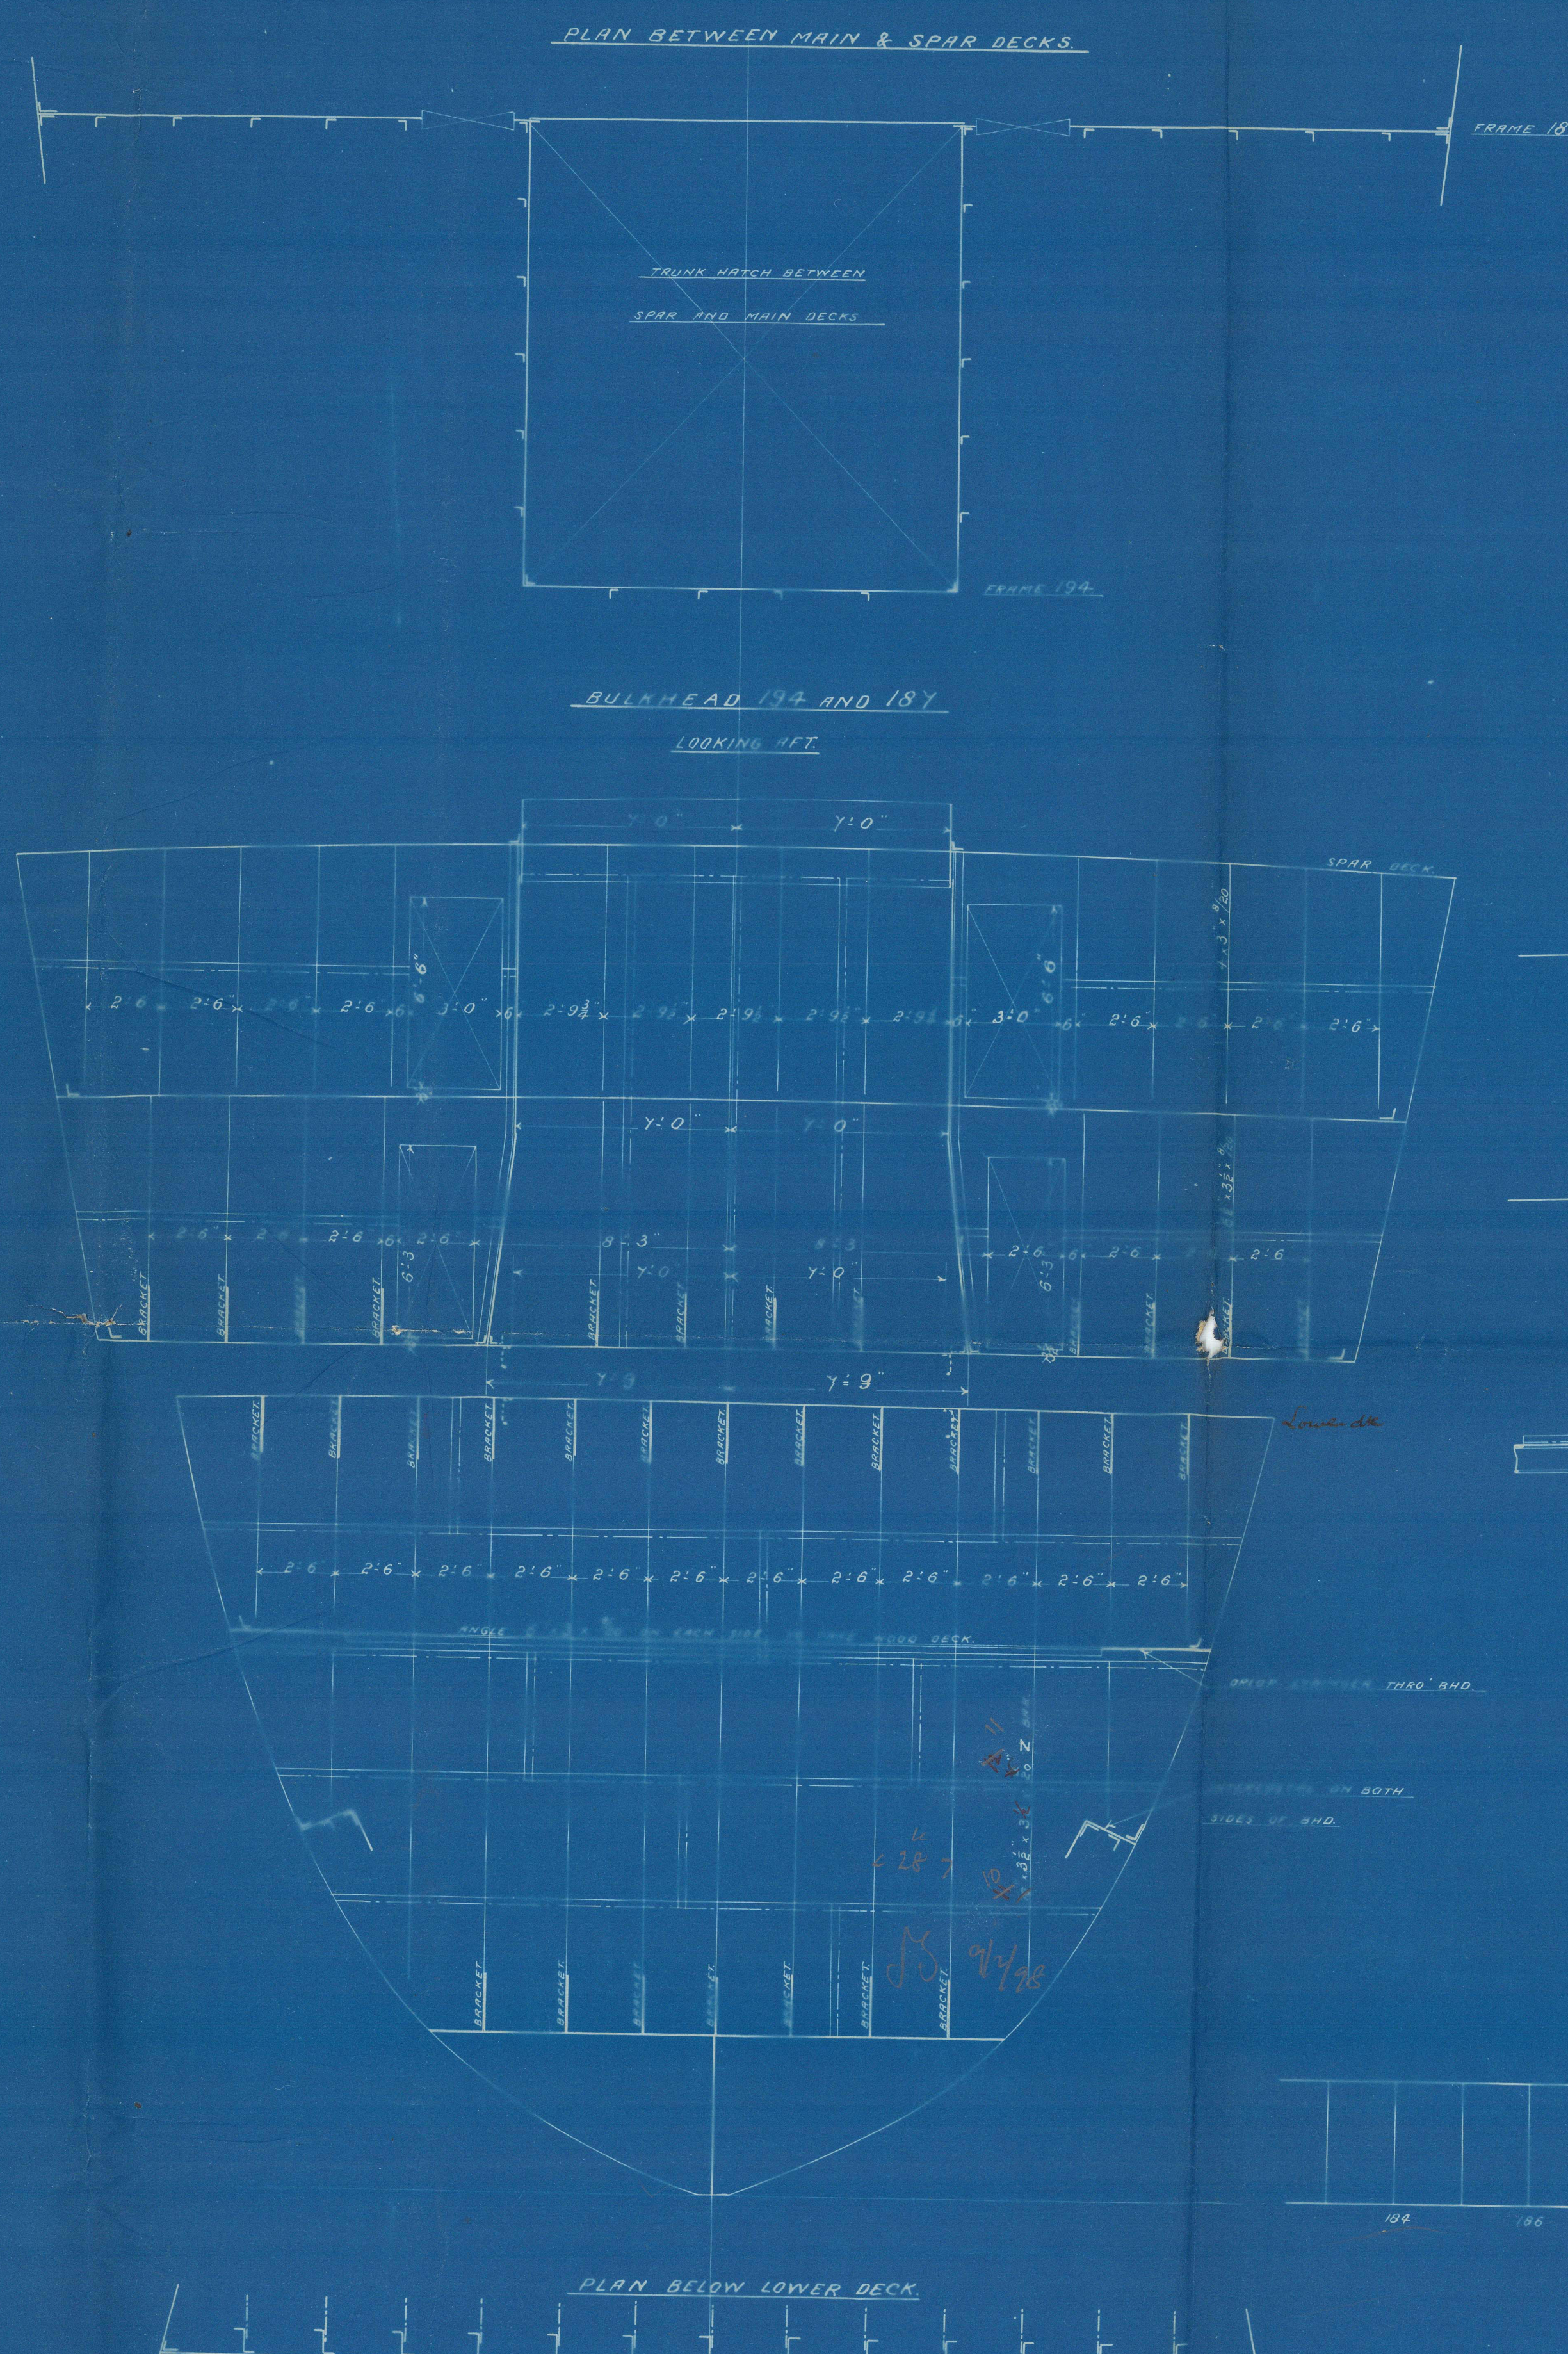

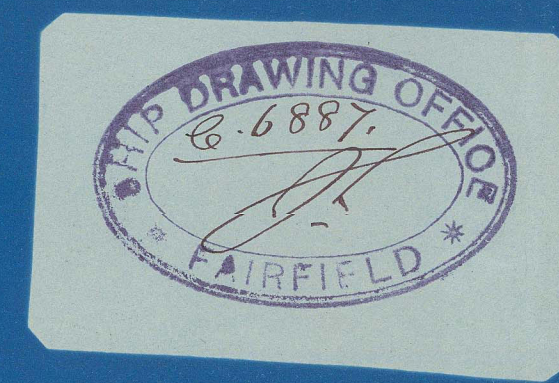

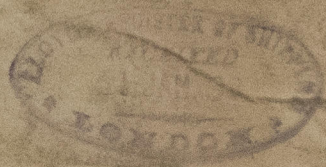

Fairfield 404

<sup>for body</sup>  
Fairfield S. S. "Omrah" to 404

S. S. "Omrah"

Glebe no 16687

GLS273 - 1064



© 2021

Lloyd's Register  
Foundation