

S. S. Maplemore

Received at

Office,

Lloyd's Register of British and Foreign Shipping.

(Report on Vessel No. 16763 Port Glasgow)

No. 5982 SHIP FORGINGS OR CASTINGS.

The words FORGINGS or CASTINGS, IRON or STEEL, should be struck out as may be required.

I have to report that the undermentioned Iron or Steel Forgings or Castings, manufactured by Messrs. Charles Connell & Co. of Glasgow. for the Vessel No. 244, being built by Messrs. Charles Connell & Co. of Glasgow. have been inspected by me as set forth below, and found to be, so far as can be seen, Sound.

Mark on Forgings.

Lloyd's


No 5982 F.C

Frank Cook.

Glasgow 3/9/98.

	STERN FRAME.	RUDDER FRAME.	STEM & keel bars
Material*		Scrap steel.	Scrap steel
How made		Forged.	Forged
Dimensions		11 1/2 x 8 3/8 x 6"	Stem 12 x 3 1/2 keel bars 10 x 2 1/2
Progress on Inspection		Forged & smithed.	Forged & machined
Date when Inspected		11/2/98 to 26/8/98. 12/11/97 to 24/3/98.	

SKETCHES OF FRAMES SHOWING POSITION AND DESCRIPTION OF WELDS OF FORGINGS, OR PARTICULARS OF TESTS APPLIED TO CASTINGS.

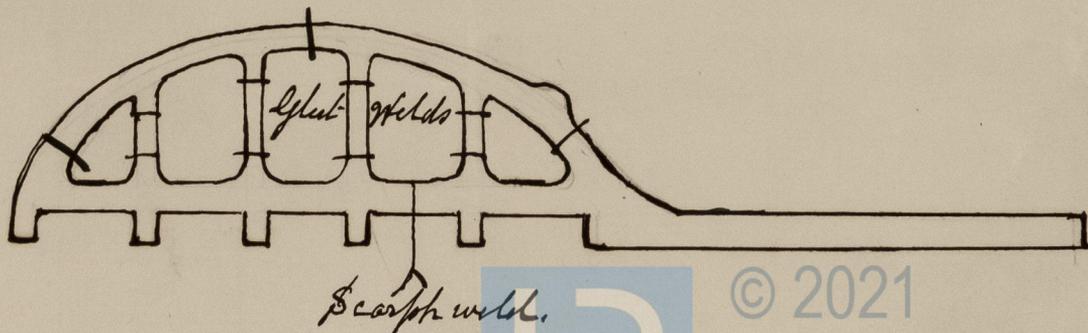

Fee (if any chargeable) £

To be paid at

