


"BETHANIA". As brill-

To Class 100 A.I. at Lloyds 3 Deck Rule

Zuvmerals 28 $57 + 57.16 + 60.41 - 7 = 119.44$ *Thwartchips*
 0° 0° 0° 0° $\times 482.41 = 576.78$ *7 Longitudinal*
 0° 0° 0° 0° $\times 482.41 = 4846.91.5$ *Equip. of*
 Proportions Depth to length to Upper Deck 12.99
 " " " Main Deck (normal Depth) 16.28
 Breadth to length 8.50

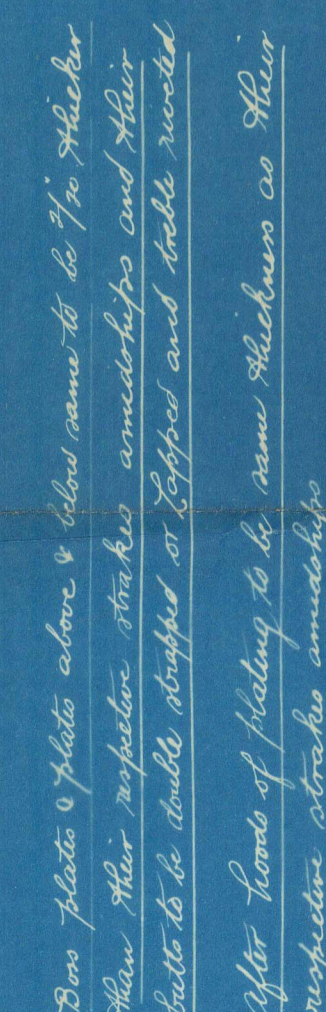



Henry A. Stephen Esq
No 380.

S.S. "Bethania"

Gls 16879.

GLS27SA



© 2021

Lloyd's Register
Foundation