
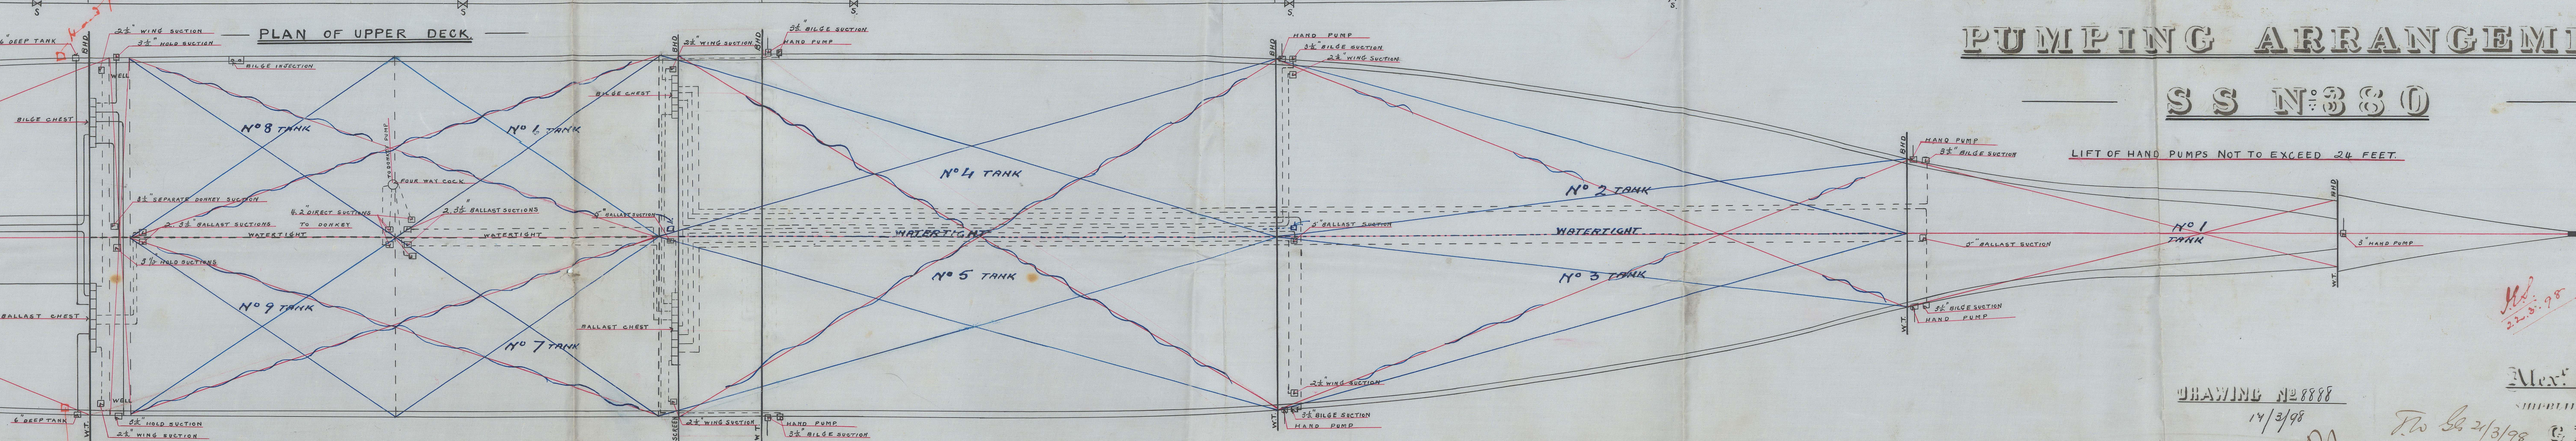


23.3.98

 

PUMPING ARRANGEMENT

SS N380


SCALE 1/4" = 1 FOOT


14/3/98

23.3.98

SHIPBUILDERS & ENGINEERS
710 Gt. St. GLASGOW

"
S/s. Bethania
"

Glasgow.

No. 16879

2/11/98



© 2021

GLS275A-0076

Lloyd's Register
Foundation