

S/S. "Bethania"

Received at

Office,

186

Lloyd's Register of British and Foreign Shipping.

(Report on Vessel No. 16879 Port Glasgow.)

No. 6142 SHIP FORGINGS OR CASTINGS.

I have to report that the undermentioned Iron or Steel Forgings or Castings, manufactured by Mess Matthew Reid & Coy of Kilmarnock for the Vessel No. 380, being built by Mess Alex & Stephen Sloan of Glasgow have been inspected by me as set forth below, and found to be, so far as can be seen, Sound & efficient


Mark on Forgings.

Lloyd's No. 6142 W.H.

William Hamilton Glasgow 30/6/98

Table with 3 columns: STERN FRAME, RUDDER FRAME, STEM. Rows include Material* (Scrap iron), How made (Forged), Dimensions (13 1/2 x 8 1/2), Progress on Inspection (Forging & smithing), Date when Inspected (7/1/98 to 27/6/98).

SKETCHES OF FRAMES SHOWING POSITION AND DESCRIPTION OF WELDS OF FORGINGS, OR PARTICULARS OF TESTS APPLIED TO CASTINGS.

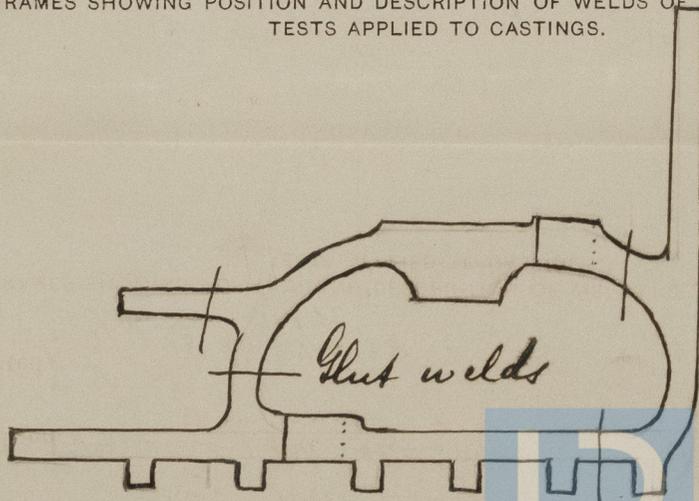

Fee (if any chargeable) £ : :

To be paid at

© 2021

Lloyd's Register Foundation

* If of Iron, state whether scrap or puddled Iron.