

25.3.98  
20.4.98

21623


**Nº 4-65**

ARRANGEMENT OF BEAMS, BULKHEADS, &c.

BUILDERS DIMENSIONS 340'0" x 42' x 30'0"

SCALE 1/8" INCH = 1 FOOT

22/3/98

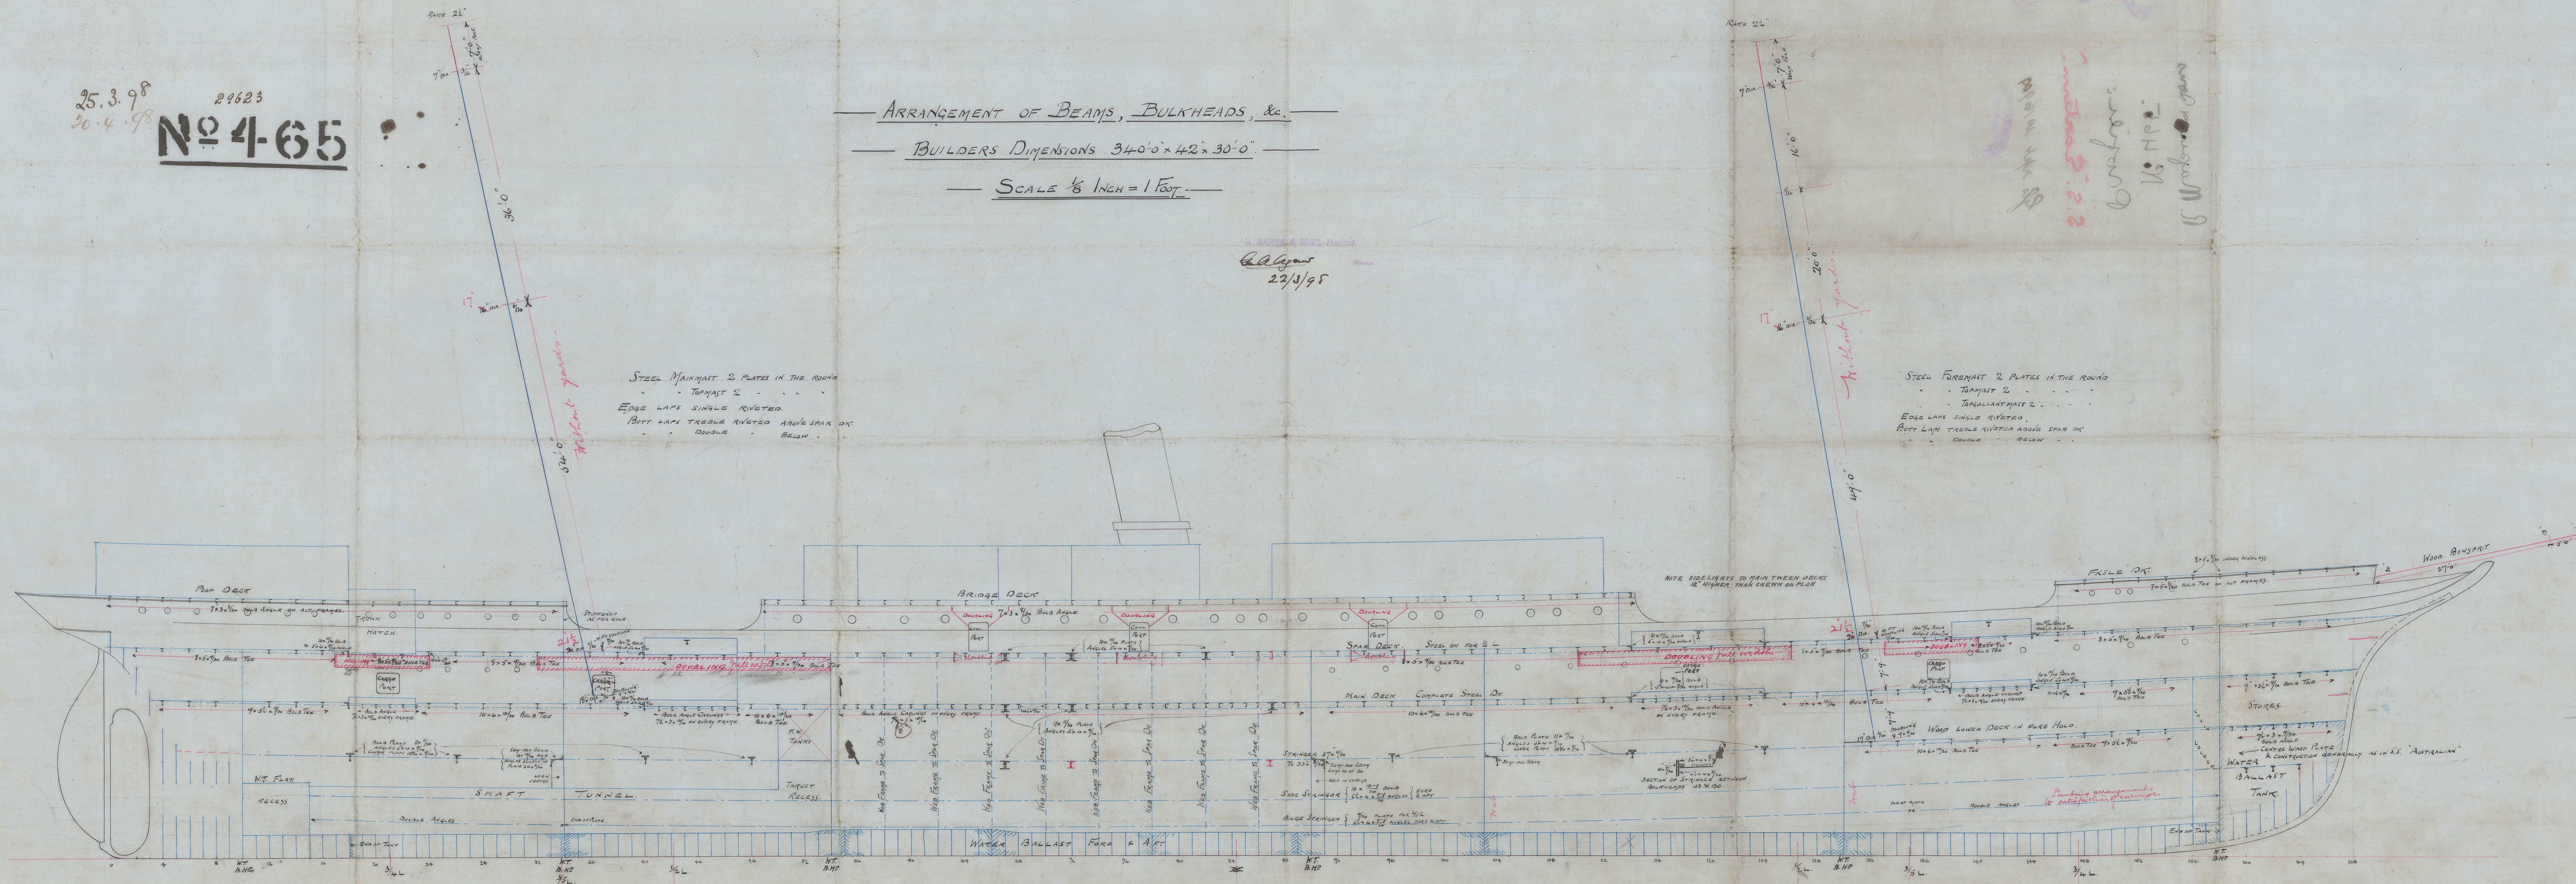

25/3/98








R. Maxine & Sons

N. 465.

Profile.

S.S. Eastern

Gls rpt 10/6909

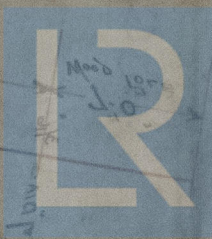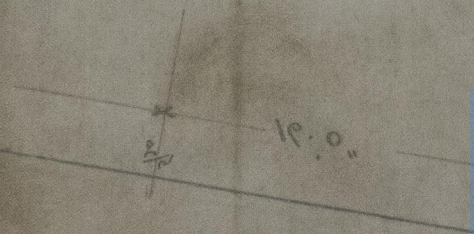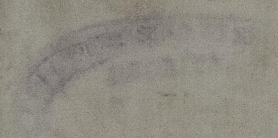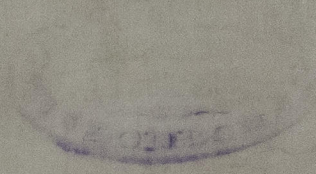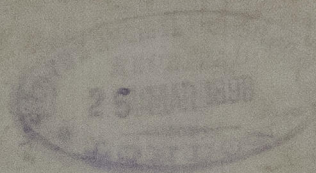

© 2021

Lloyd's Register  
Foundation

GLS276-0063