

29622  
N<sup>o</sup> 4-65

MIDSHIP SECTION


OF A  
STEEL SINGLE SCREW STEAMER

TO CLASS 100 A.I. SPAR DECK AT LLOYDS SPECIAL SURVEY.

BUILDERS DIMENSIONS 340'-0" x 42'-0" M<sup>o</sup> x 30'-0" AT LOWEST POINT.

SCALE 1/2" = 1 FOOT.

25.3.98  
10.4.98  
13.6.98  
22/3/98

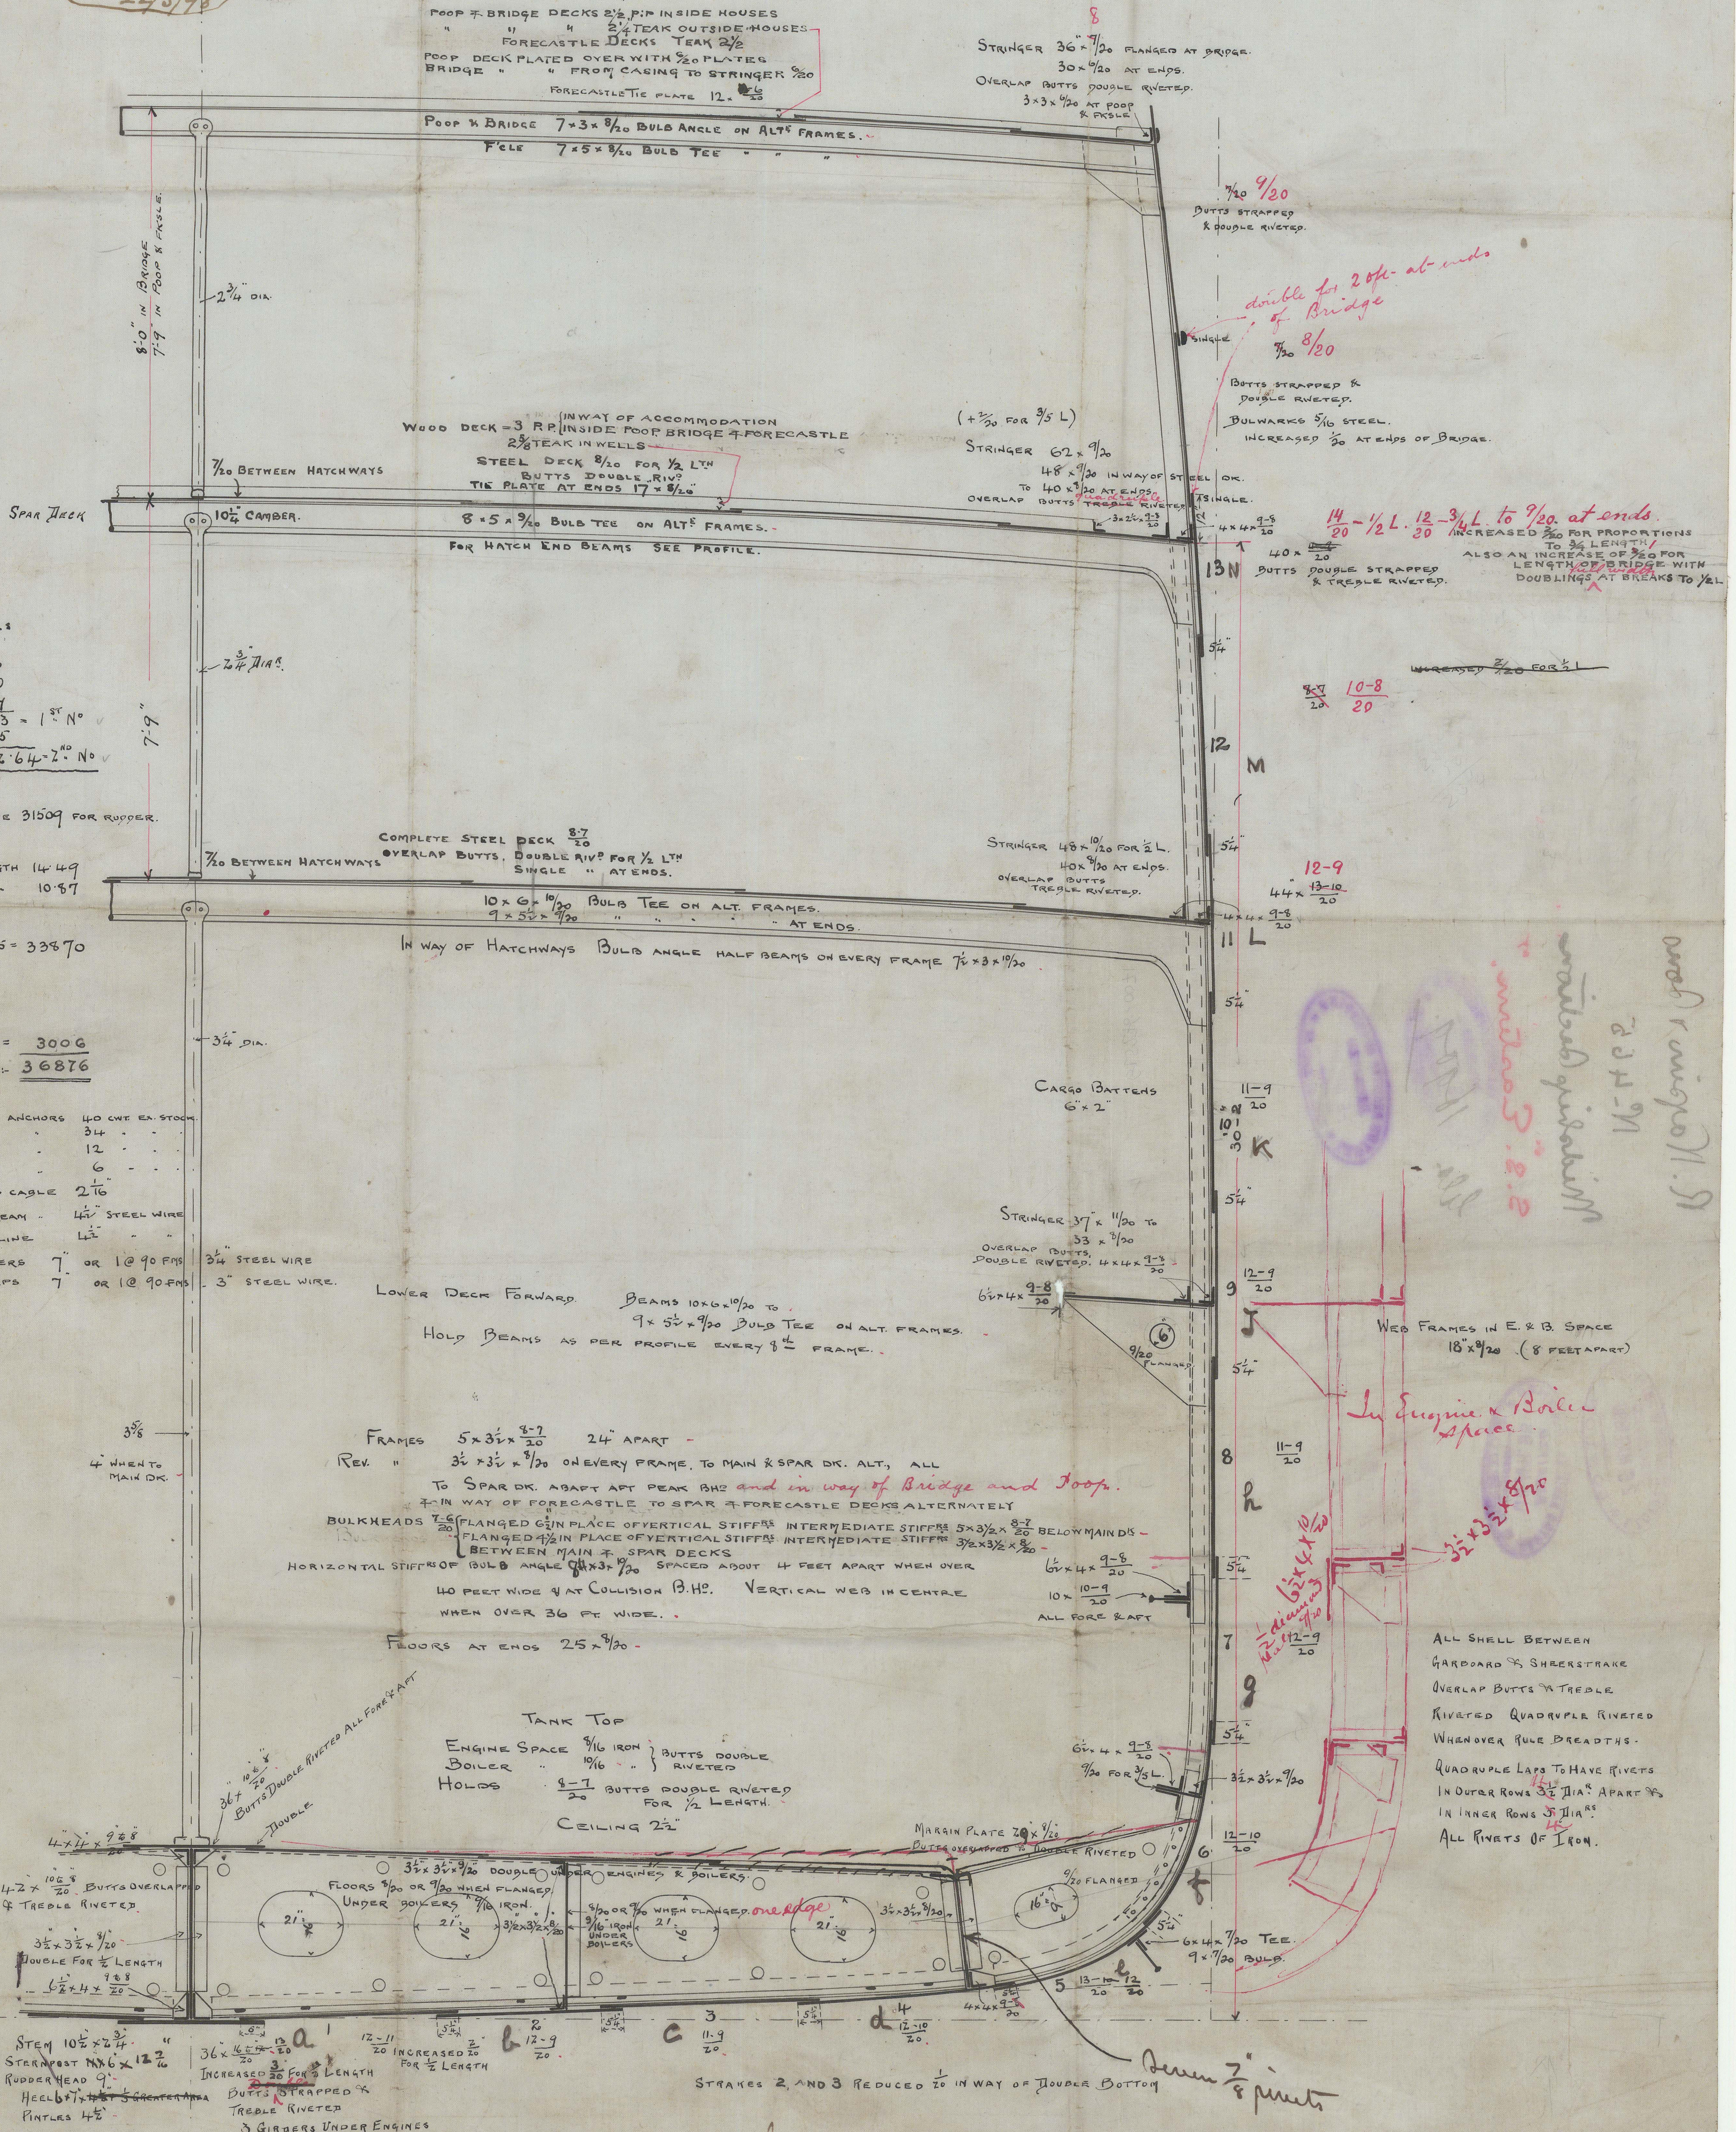

25/3/98




R. Napier & Sons

N<sup>o</sup> 465

Midship Section

S.S. "Eastern."

Dec. 1890.

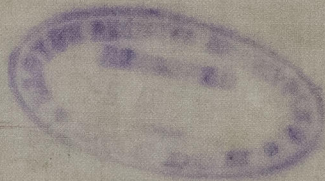

© 2021

Lloyd's Register  
Foundation

GL5276-0071