

PROFILE IN E & B SPACE

S. S. No. 363

SCALE 1/4 INCH = ONE FOOT



See plan on light

March 10/5/98

12.4.98
13.6.98

GALLEY
STEERING GEAR.

SADDLE
BACK
COAL
HATCH.

DONKEY
BOILER

AIR
HATCH.

BRIDGE DK

SPAR DECK

MAIN DECK

HEAVY BEAMS 12" x 3/4" PLATE
6" x 4" x 3/4" ANGLES

SCREEN D.P.

1ST STRINGER

2ND STRINGER

3RD STRINGER

ENGINE SPACE

BOILER SPACE

W.T.B.H.

WEB FRAME

WEB FRAME

W.T.B.H.

TOP OF TANK


20/6
9/4/98



363



Strong beams
web frames
in R & B space

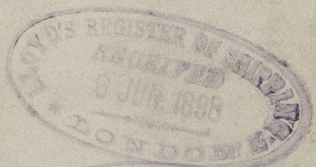

A. Mc Millan & Co.
No. 363 5/8 'Canadia'

fls Rpt No. 17024

No. 369.

5/8 'Lord Roberts'.

Glsrpt. No. 14840.

645277-0063



© 2021

Lloyd's Register
Foundation