


NOTE: HOLD & TANK SOUNDING PIPES 1 1/4" DIA.  
 TANK AIR PIPES 2" DIA.  
 HAND PUMP TAIL PIPES 2 1/2" DIA. CHAMBER 5" DIA.  
 LIFT OF HAND PUMPS NOT TO EXCEED 24 FEET.

# PUMPING PLAN. S. S. N<sup>o</sup> 363

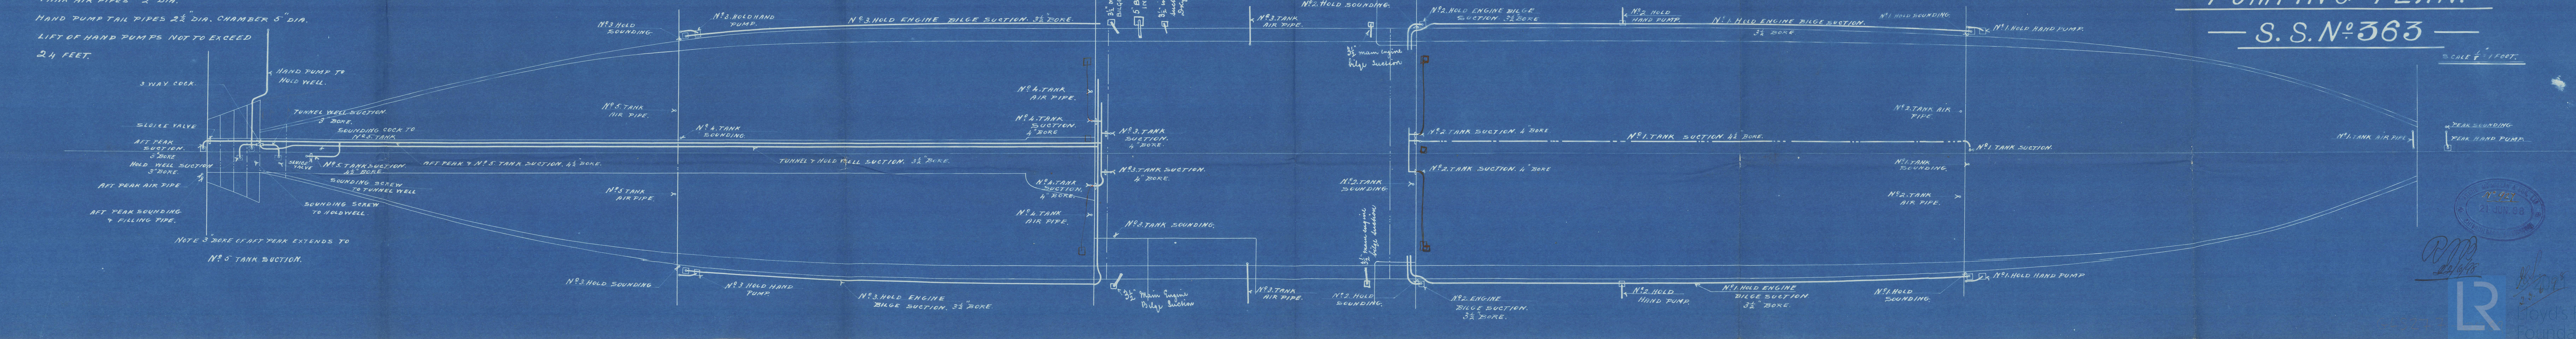

RMP  
 24/6/08







Pipini

s/s. "Canadia"

A. Mc Millan Sons'

No. 363

Glb Rpt No. 17034

a. Mc Millan Sons 369.

s/s "Lord Roberts"

Glb rpt No. 14840.

GLS277 - 0069



© 2021

Lloyd's Register  
Foundation