


**— MAST PLAN —**  
**— STEEL SCREW STEAMER —**  
**— N<sup>o</sup> 383 —**

24.2.99



**NOTE:** ALL FOUR MAST TO HAVE 3 PLATES IN ROUND  
 LANDINGS ALL SINGLE RIVETED  
 HEELS TO BE SUFFICIENTLY STRENGTHENED.  
 MAIN & MIZEN MASTS INCREASED  $\frac{3}{16}$  IN LIEU OF  
 FITTING ANGLE STIFFENERS

*Shling at Rounds*

22' 0" TO TANK TOP

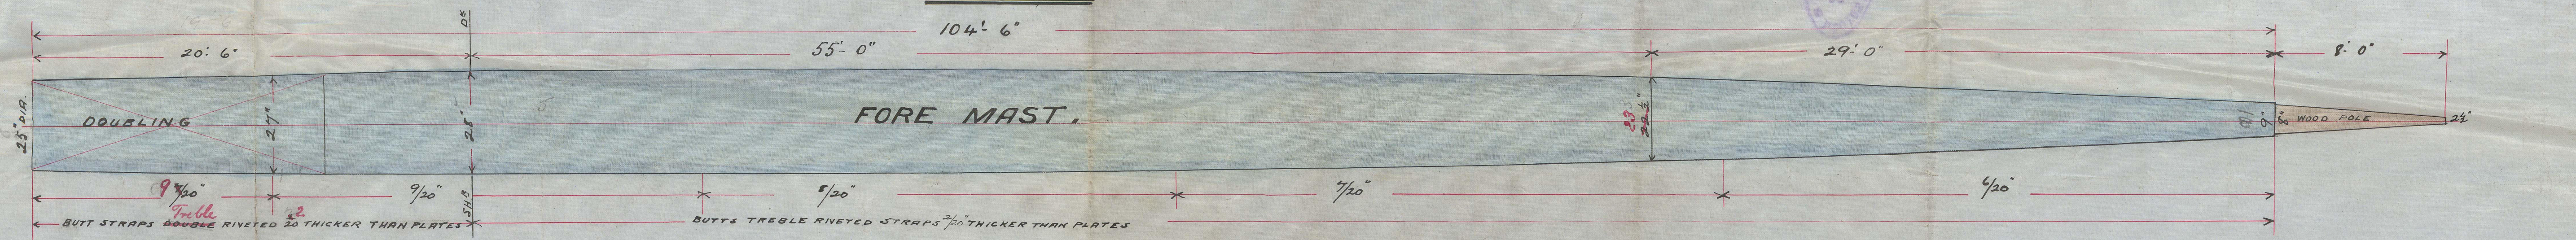

19' 0" TO TANK TOP

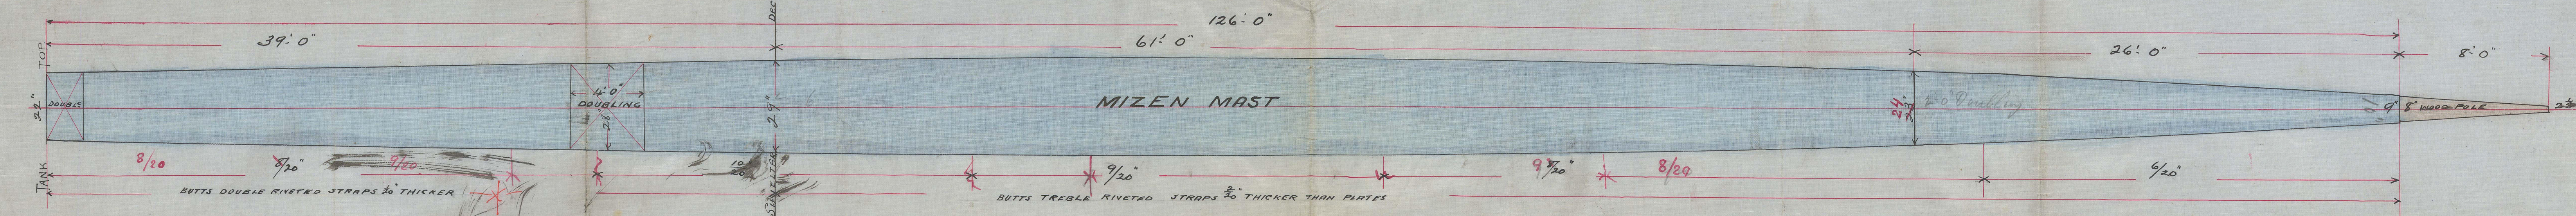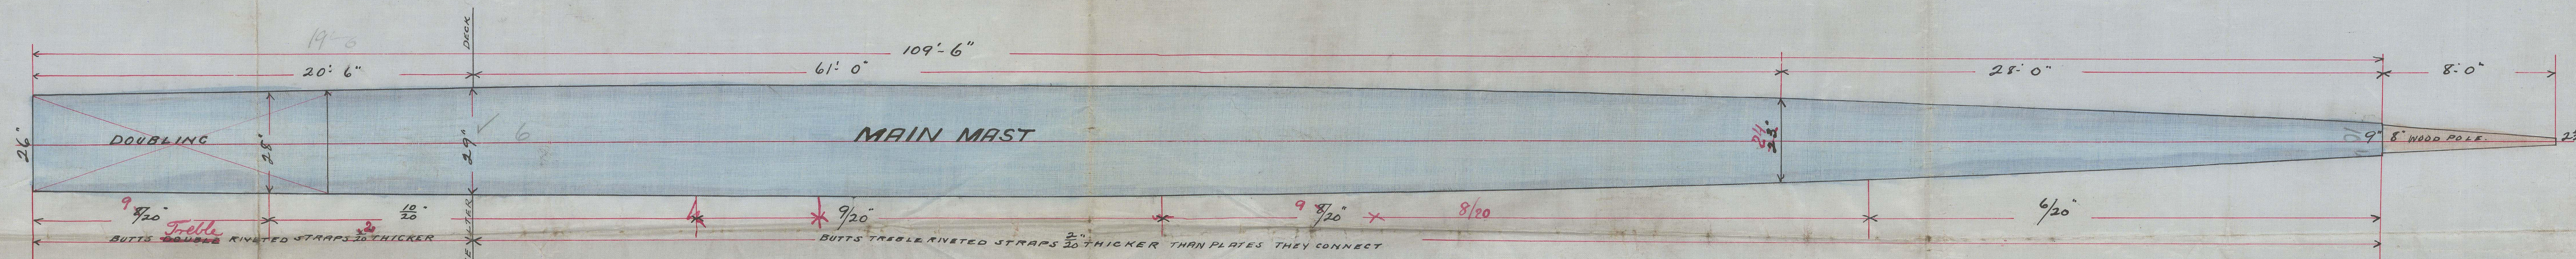

**Alexr Stephen & Sons**  
 SHIPBUILDERS & ENGINEERS  
 GLASGOW

DRAWING NO 9474

21/2/99

© 2021  
 Lloyd's Register  
 Foundation



*St. Montizuma*

*Glasgow report*

*No. 17324.*

STEEL SCREW STEAMER  
TAMM

GLS280-0044



© 2021  
Lloyd's Register  
Foundation