
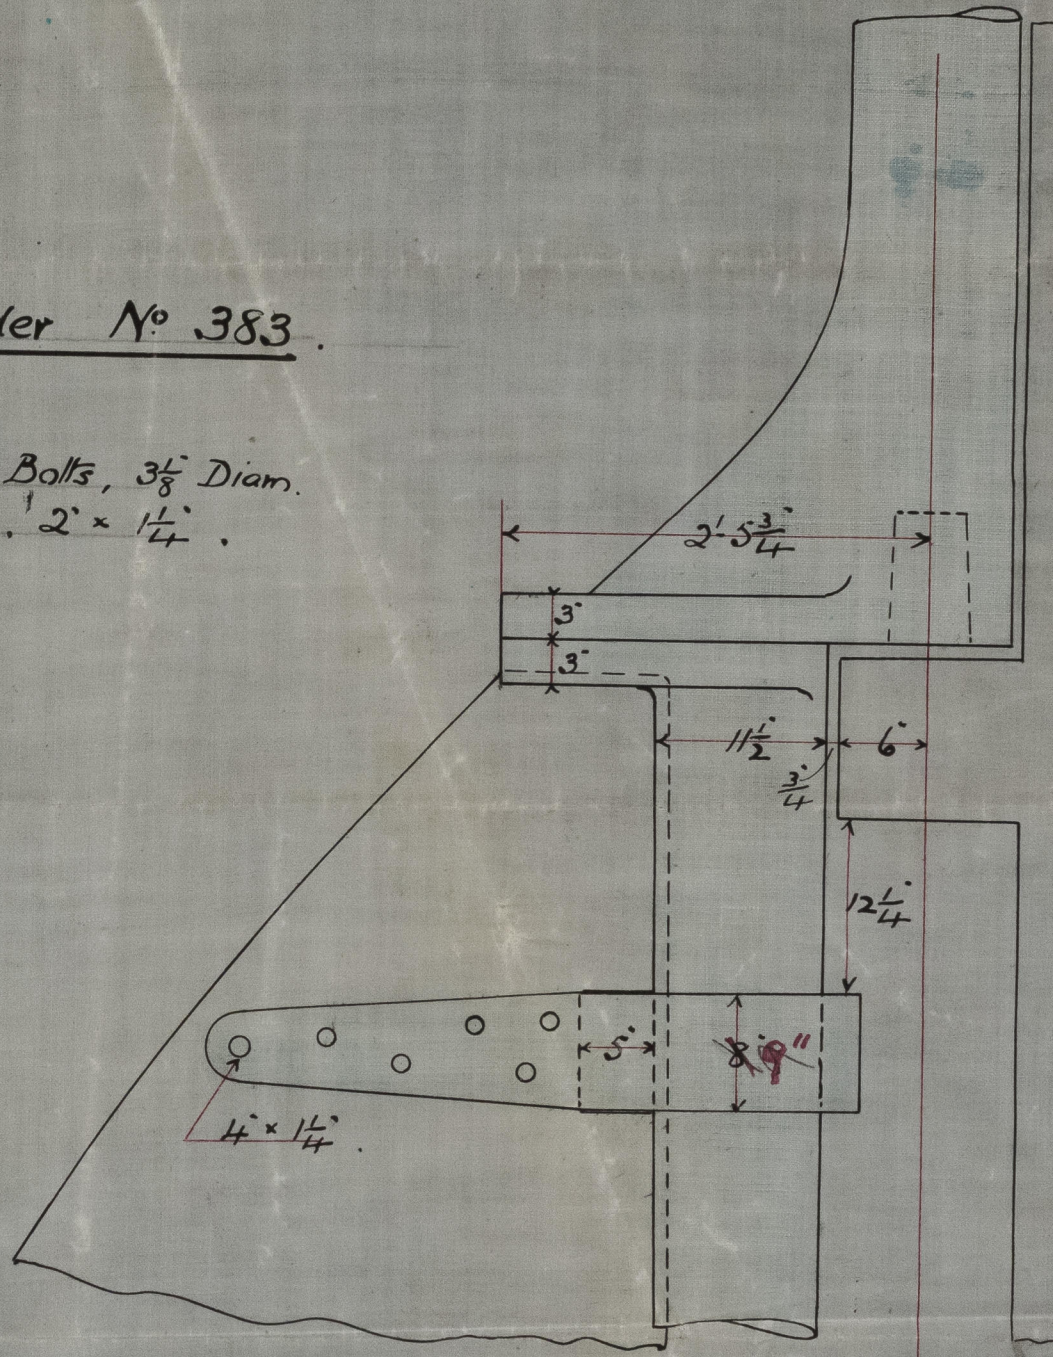
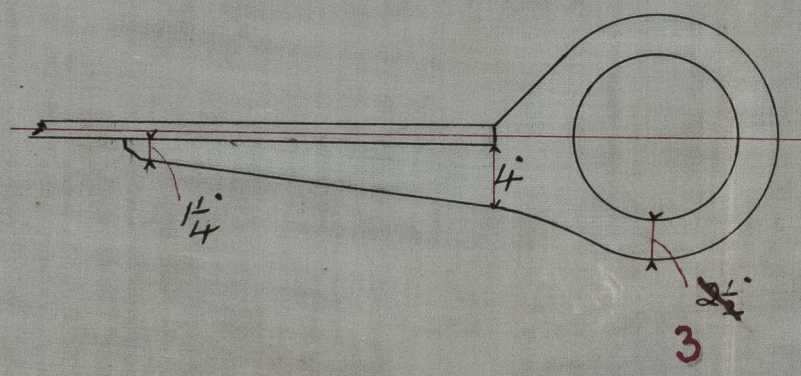


14.11.98

Alteration to Rudder No 383.

Coupling. 6 Bolts, $3\frac{1}{8}$ " Diam.
Key: $2 \times 1\frac{1}{4}$ "

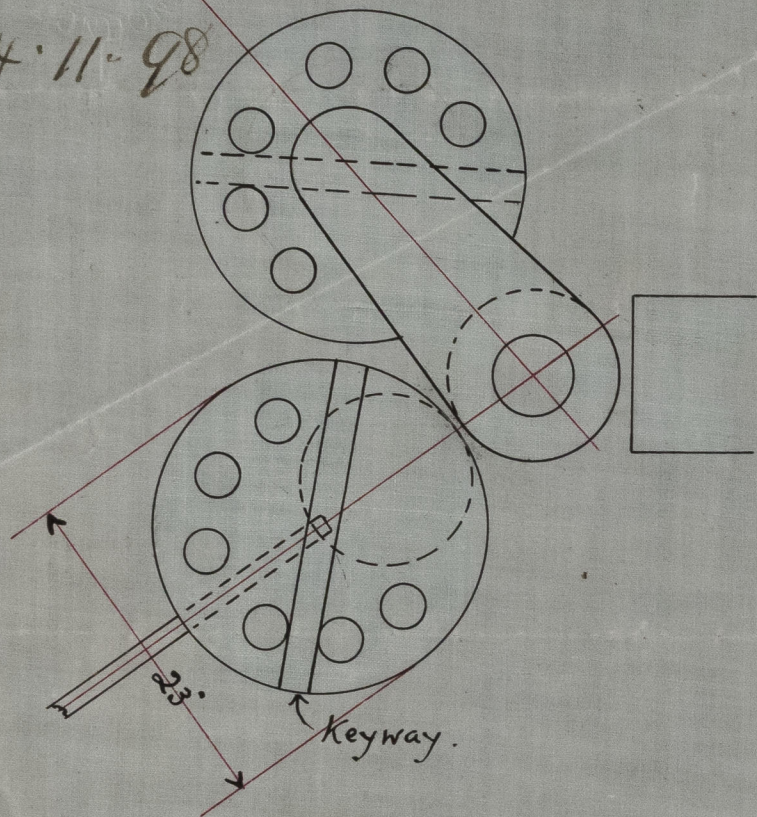




Alexs Stephen & Sons
SHIPBUILDERS & ENGINEERS
GLASGOW

DRAWING N 9275
11/11/98 JLG

SCALE 1 INCH TO 1 FOOT

JLG
14/10/98

645280-004

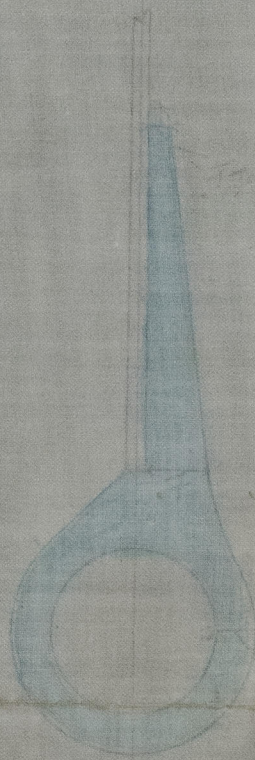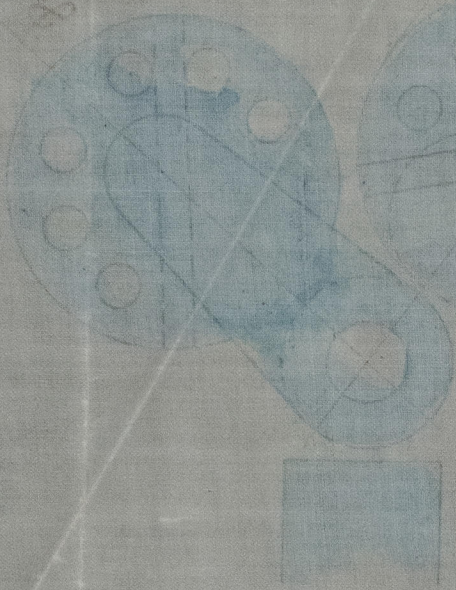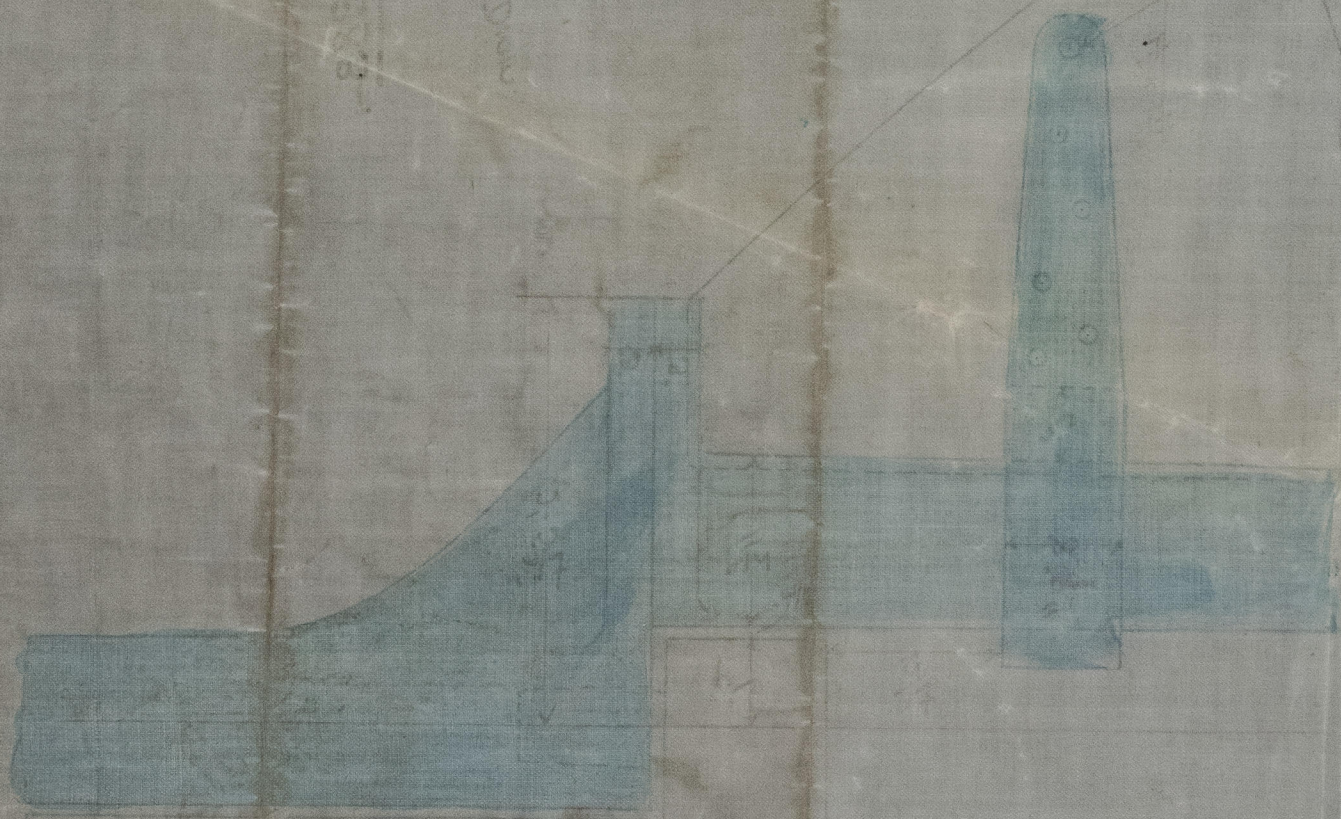









© 2021

Lloyd's Register
Foundation