

MIDSHIP SECTION
TWIN SCREW STEAMER
"MONTEZUMA" - Crossed out
Nº 383
TO CLASS 100 A1 AT LLOYDS 3 DECK RULE

Lloyd's Register
Foundation


Stephen & Sons 383

Frid Dec

A Stephen & Sons

No. 383 S/S. "Montezuma"

Sls. Rpt. No. 17324.

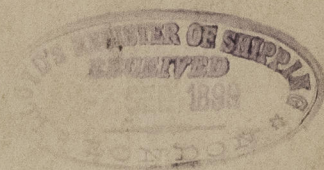

8400-082579



© 2021

Lloyd's Register
Foundation