
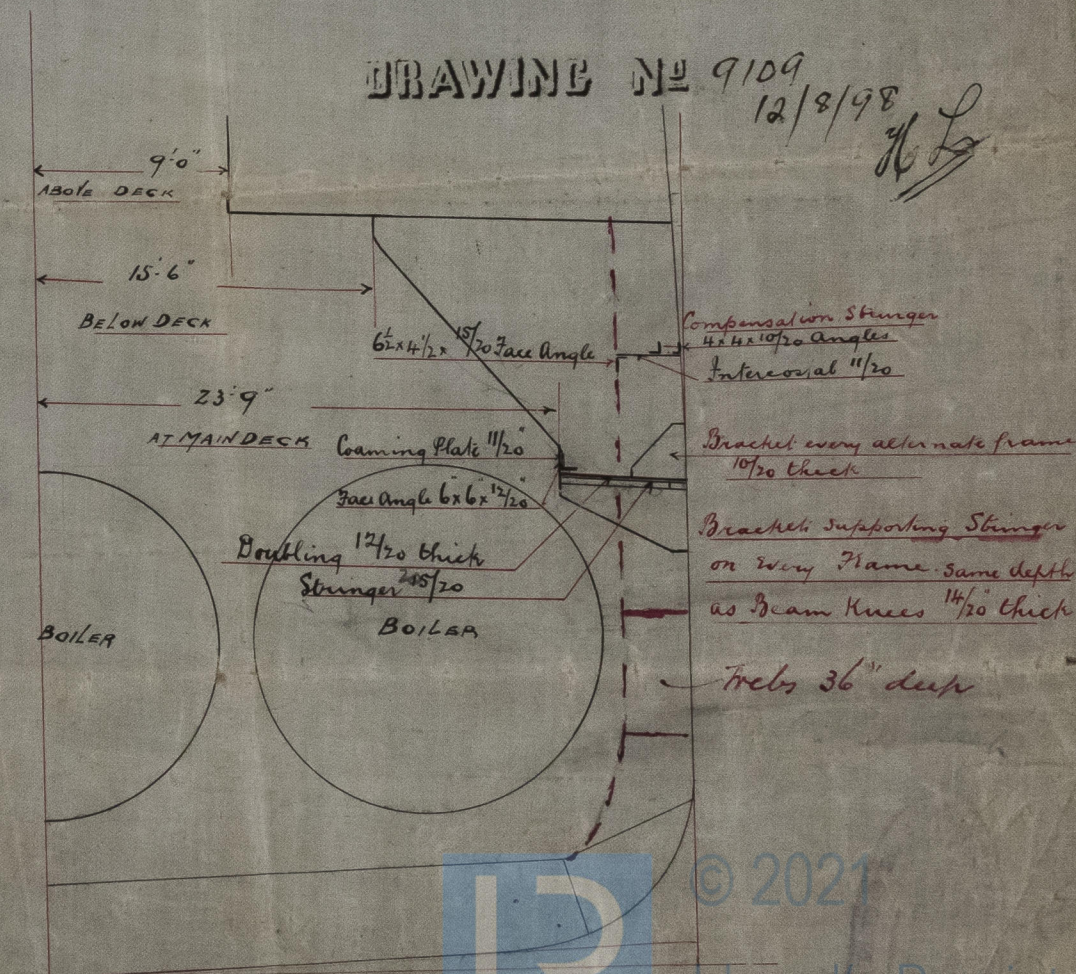


Plan showing Strong Beams in E & B space, also Breadth of Opening
at Main Deck for length of Boiler space. S. S. No 383
Scale $\frac{1}{8}$ - 1 Foot.

Alexr Stephen & Sons
SHIPBUILDERS & ENGINEERS
GLASGOW

DRAWING No 9109
12/8/98

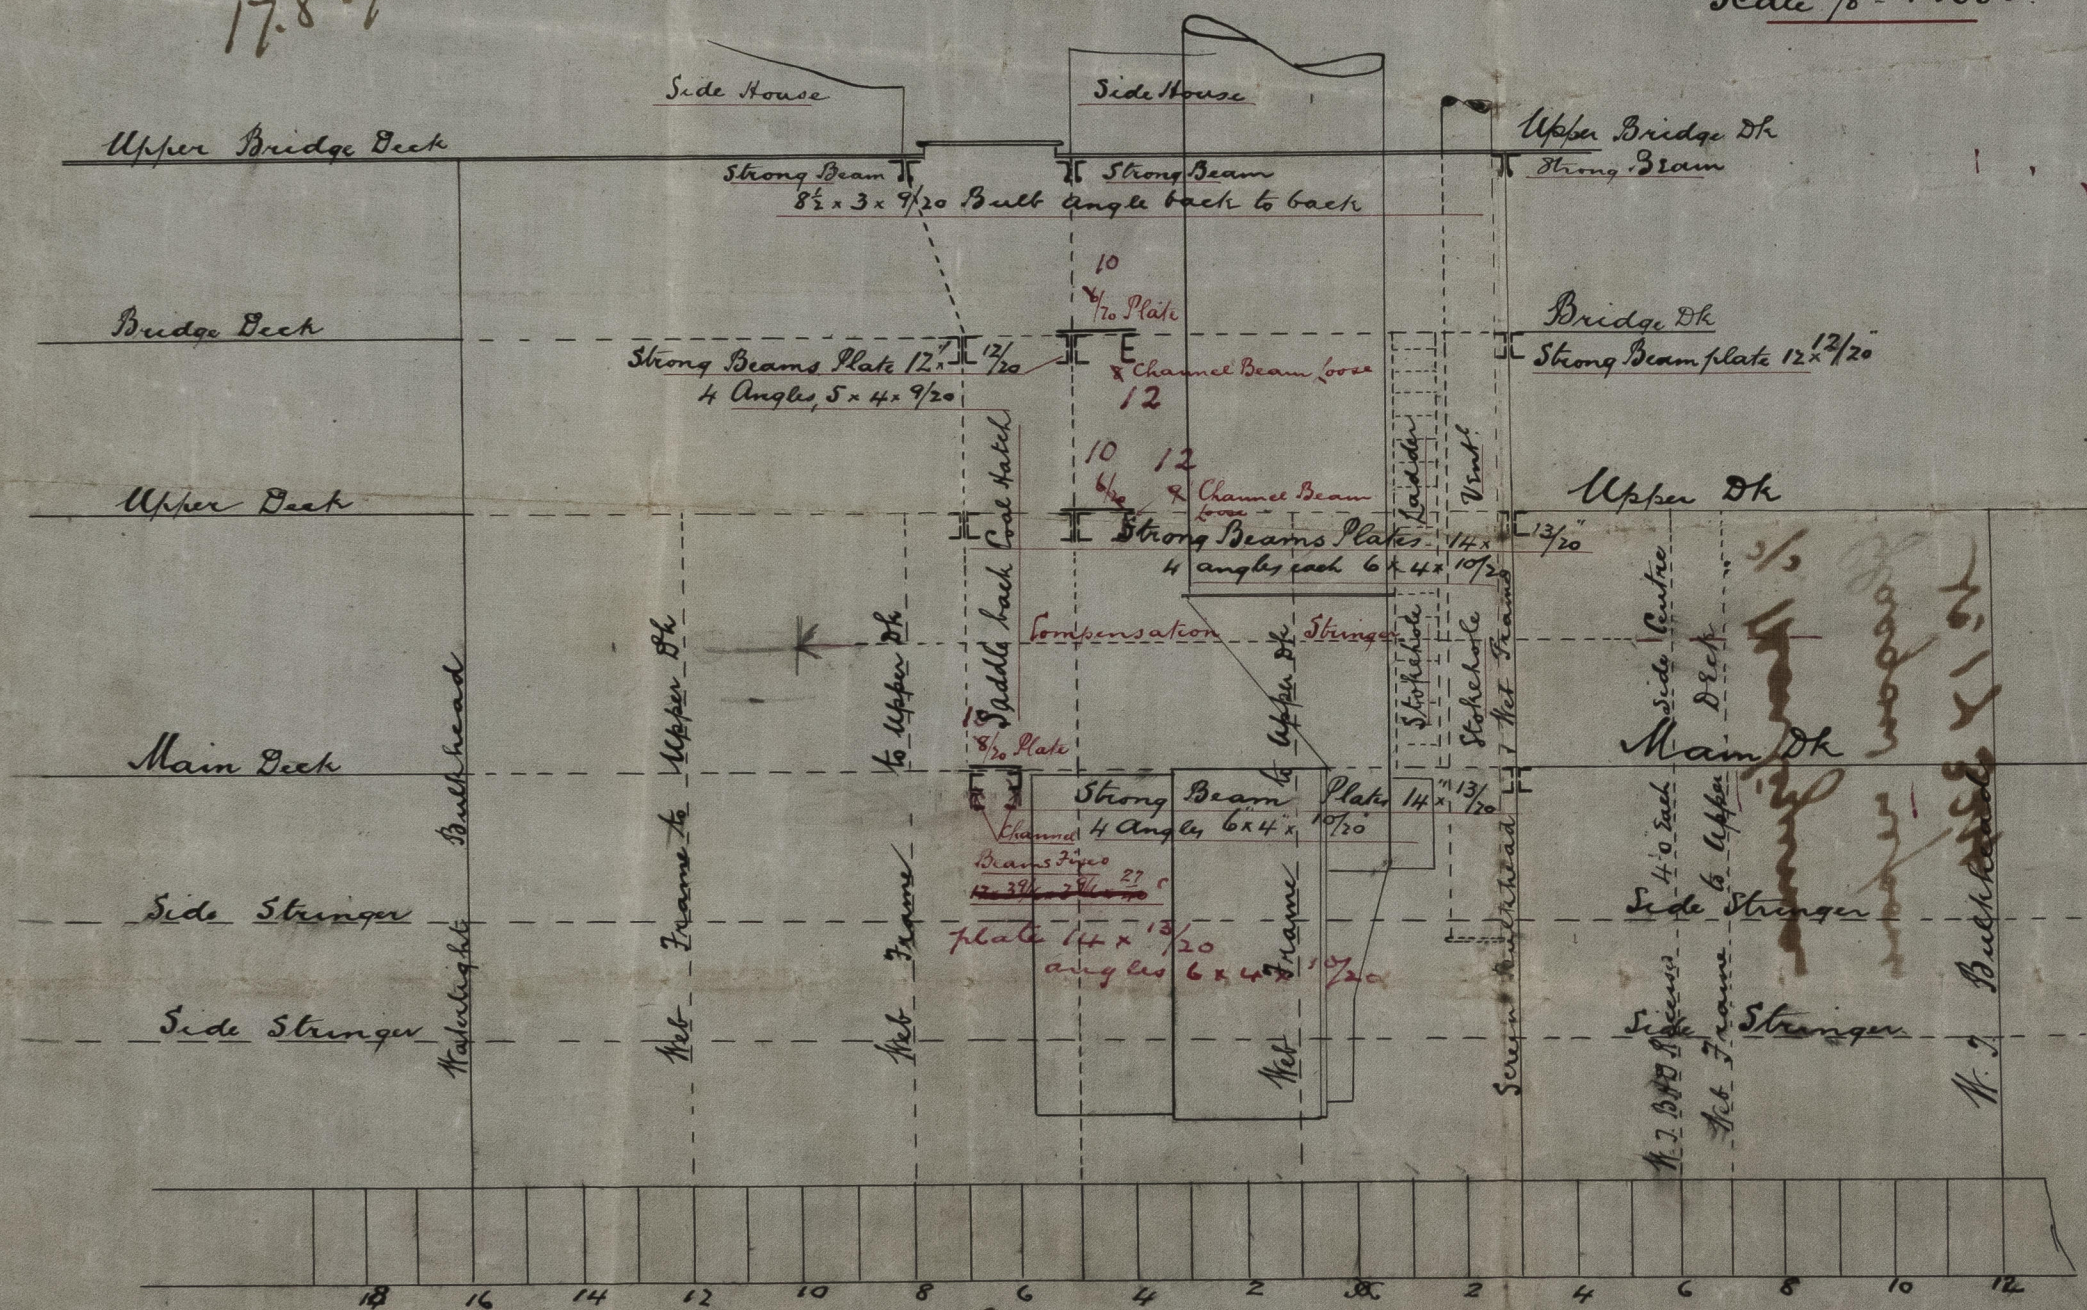

Section in way of Boilers
Showing Opening at Main Deck

2/3 Montizuma
Glasgow report
10/17/324

© 2021

Lloyd's Register
Foundation

645280-0050