



26.10.98

 


SCALE 1/4" TO 1 FOOT

 

PUMPING PLAN Nº 383.

Alex. Stephen & Sons
SHIPBUILDERS & ENGINEERS
GLASGOW
DRAWING Nº 9225
20/10/98
26.10.98

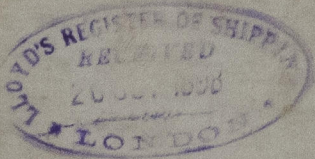

5/ Montizuma
Glas-gow report
No 17324

NO 8 JAN

TANK



© 2021

Lloyd's Register
Foundation

GLS280-0054