


Handwritten: 1832
Gladstone

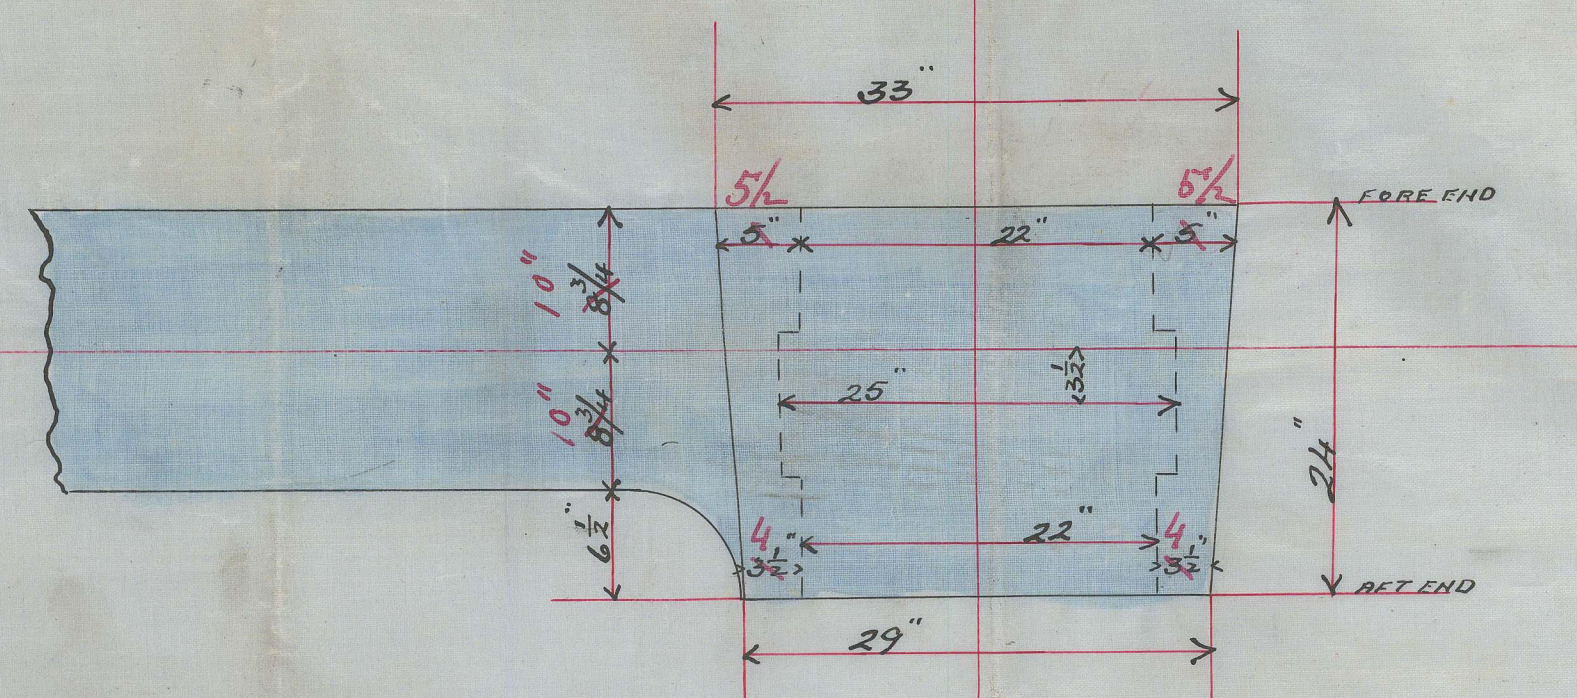


N^o 383

4/7/98 H.L.

5%
S Montyuma

Glasgow report.

No 17324

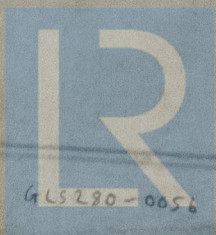

© 2021

Lloyd's Register
Foundation