
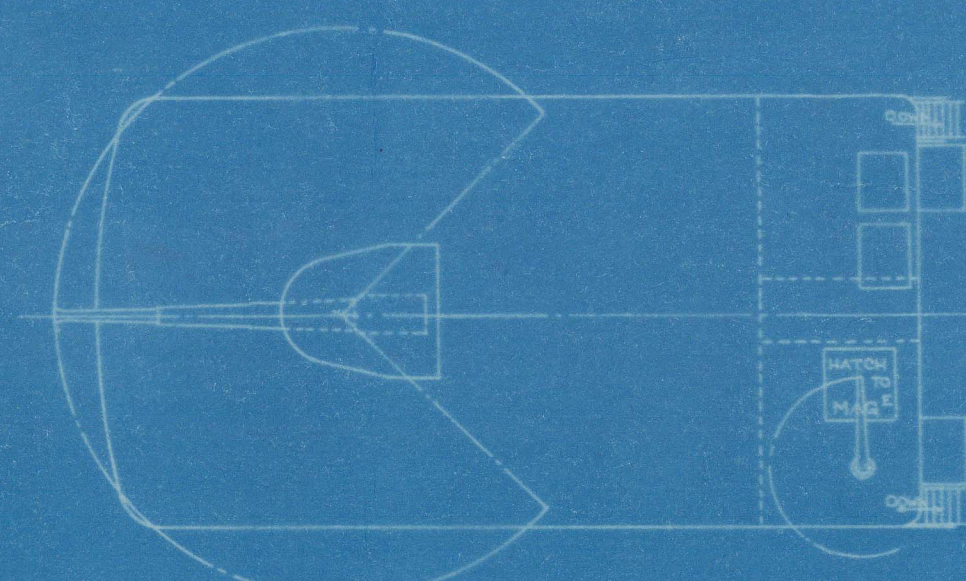



22/8/16

# H.M.S. "ABADOL". ELECTRIC LIGHT & MAINS PLAN.


SCALE 1/8" = ONE FOOT.

 

TOP OF STEERING GEAR HOUSE.

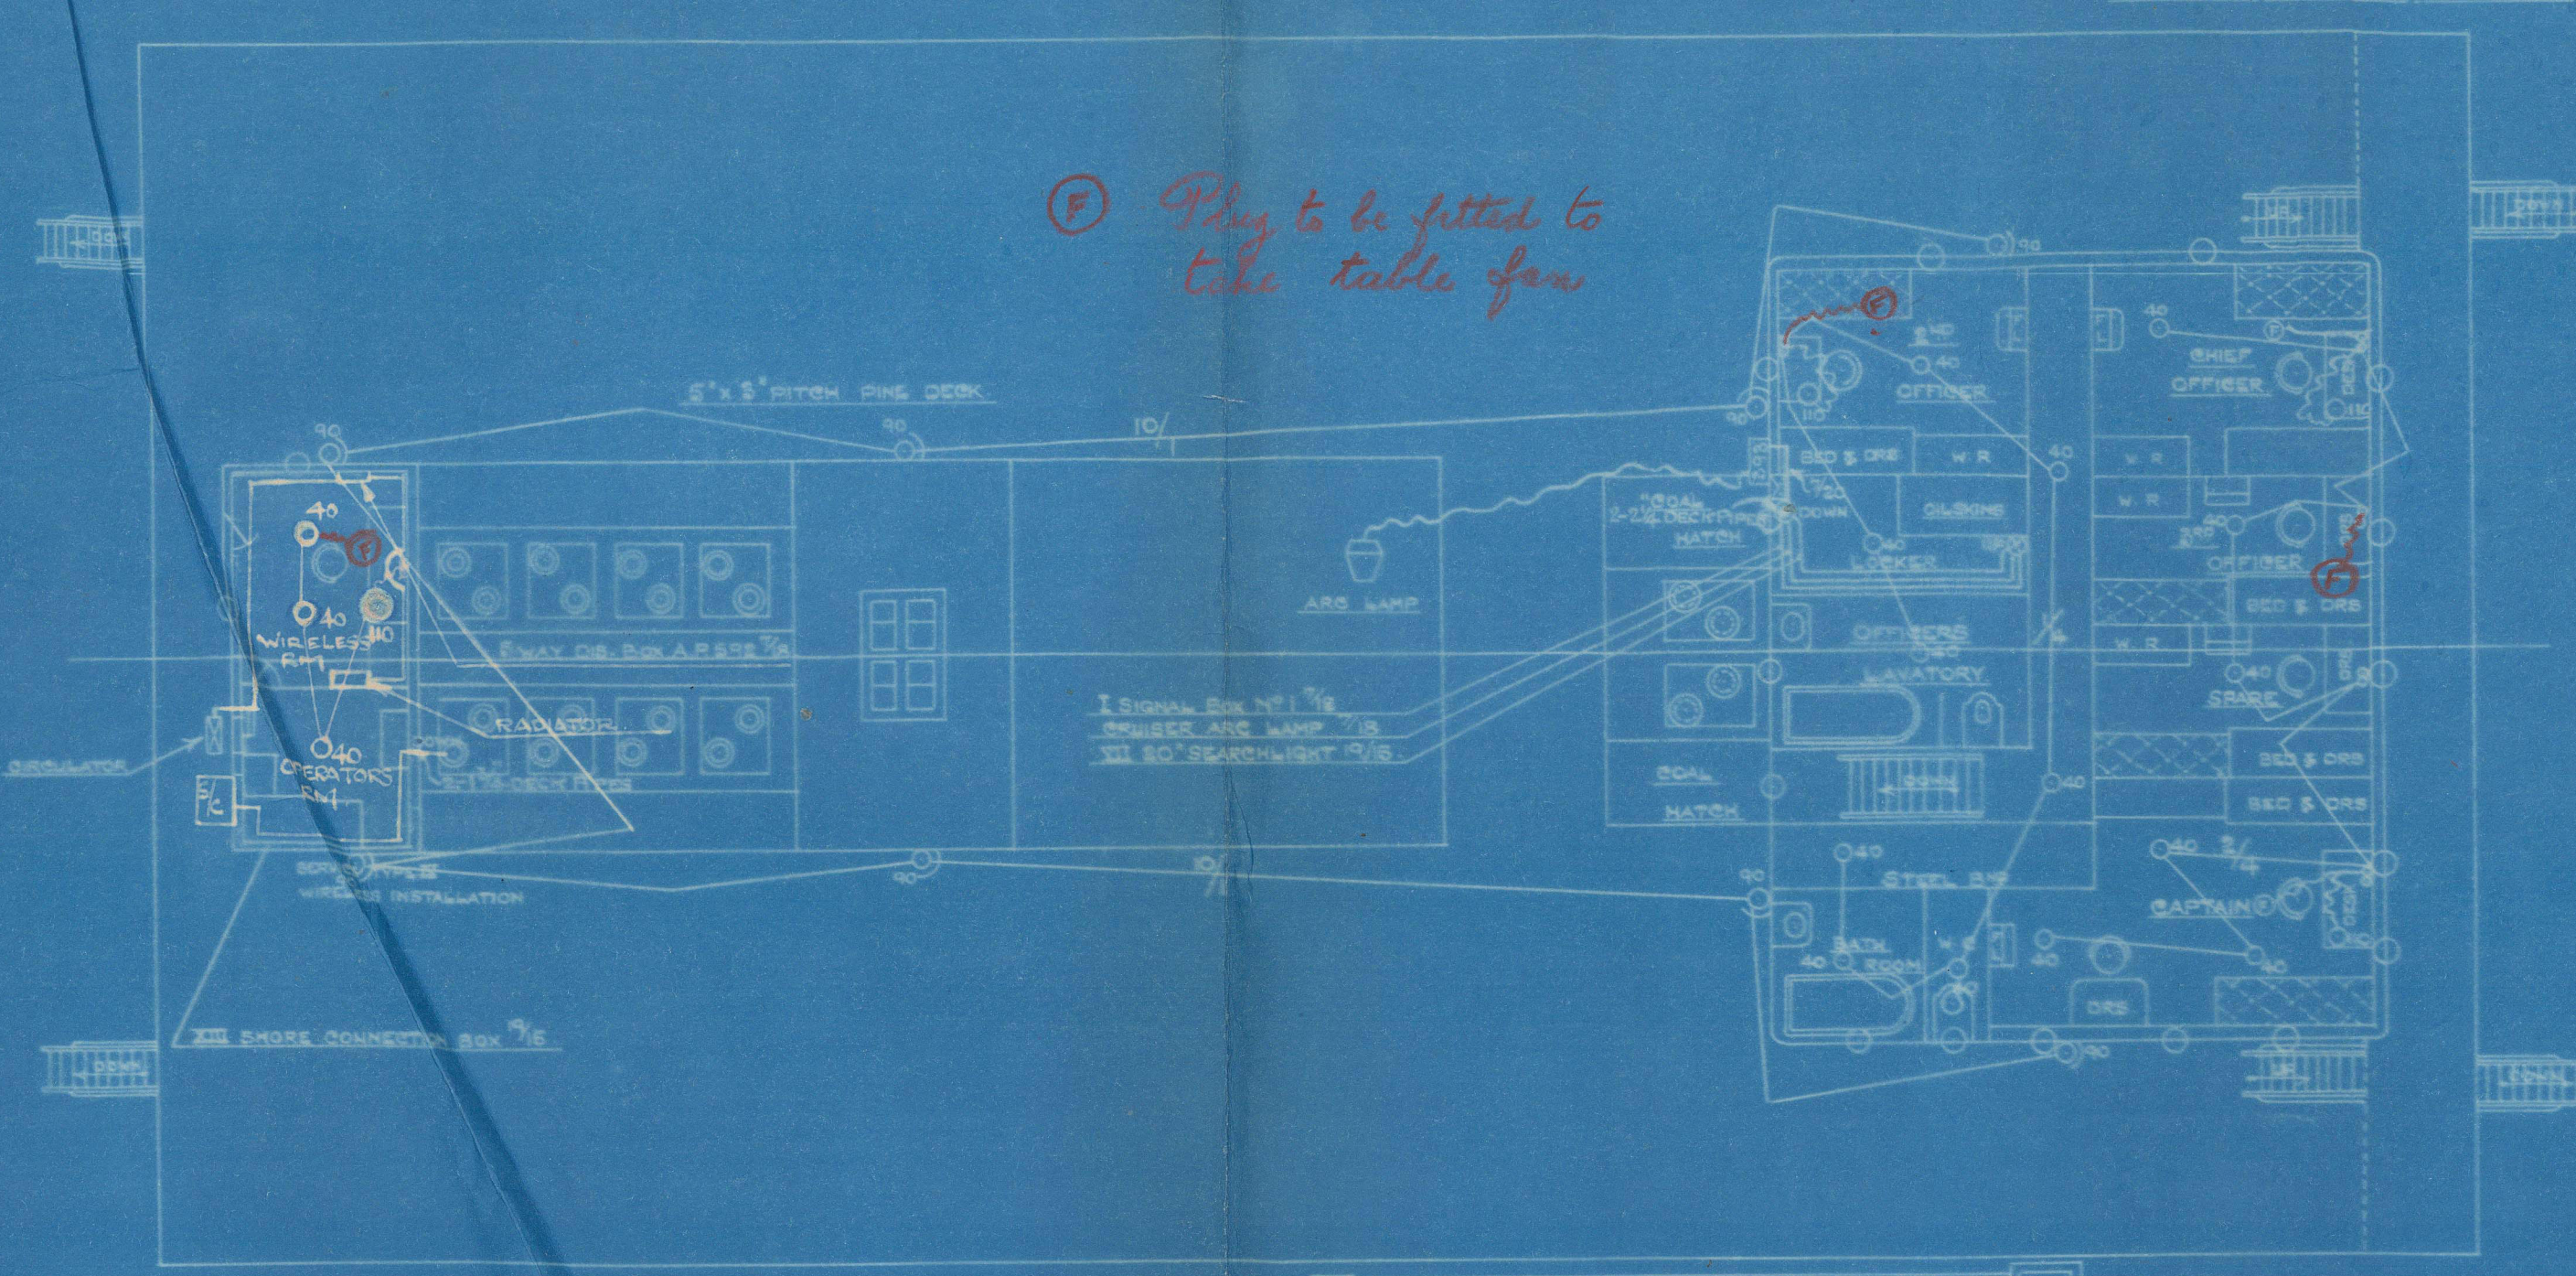

BRIDGE DECK.

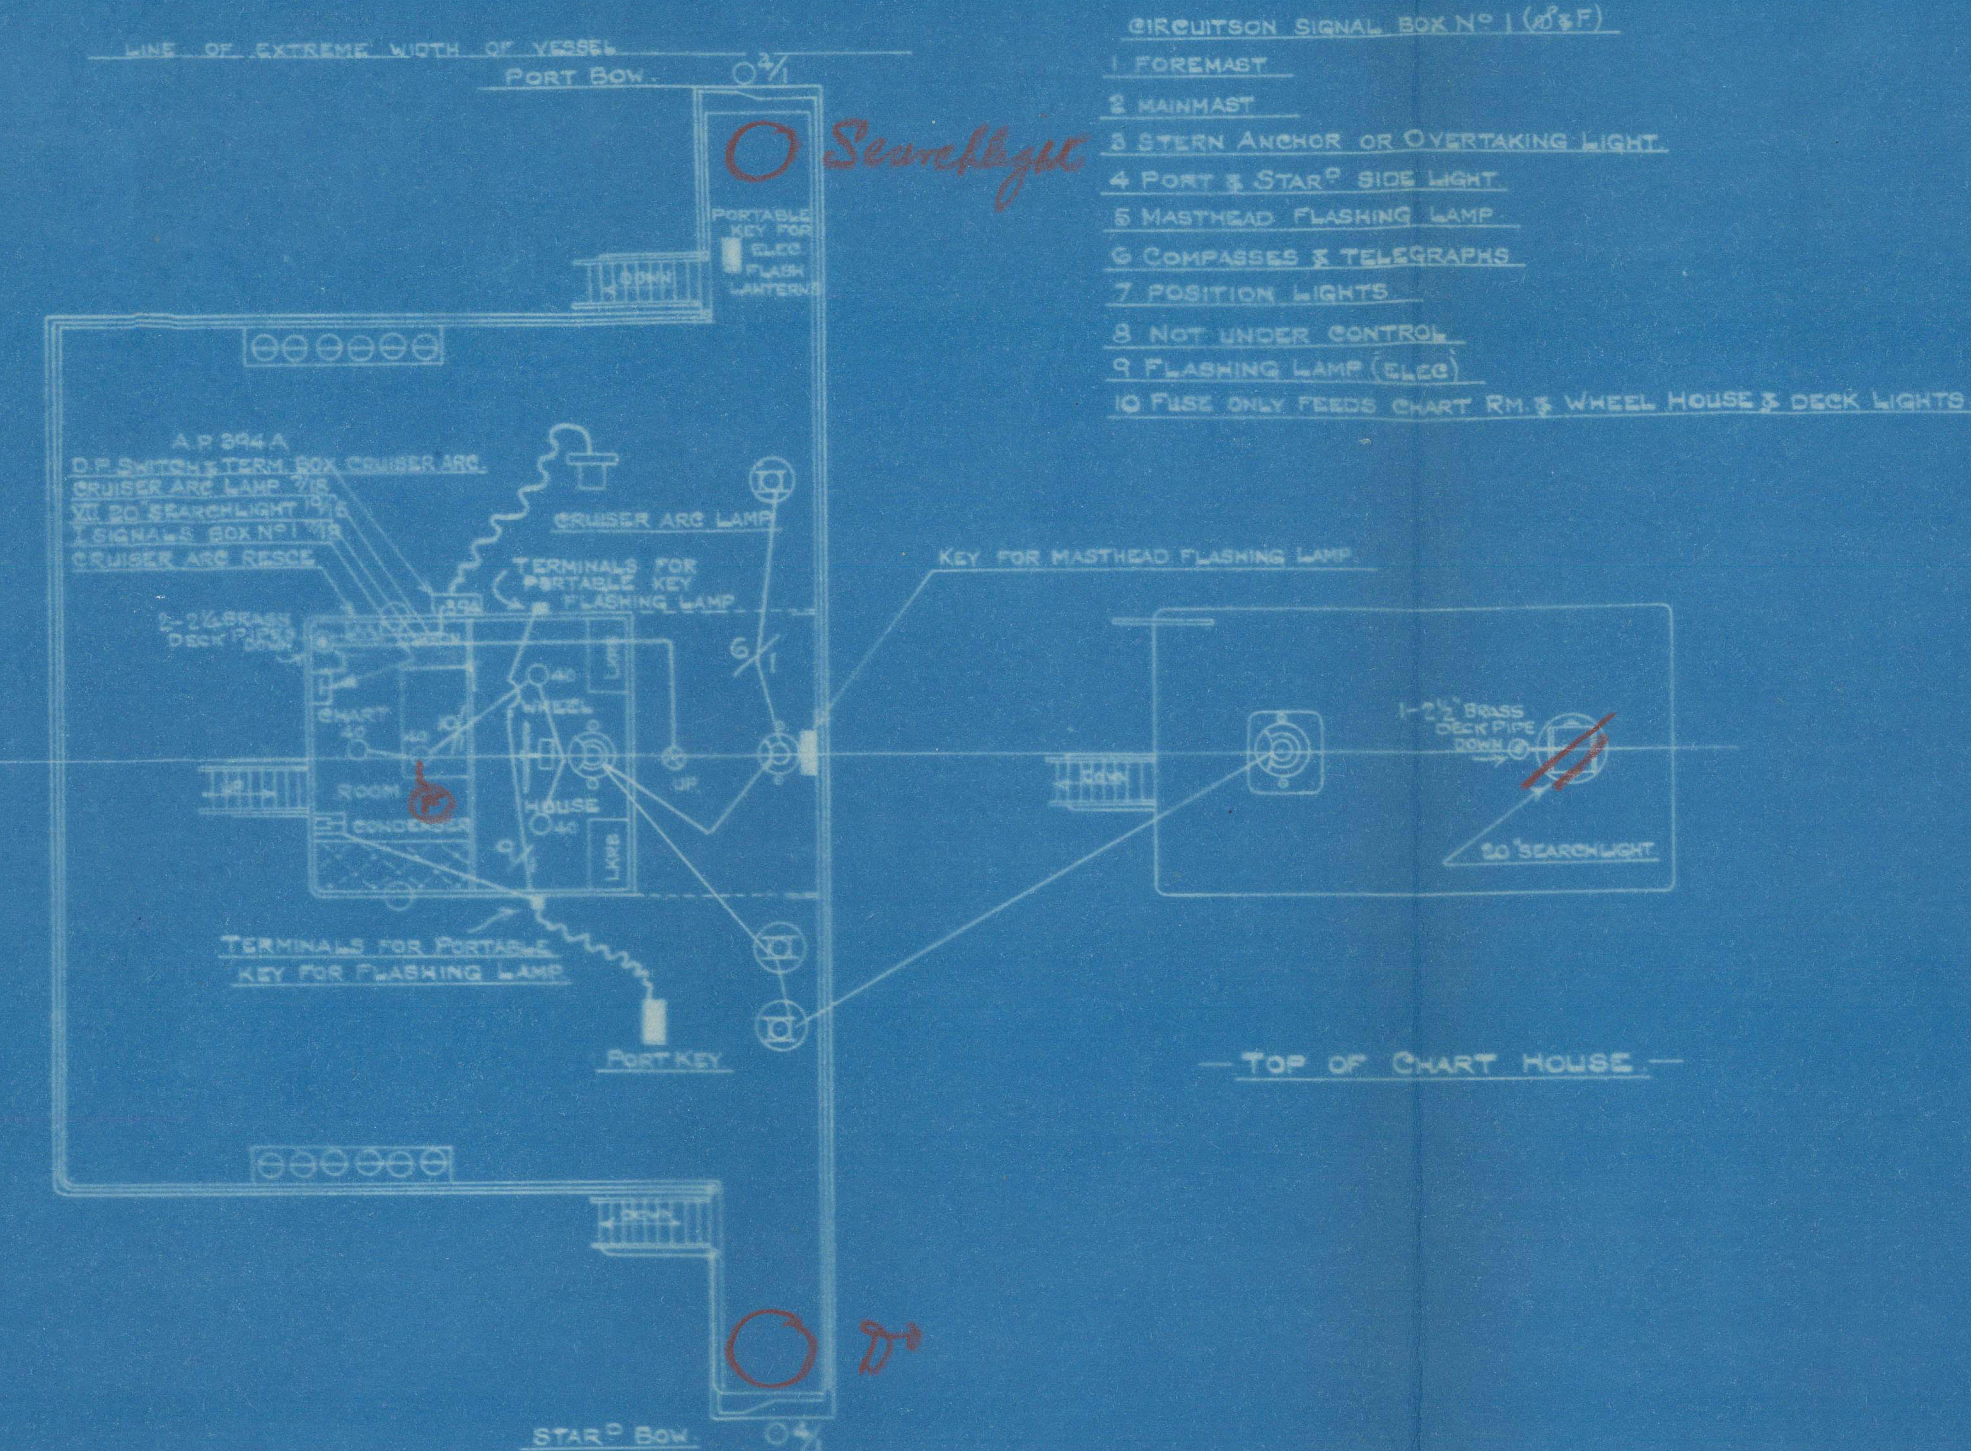

NAVIGATING BRIDGE.



St. Raphael ex  
Rodal ex Montezuma  
Electric Light Moving plan