

23/8/16

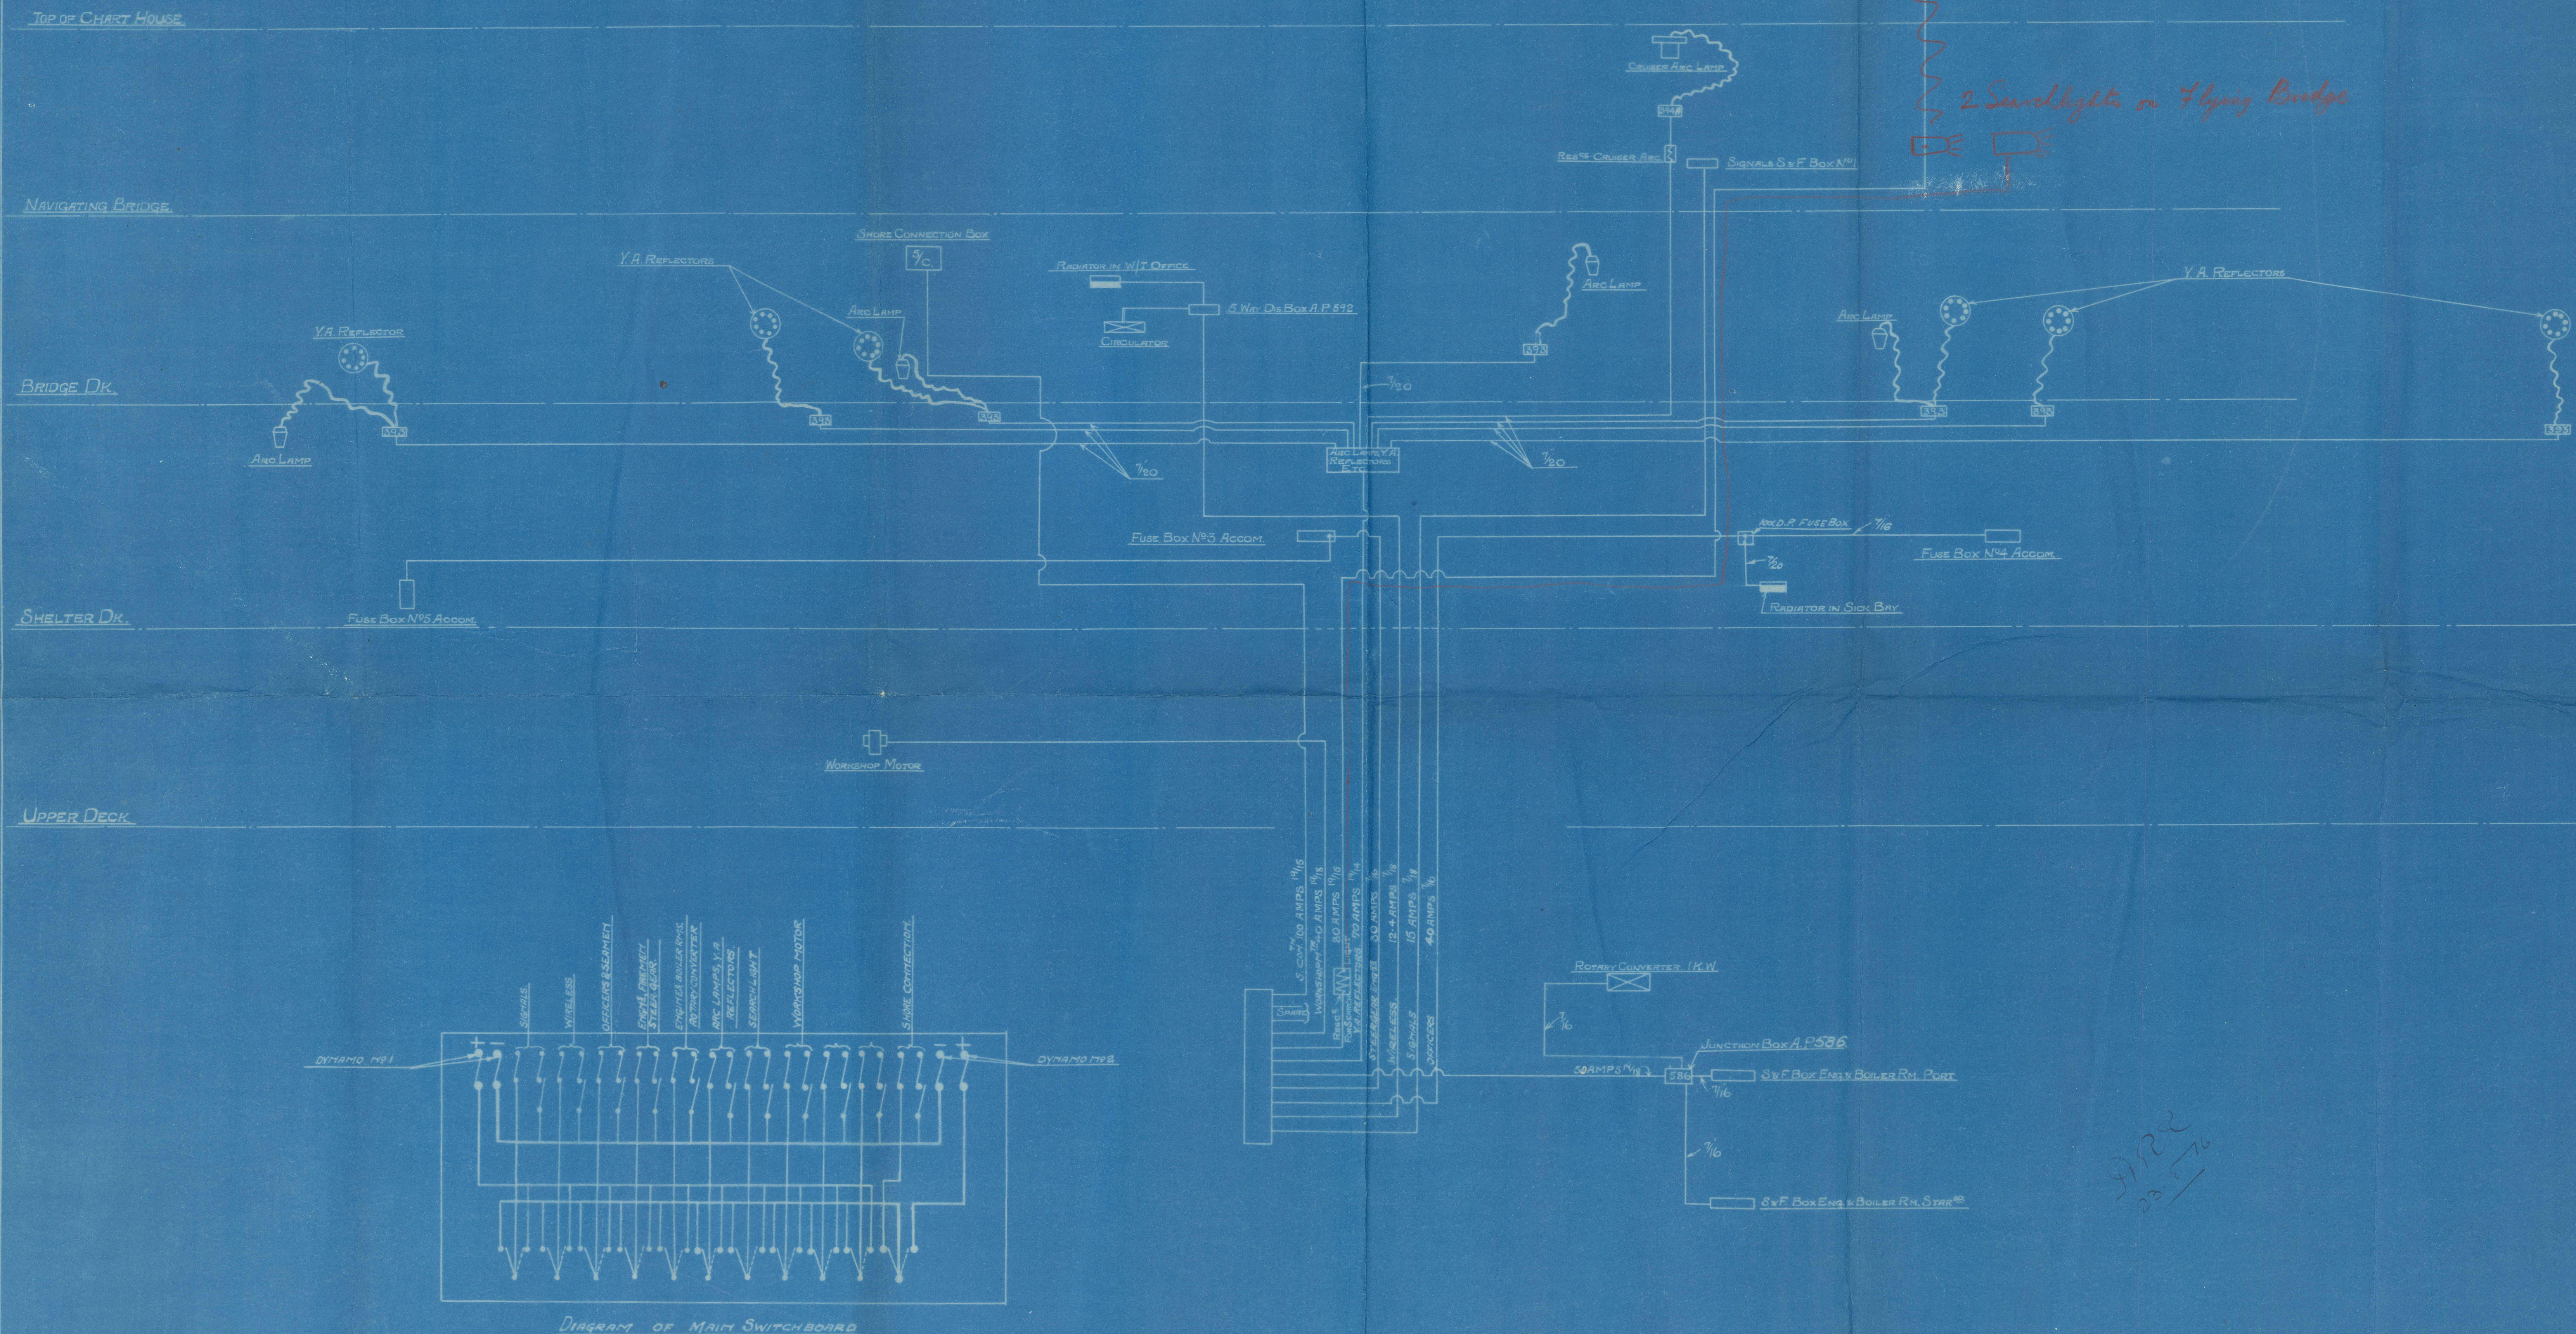


Diagram of Main Switchboard

H. M. S. "ABADOL".

DIAGRAM OF ELECTRIC LIGHT & POWER CIRCUITS.

N° 15060—SP

B. Oakleaf
ex *Abadal*

Electric Light, Circuits.



© 2021

GLS281-0017
Lloyd's Register
Foundation