




279.16

R. F. A. "ABADOL"
FOR BILGE & BALLAST ARRANGEMENT
SCALE 3/4" = 1 FOOT




PLAN

SECTION IN WAY OF PUMP
LOOKING WEST

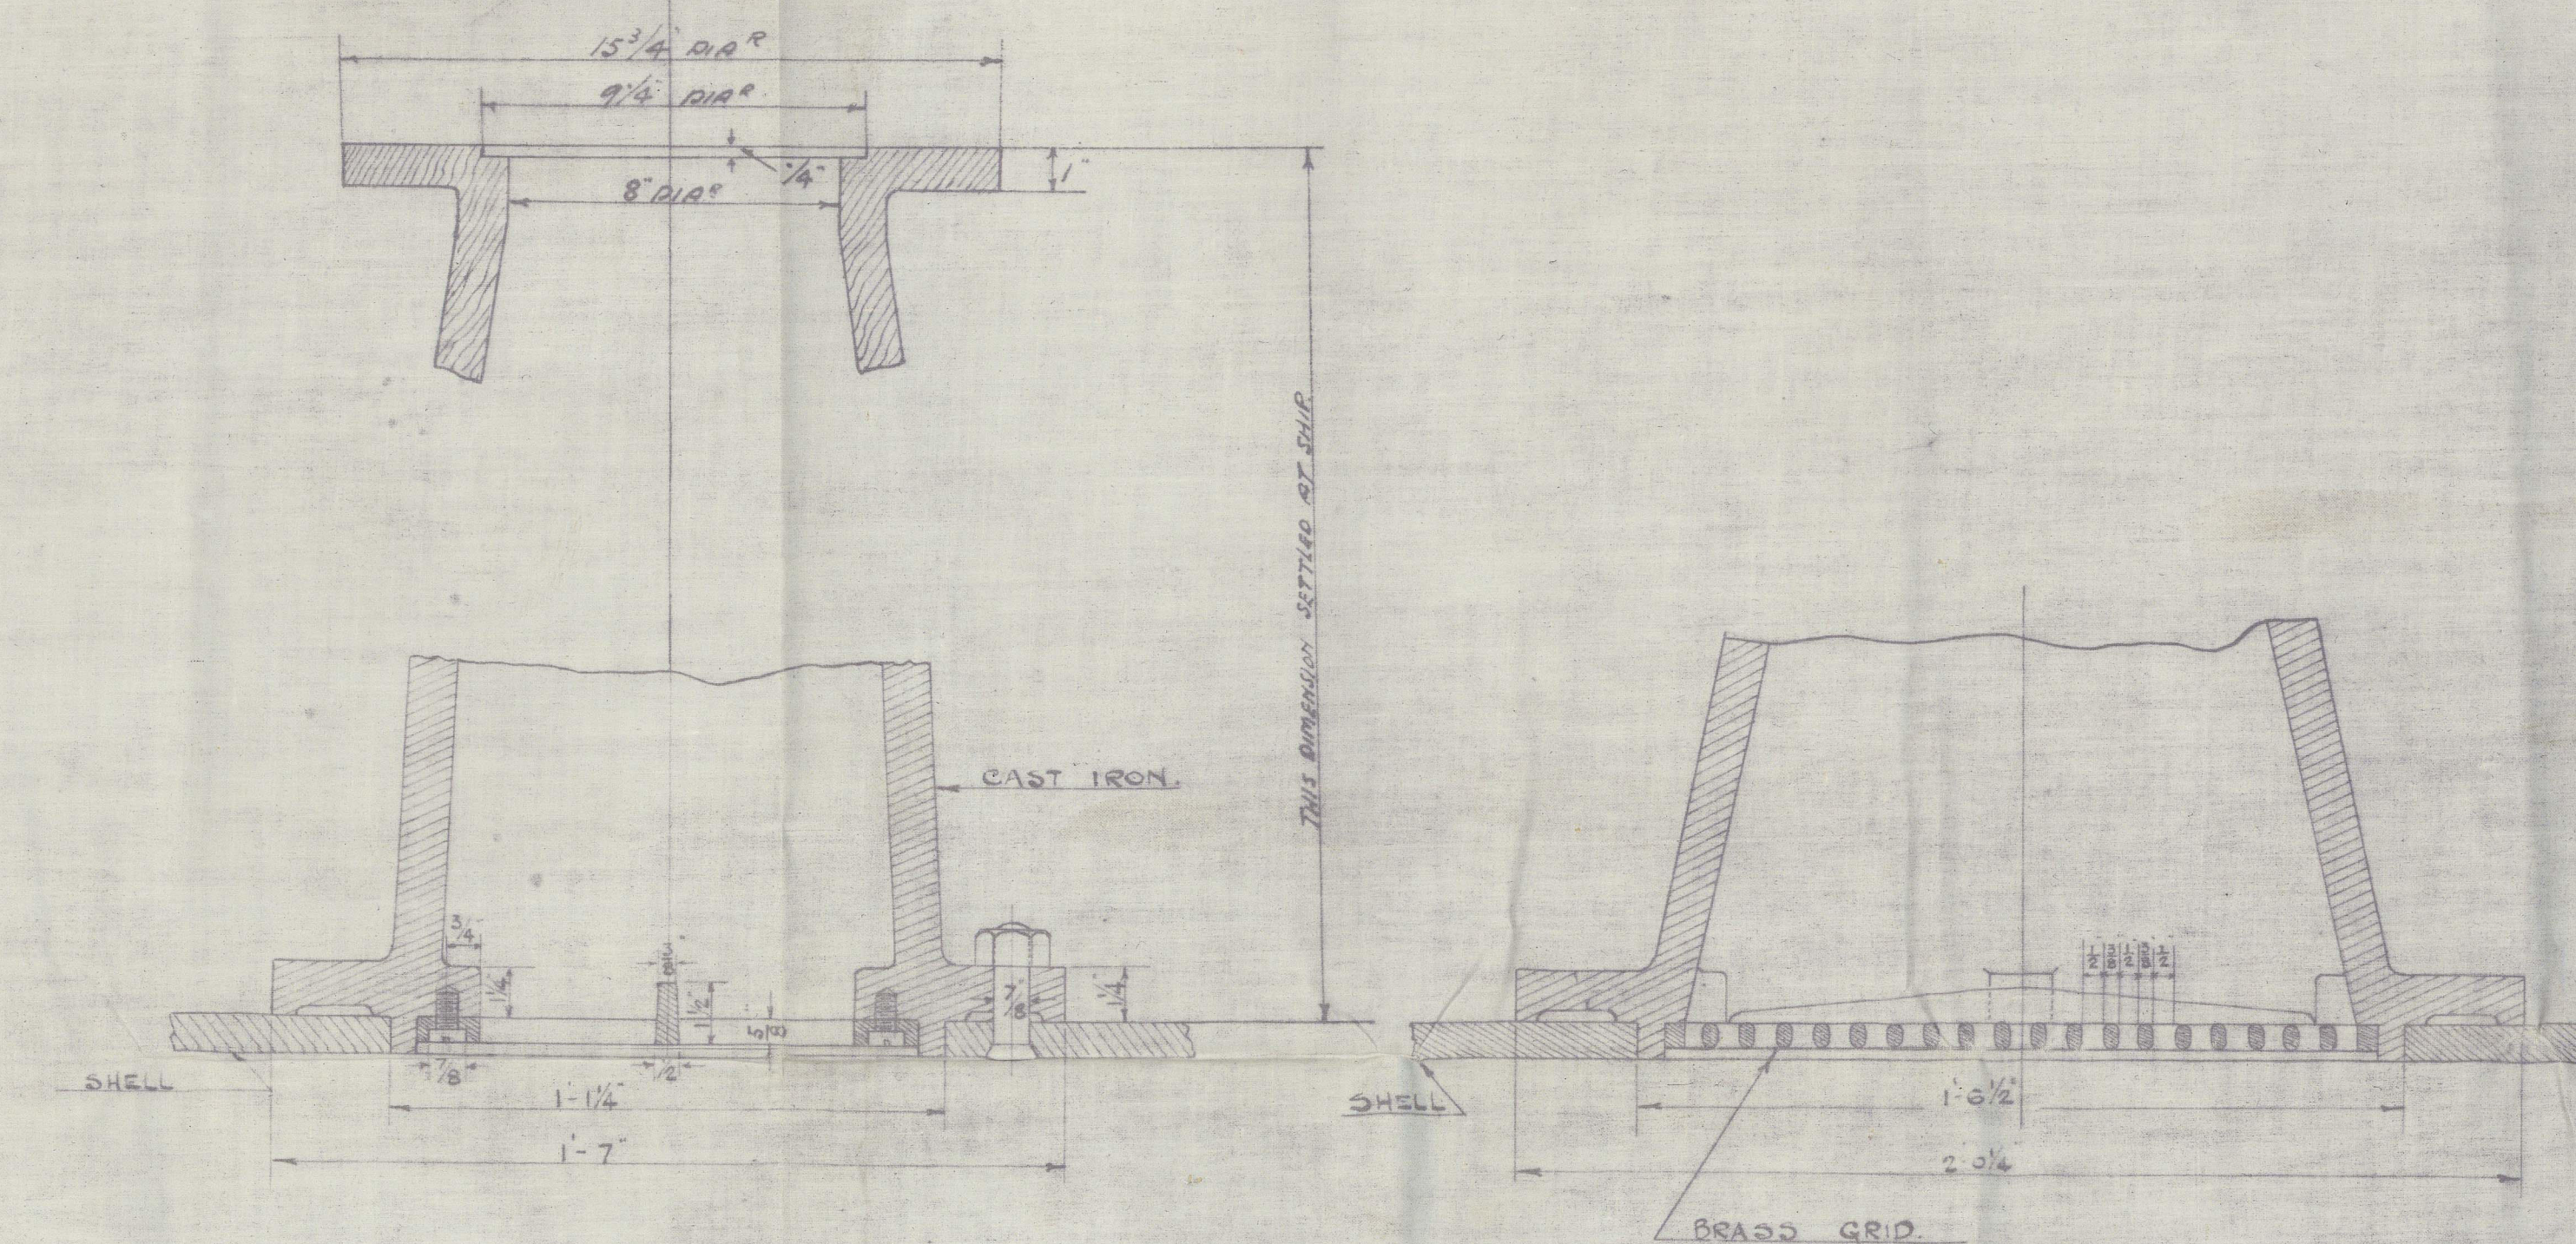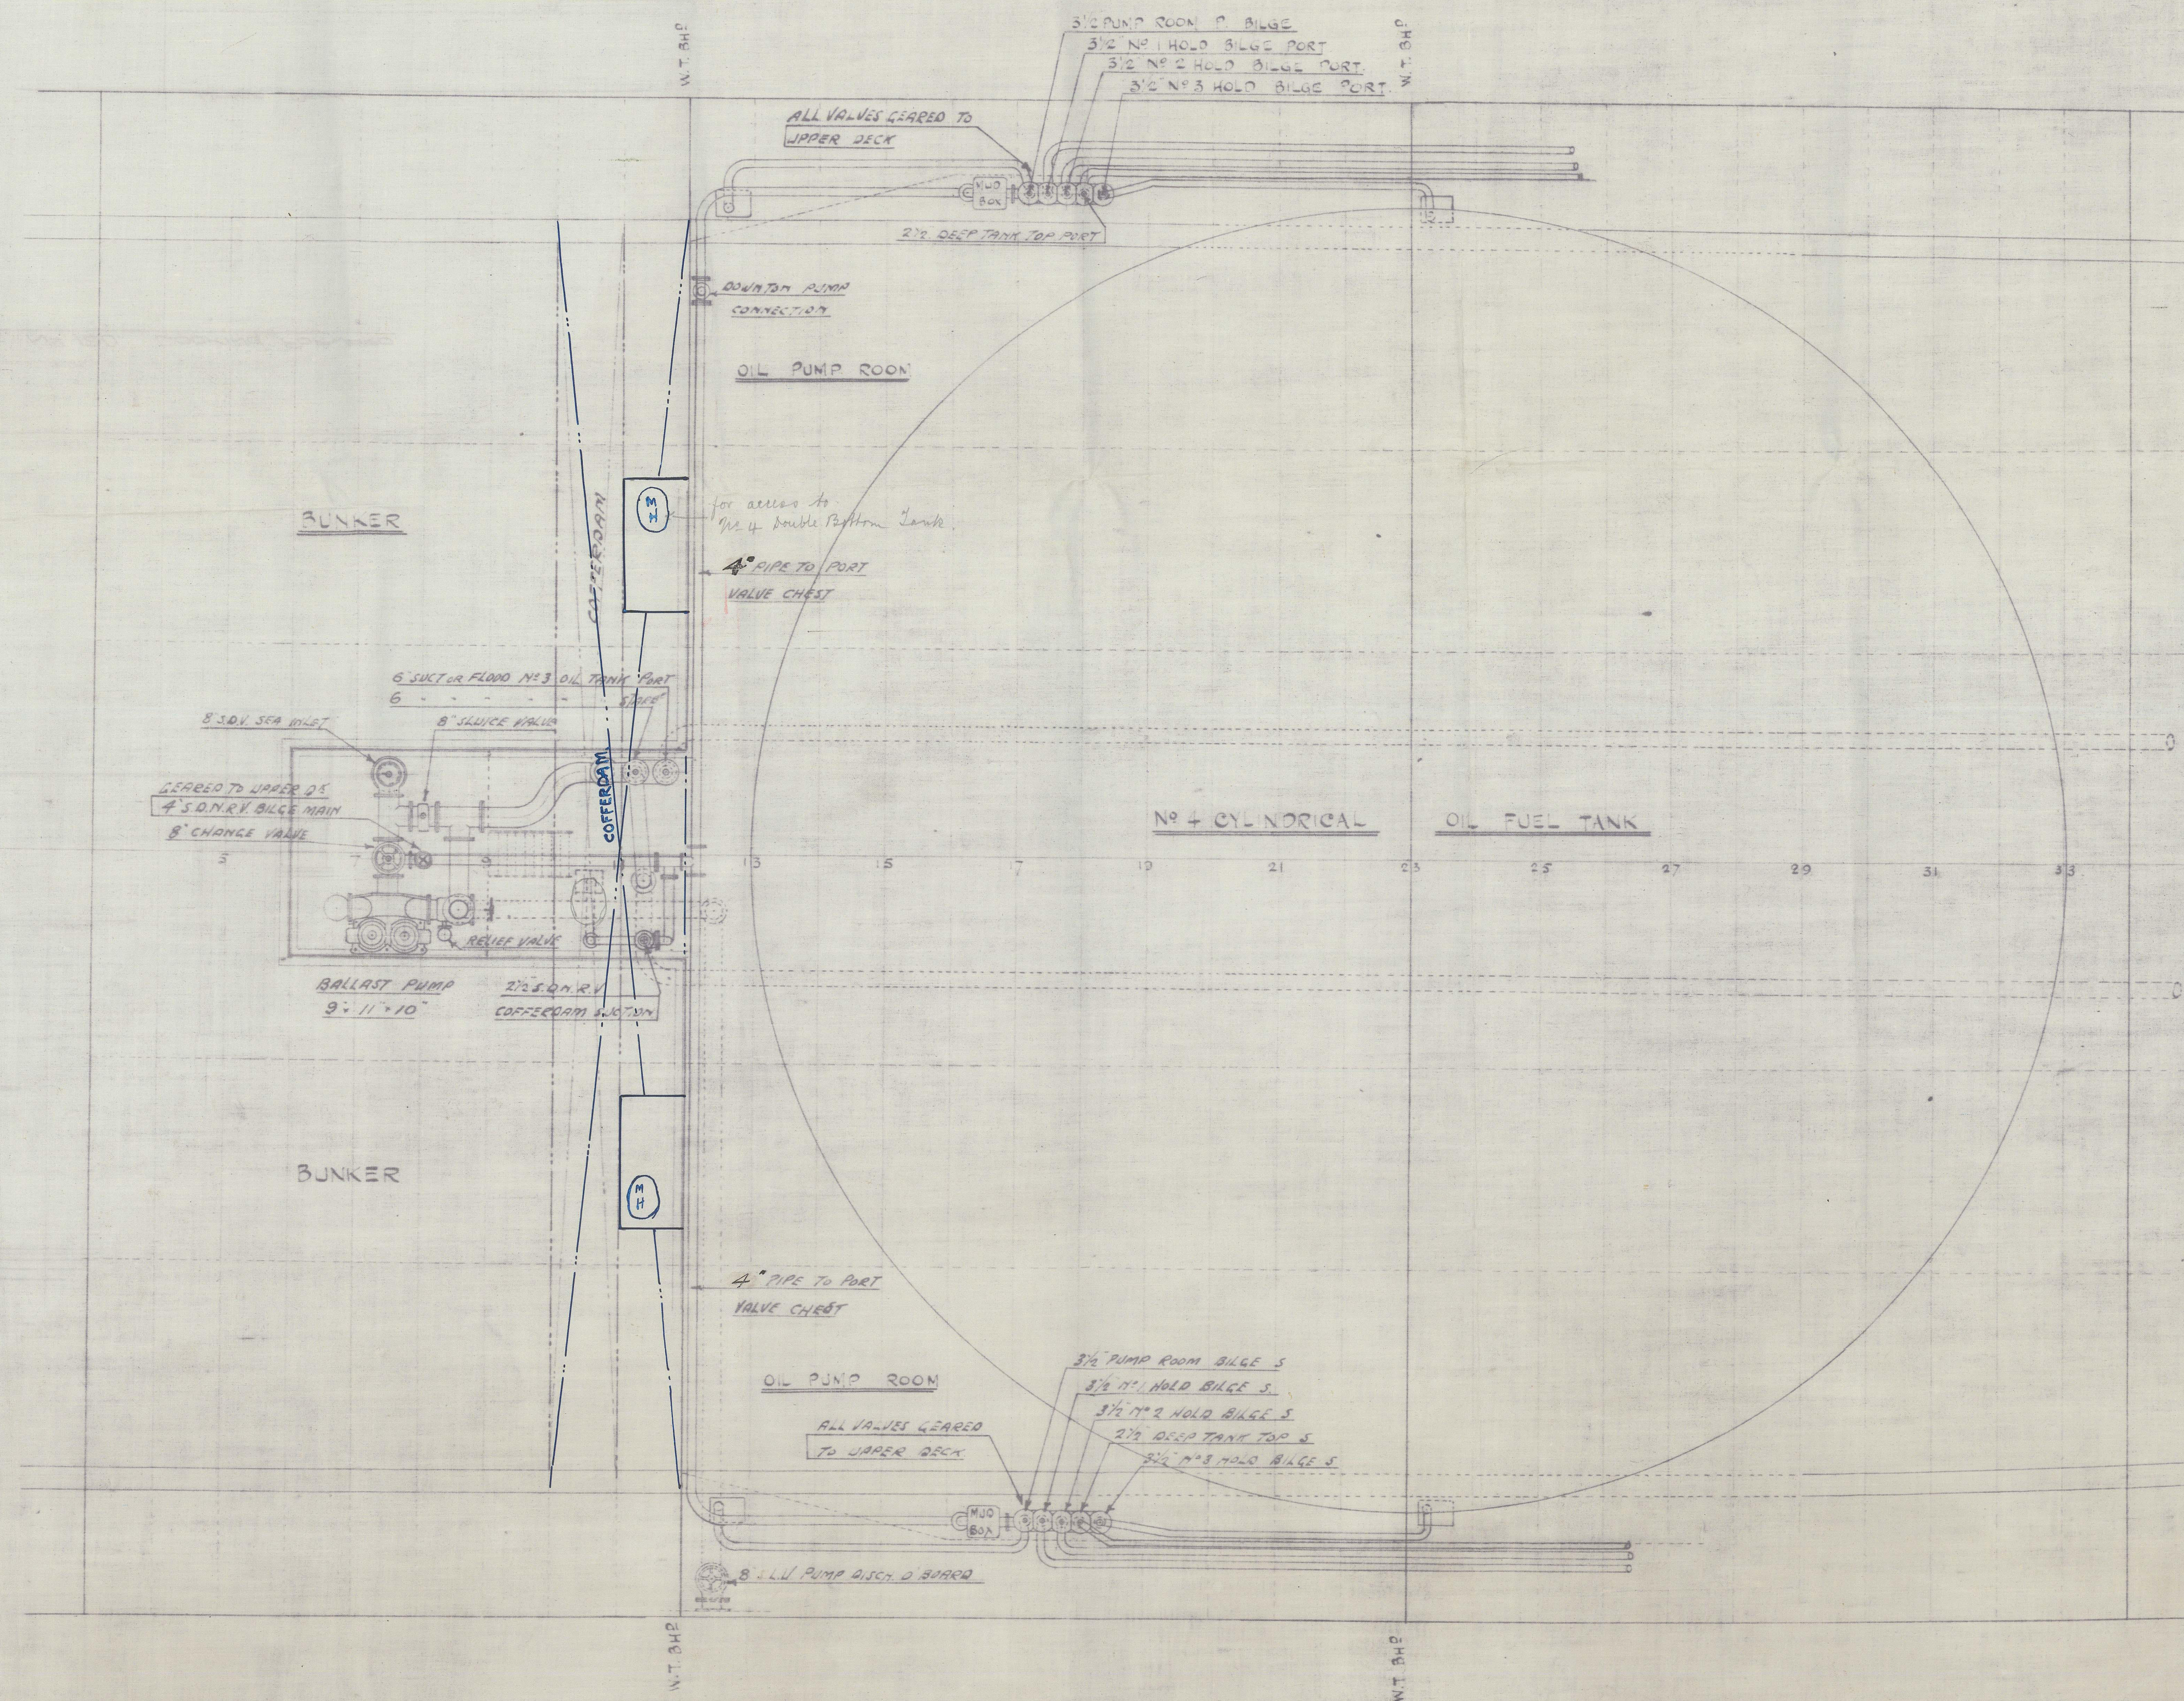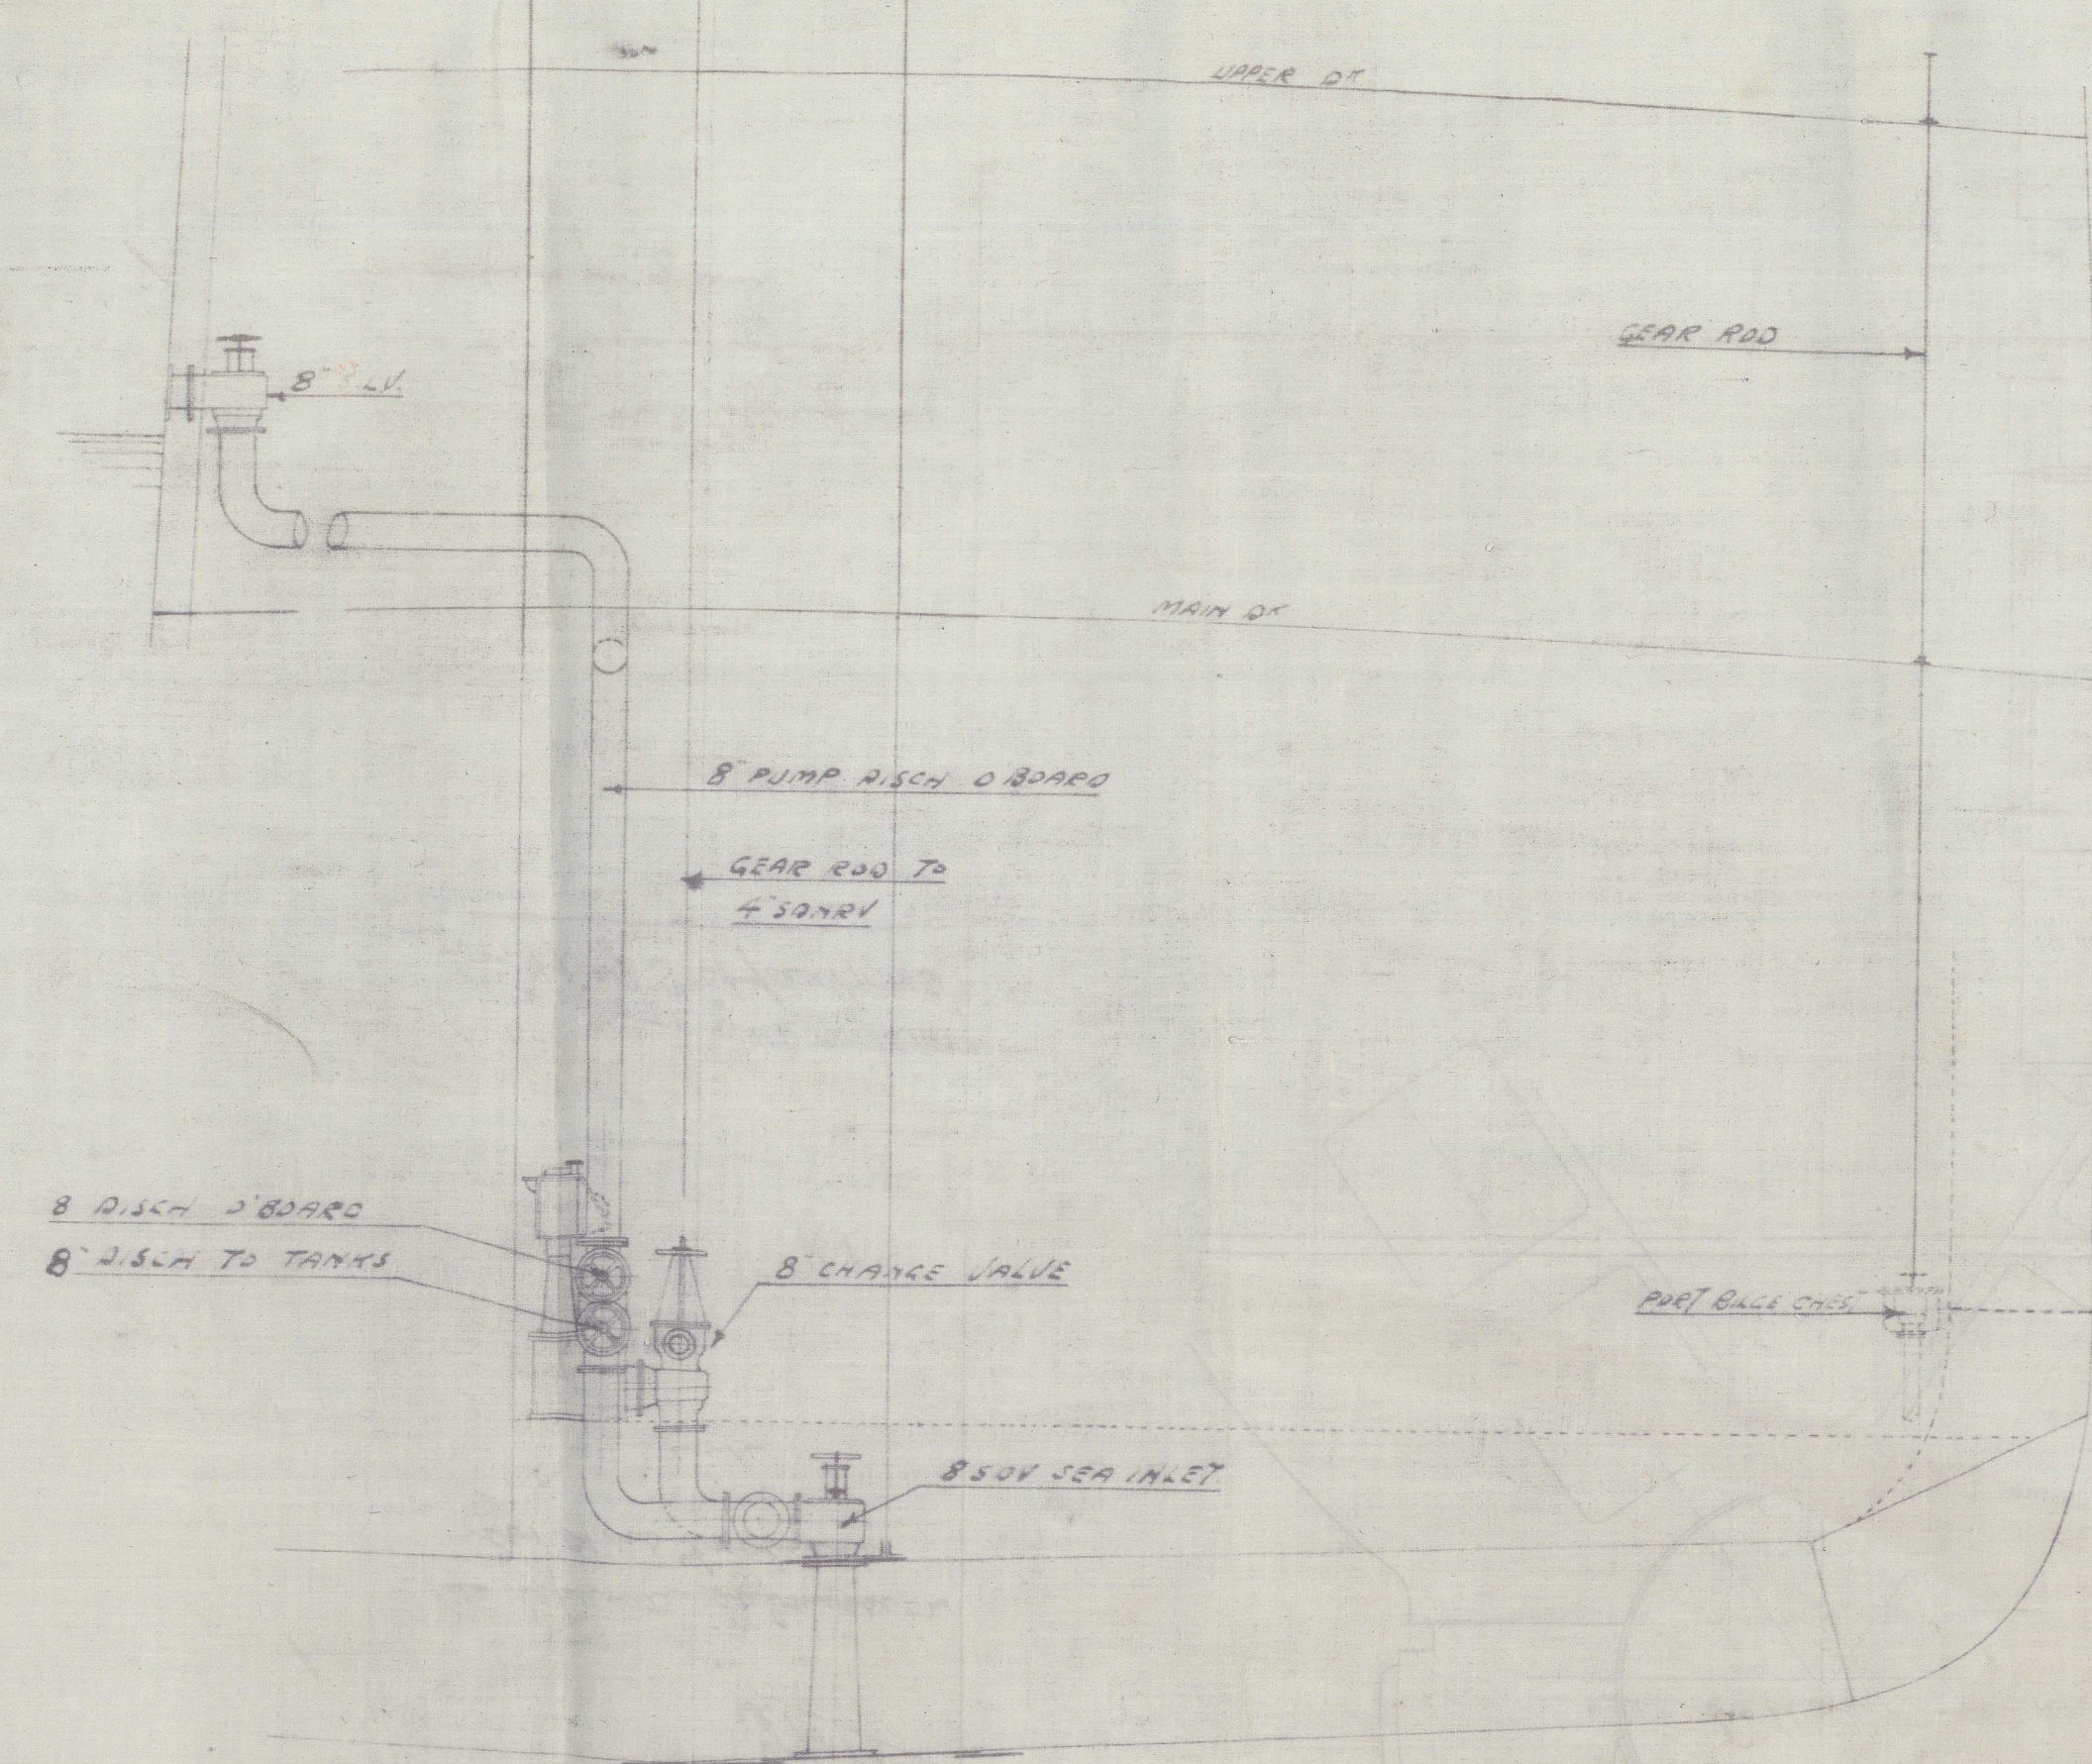

BOTTOM CONNECTION FOR INJECTION VALVE


AREA THRO GRID = 96 SQ INS
 AREA OF 8 PIPE = 50 SQ INS
 EXCESS AREA 92%

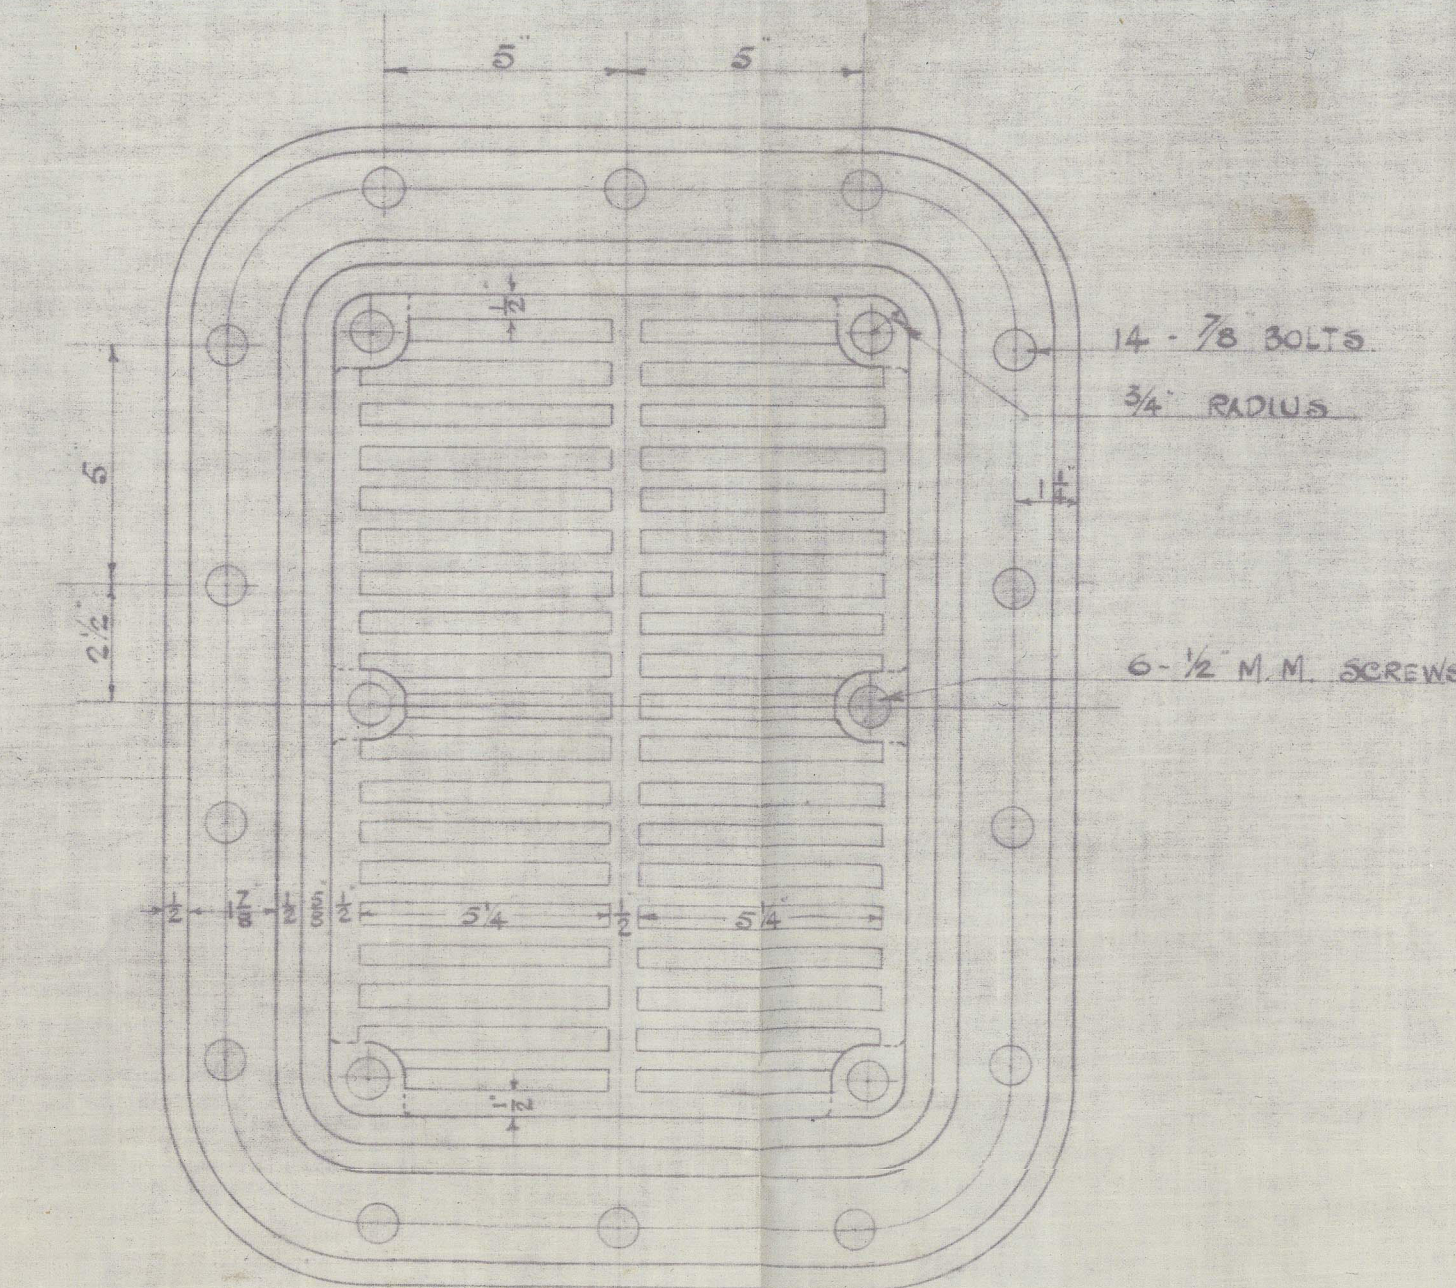

cf.
 96
 100

R.F.A. "abadol"

Detail of connections of forward
bilge and ballast pipes to
forward pump room.

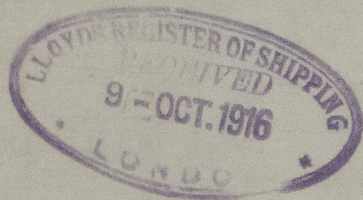

GLS281-0021



© 2021

Lloyd's Register
Foundation