

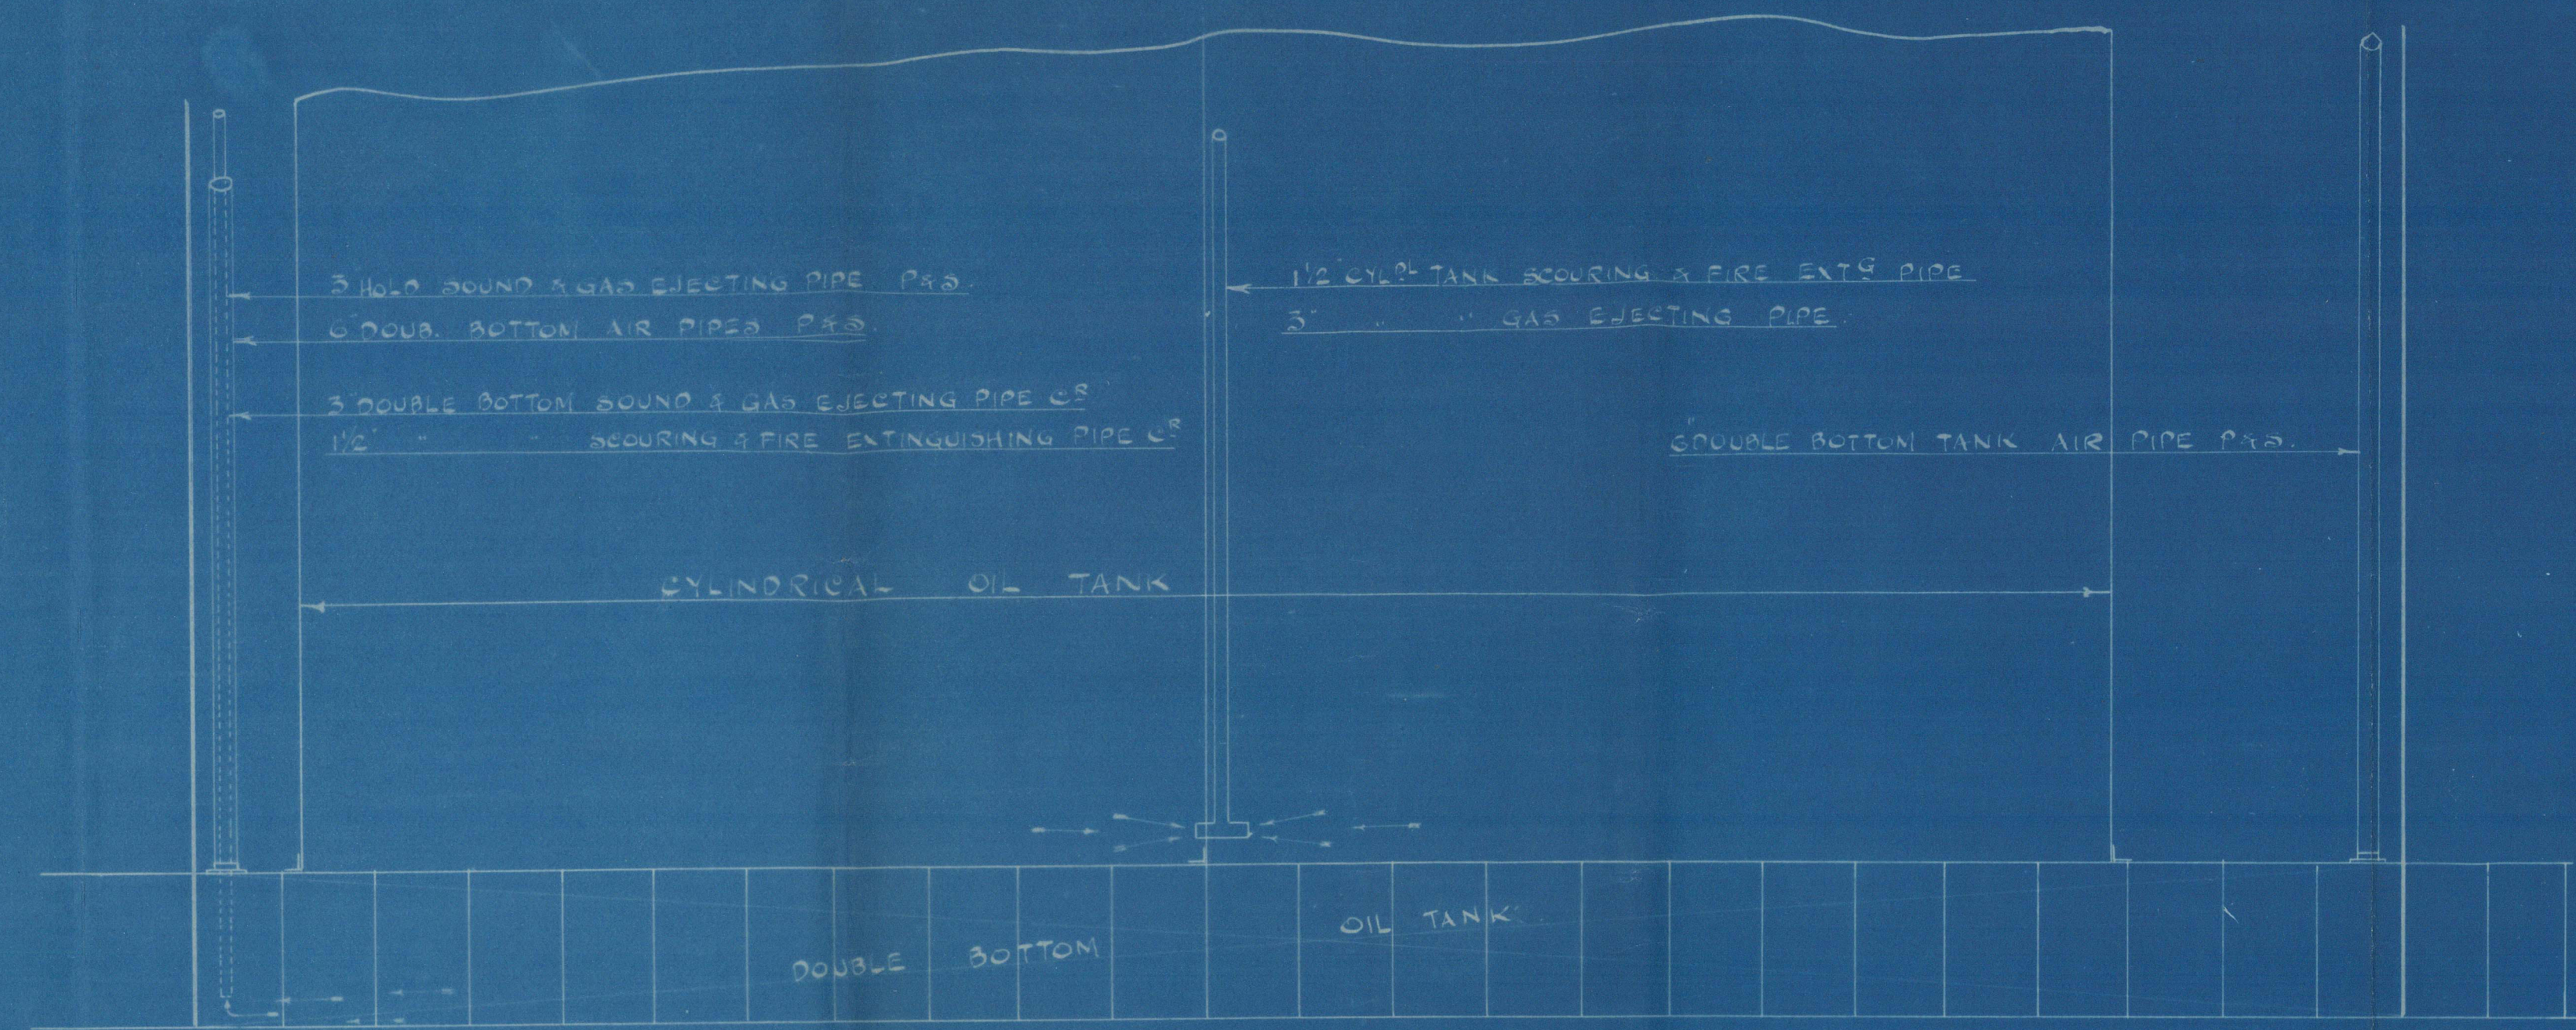


6-8-16

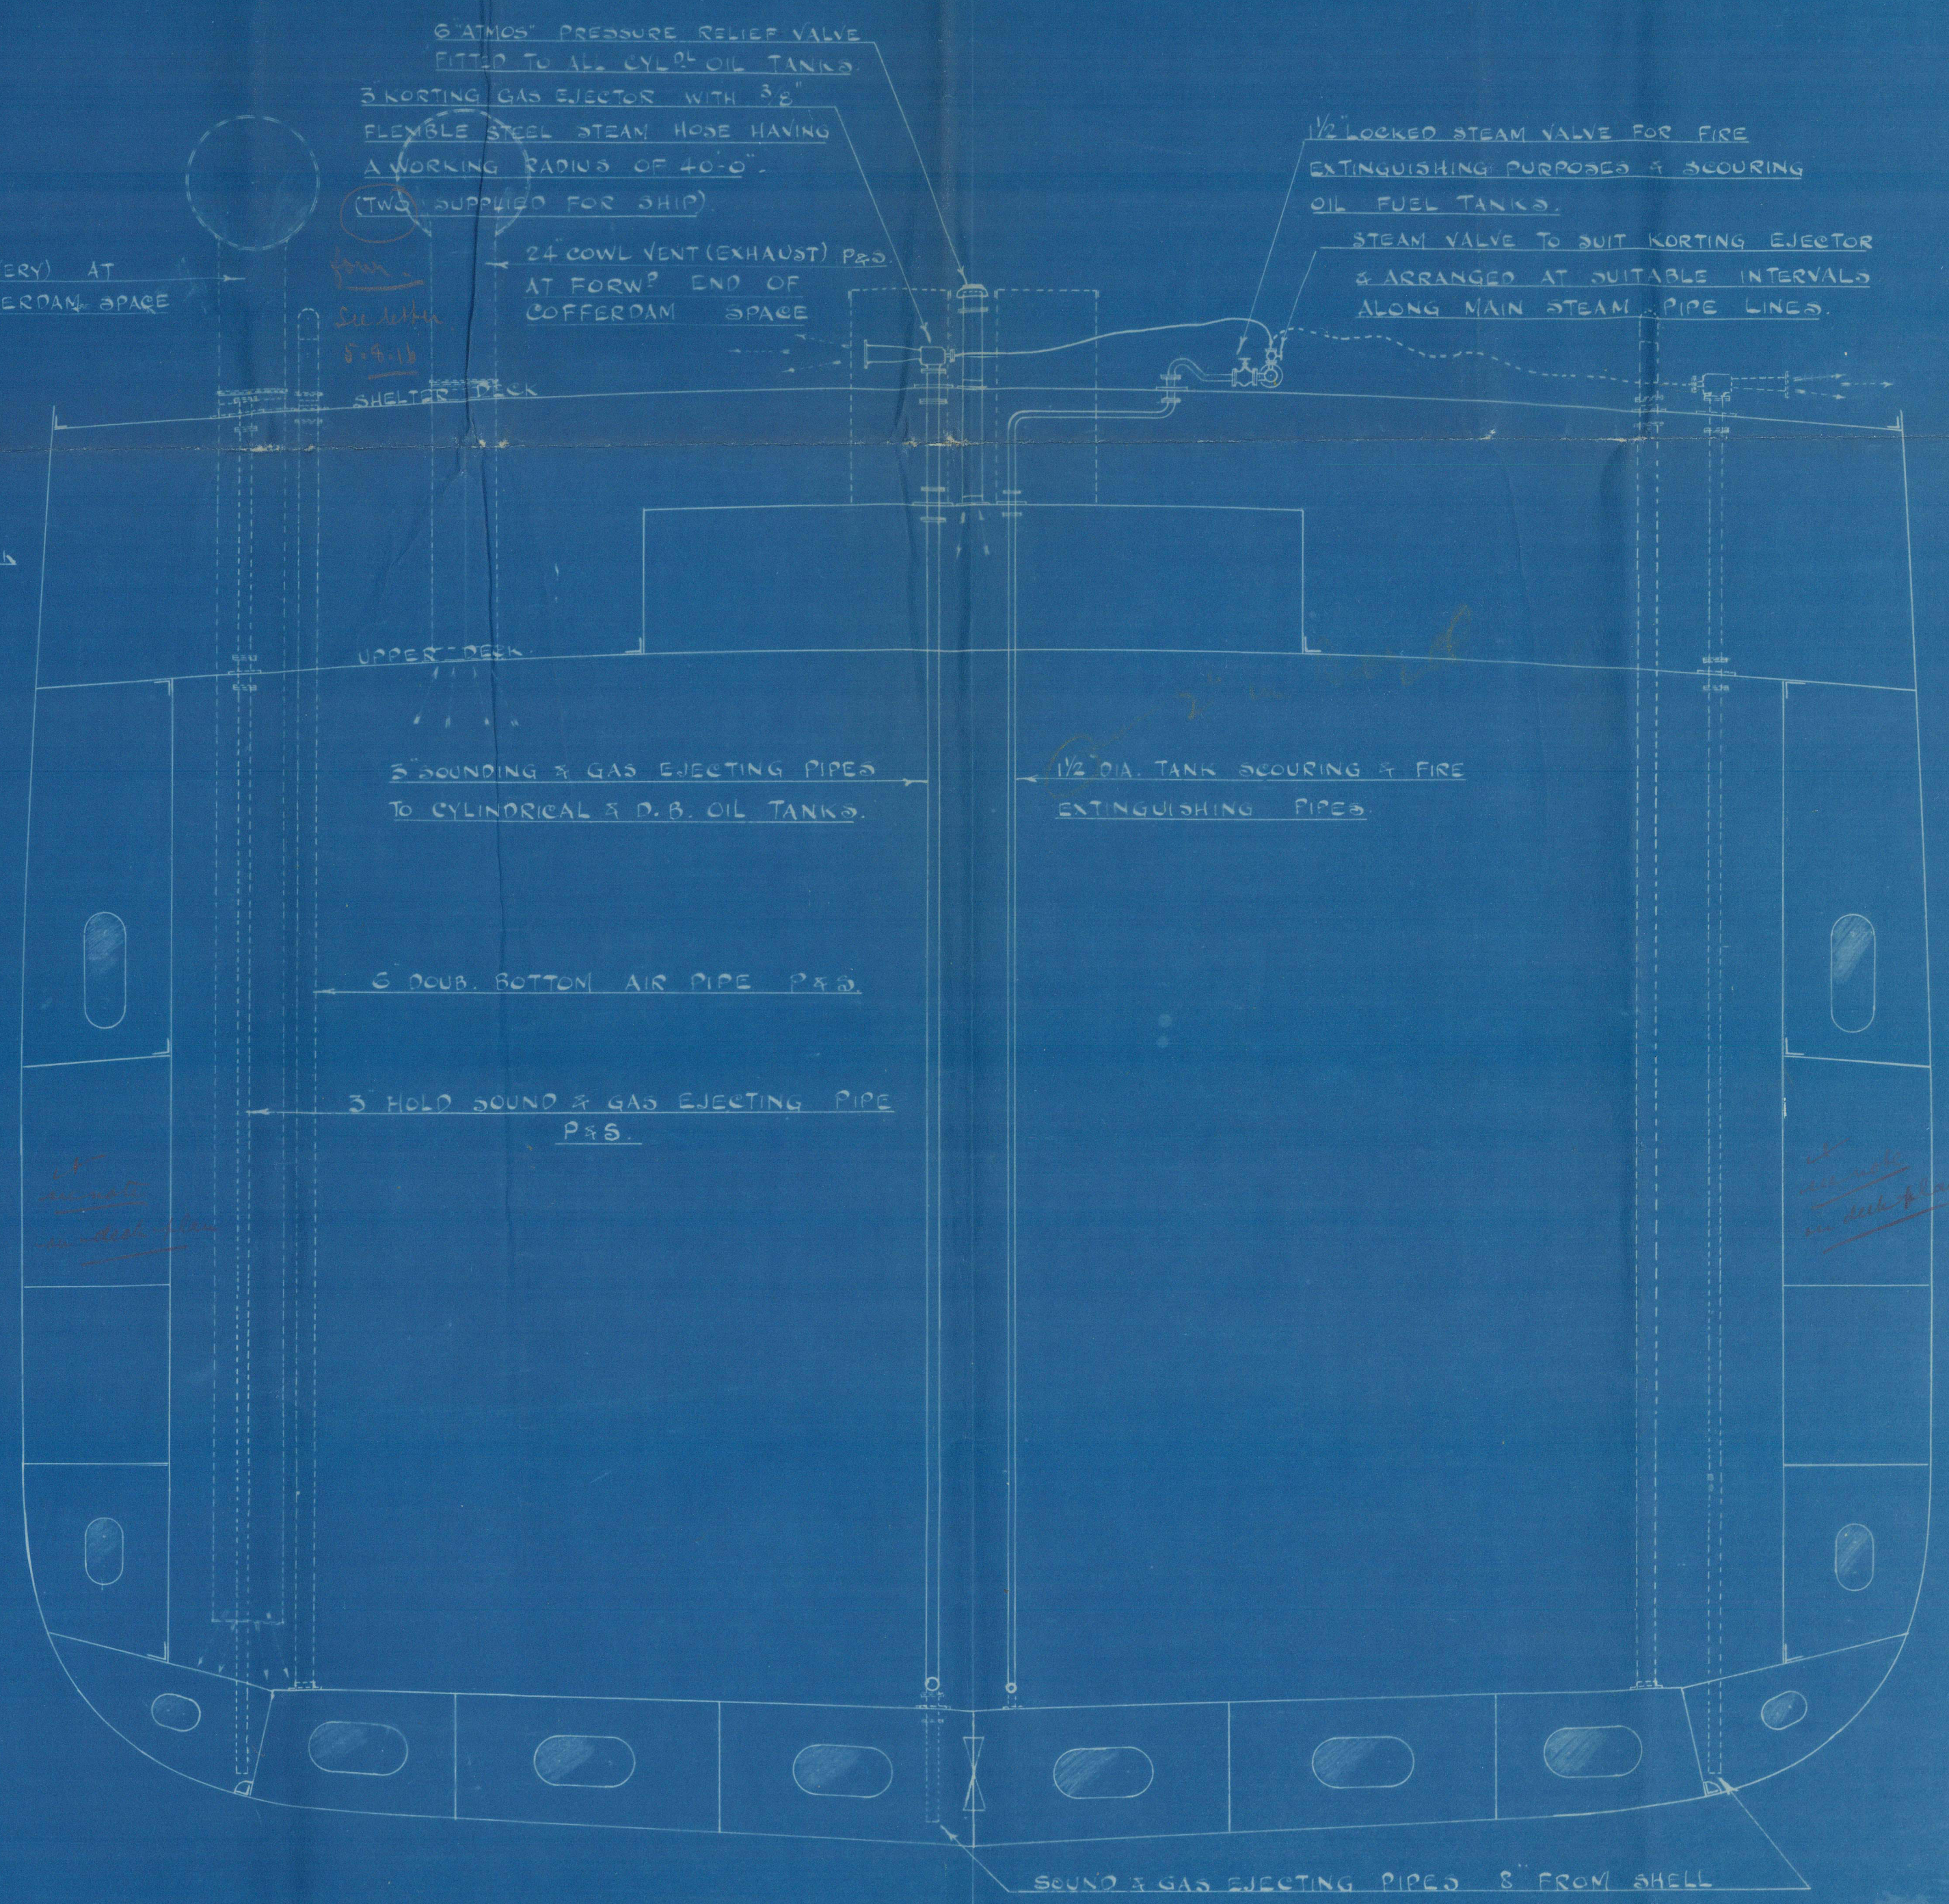

R F A "ABADOL" VENTILATION OF OIL FUEL TANKS & COFFERDAM SPACES OUTSIDE TANKS

SCALE 1/4" = ONE FOOT.

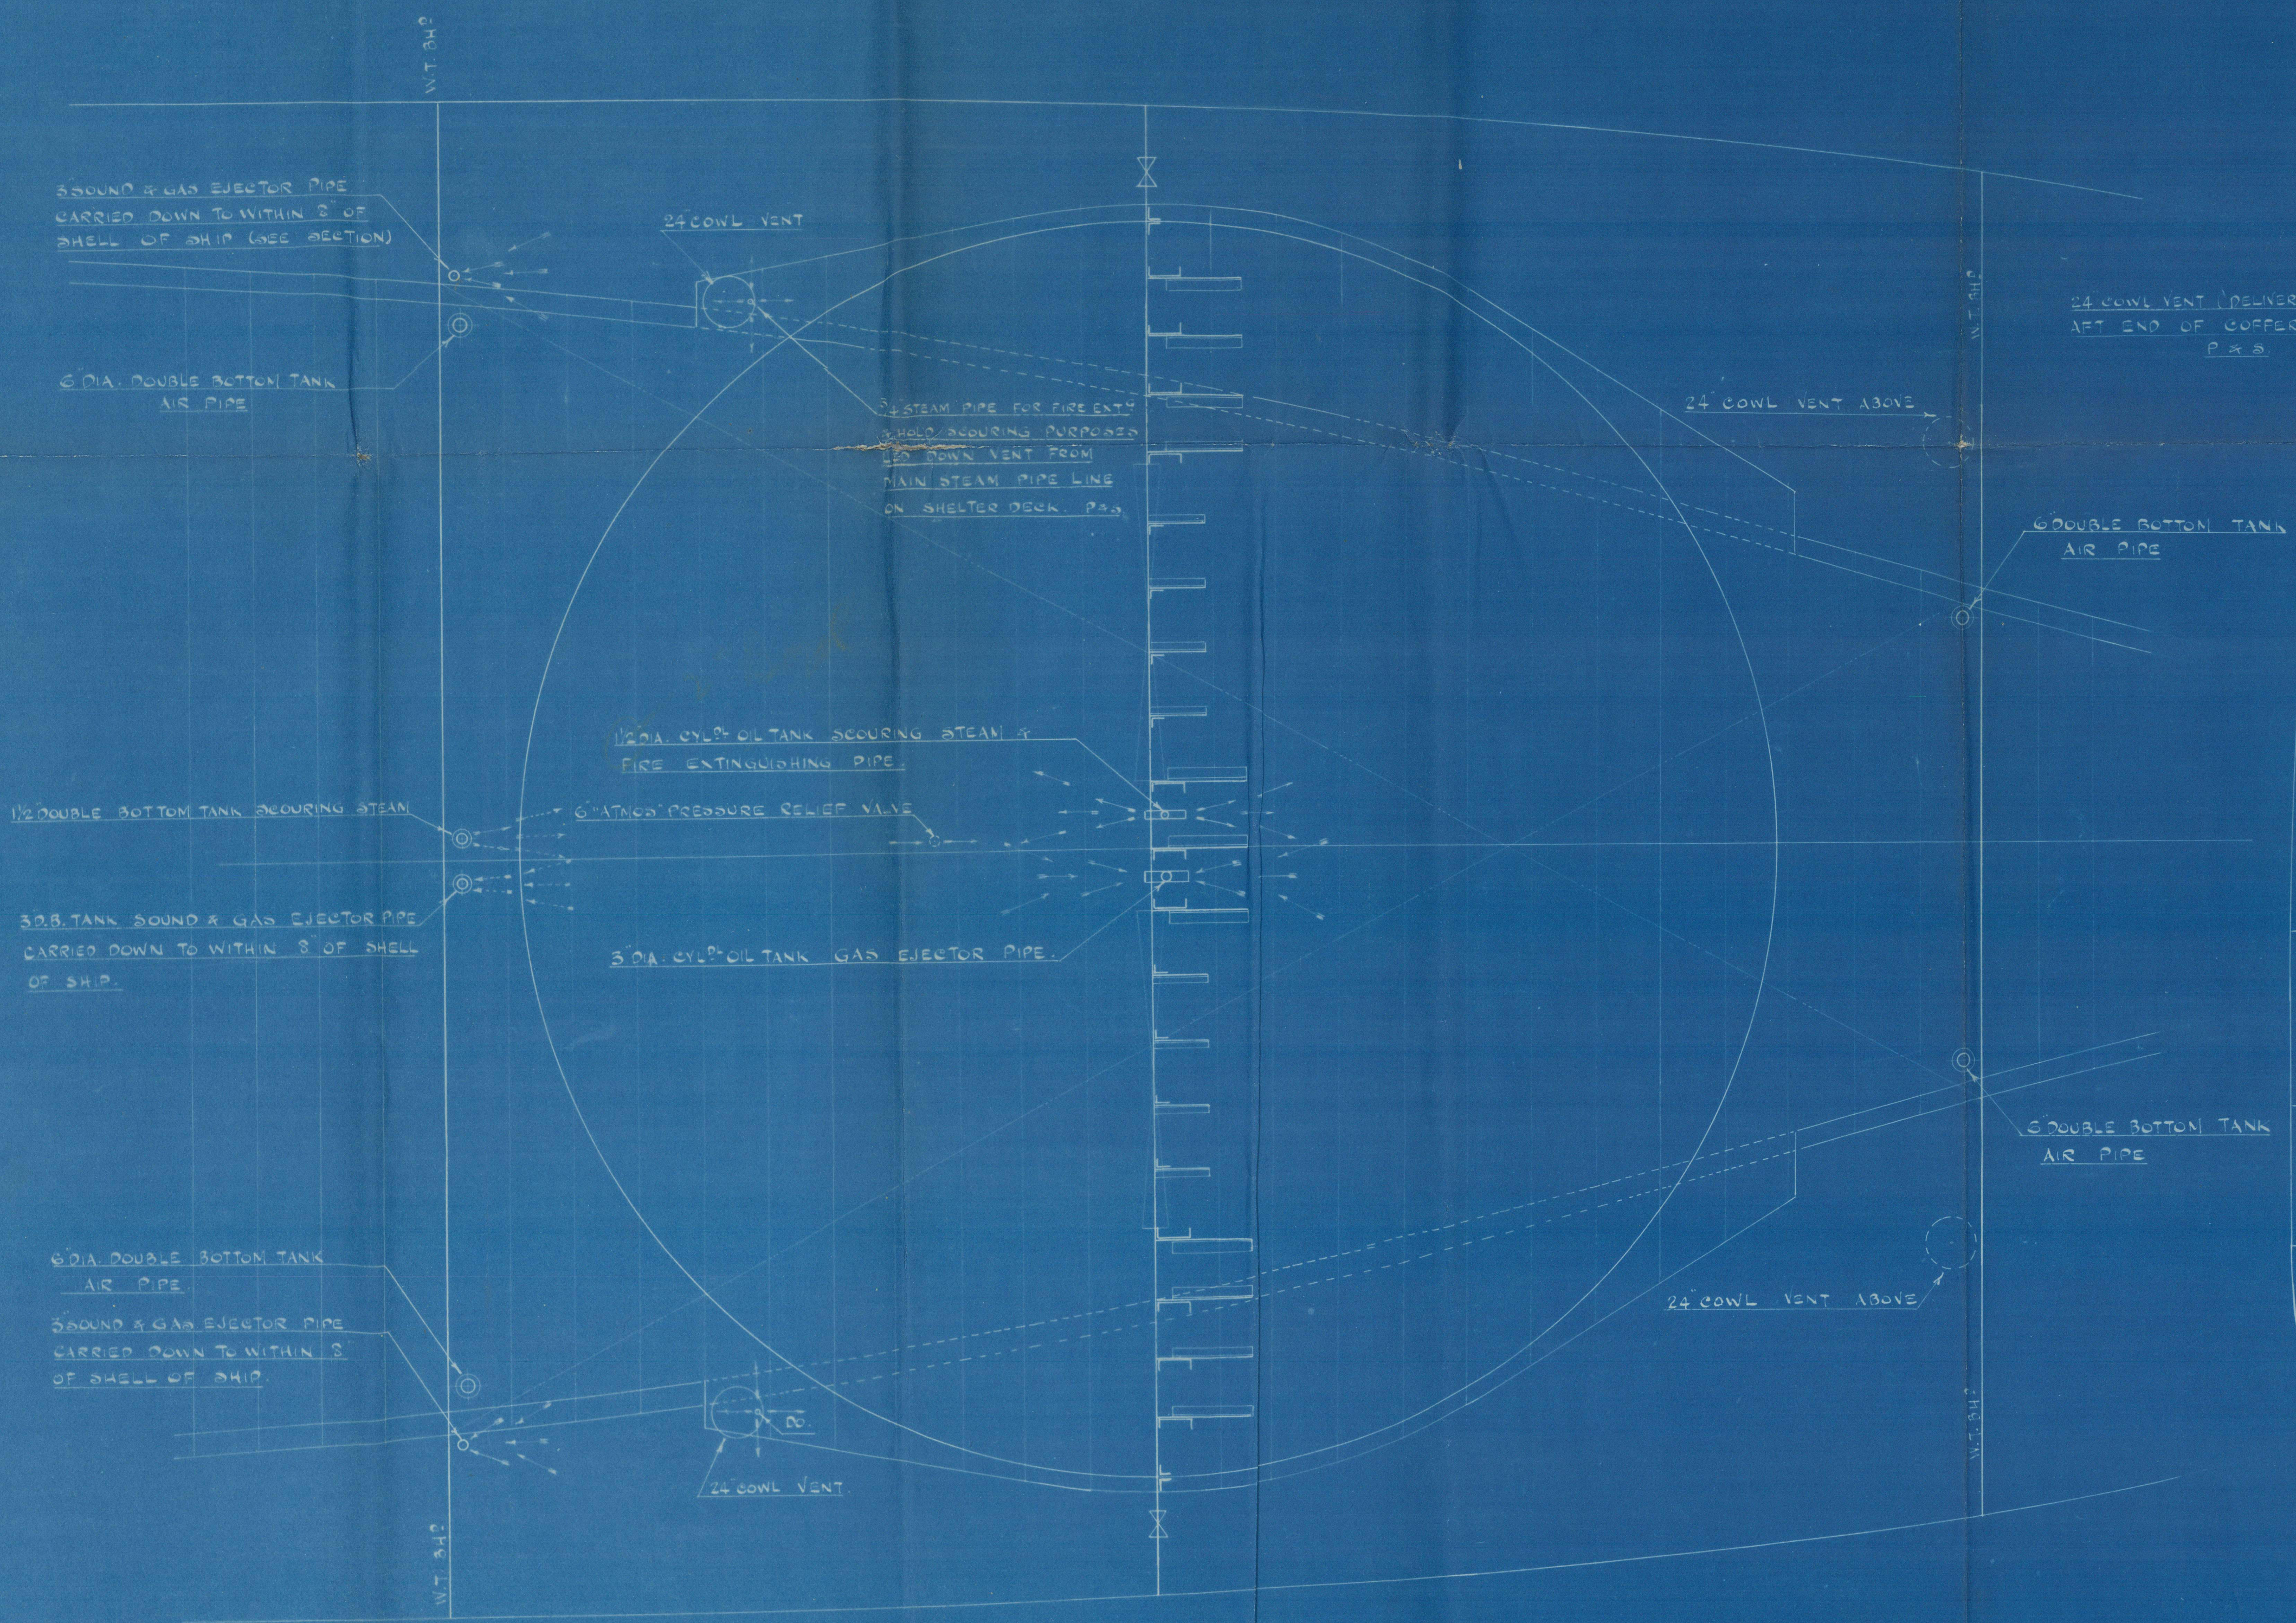

SECTION AT CRE OF CYL^{OL} TANK

27
4.8.16

HARLAND & WOLFF, LTD.,
BELFAST.


13/7/1916
THIS ENCLOSURE IS TO BE SENT TO

Messrs. Lloyd's Surveyors
Belfast

GLS281-0024 $\frac{3}{2}$

R. F. A. "Abadol"

Detail sketch showing arrangement
of connections for steaming out
and ventilating oil compartments
and coffer dam spaces.

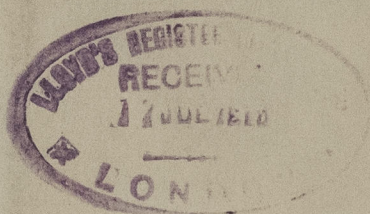

Lloyd's Register
Foundation

GLS281-0024 1/2