

# MIDSHIP SECTION


S S N<sup>o</sup> 614-15-16

410' 50.6' 32"

TO CLASS 100 A1 AT LLOYDS [3 DECKED]


[TO BE BUILT OF STEEL]

SCALE 1/2" = ONE FOOT

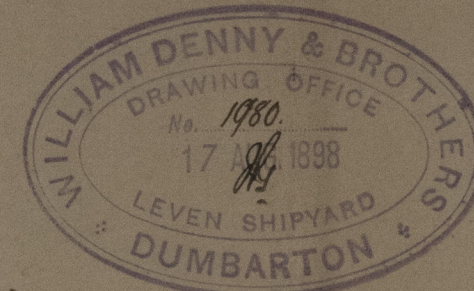

*It is recommended that the bridge and forecastle beams be fitted to every frame. The builders note under date of 26/10/98 that the above is impracticable.*

*24.8.98  
19.9.98  
12.12.98*

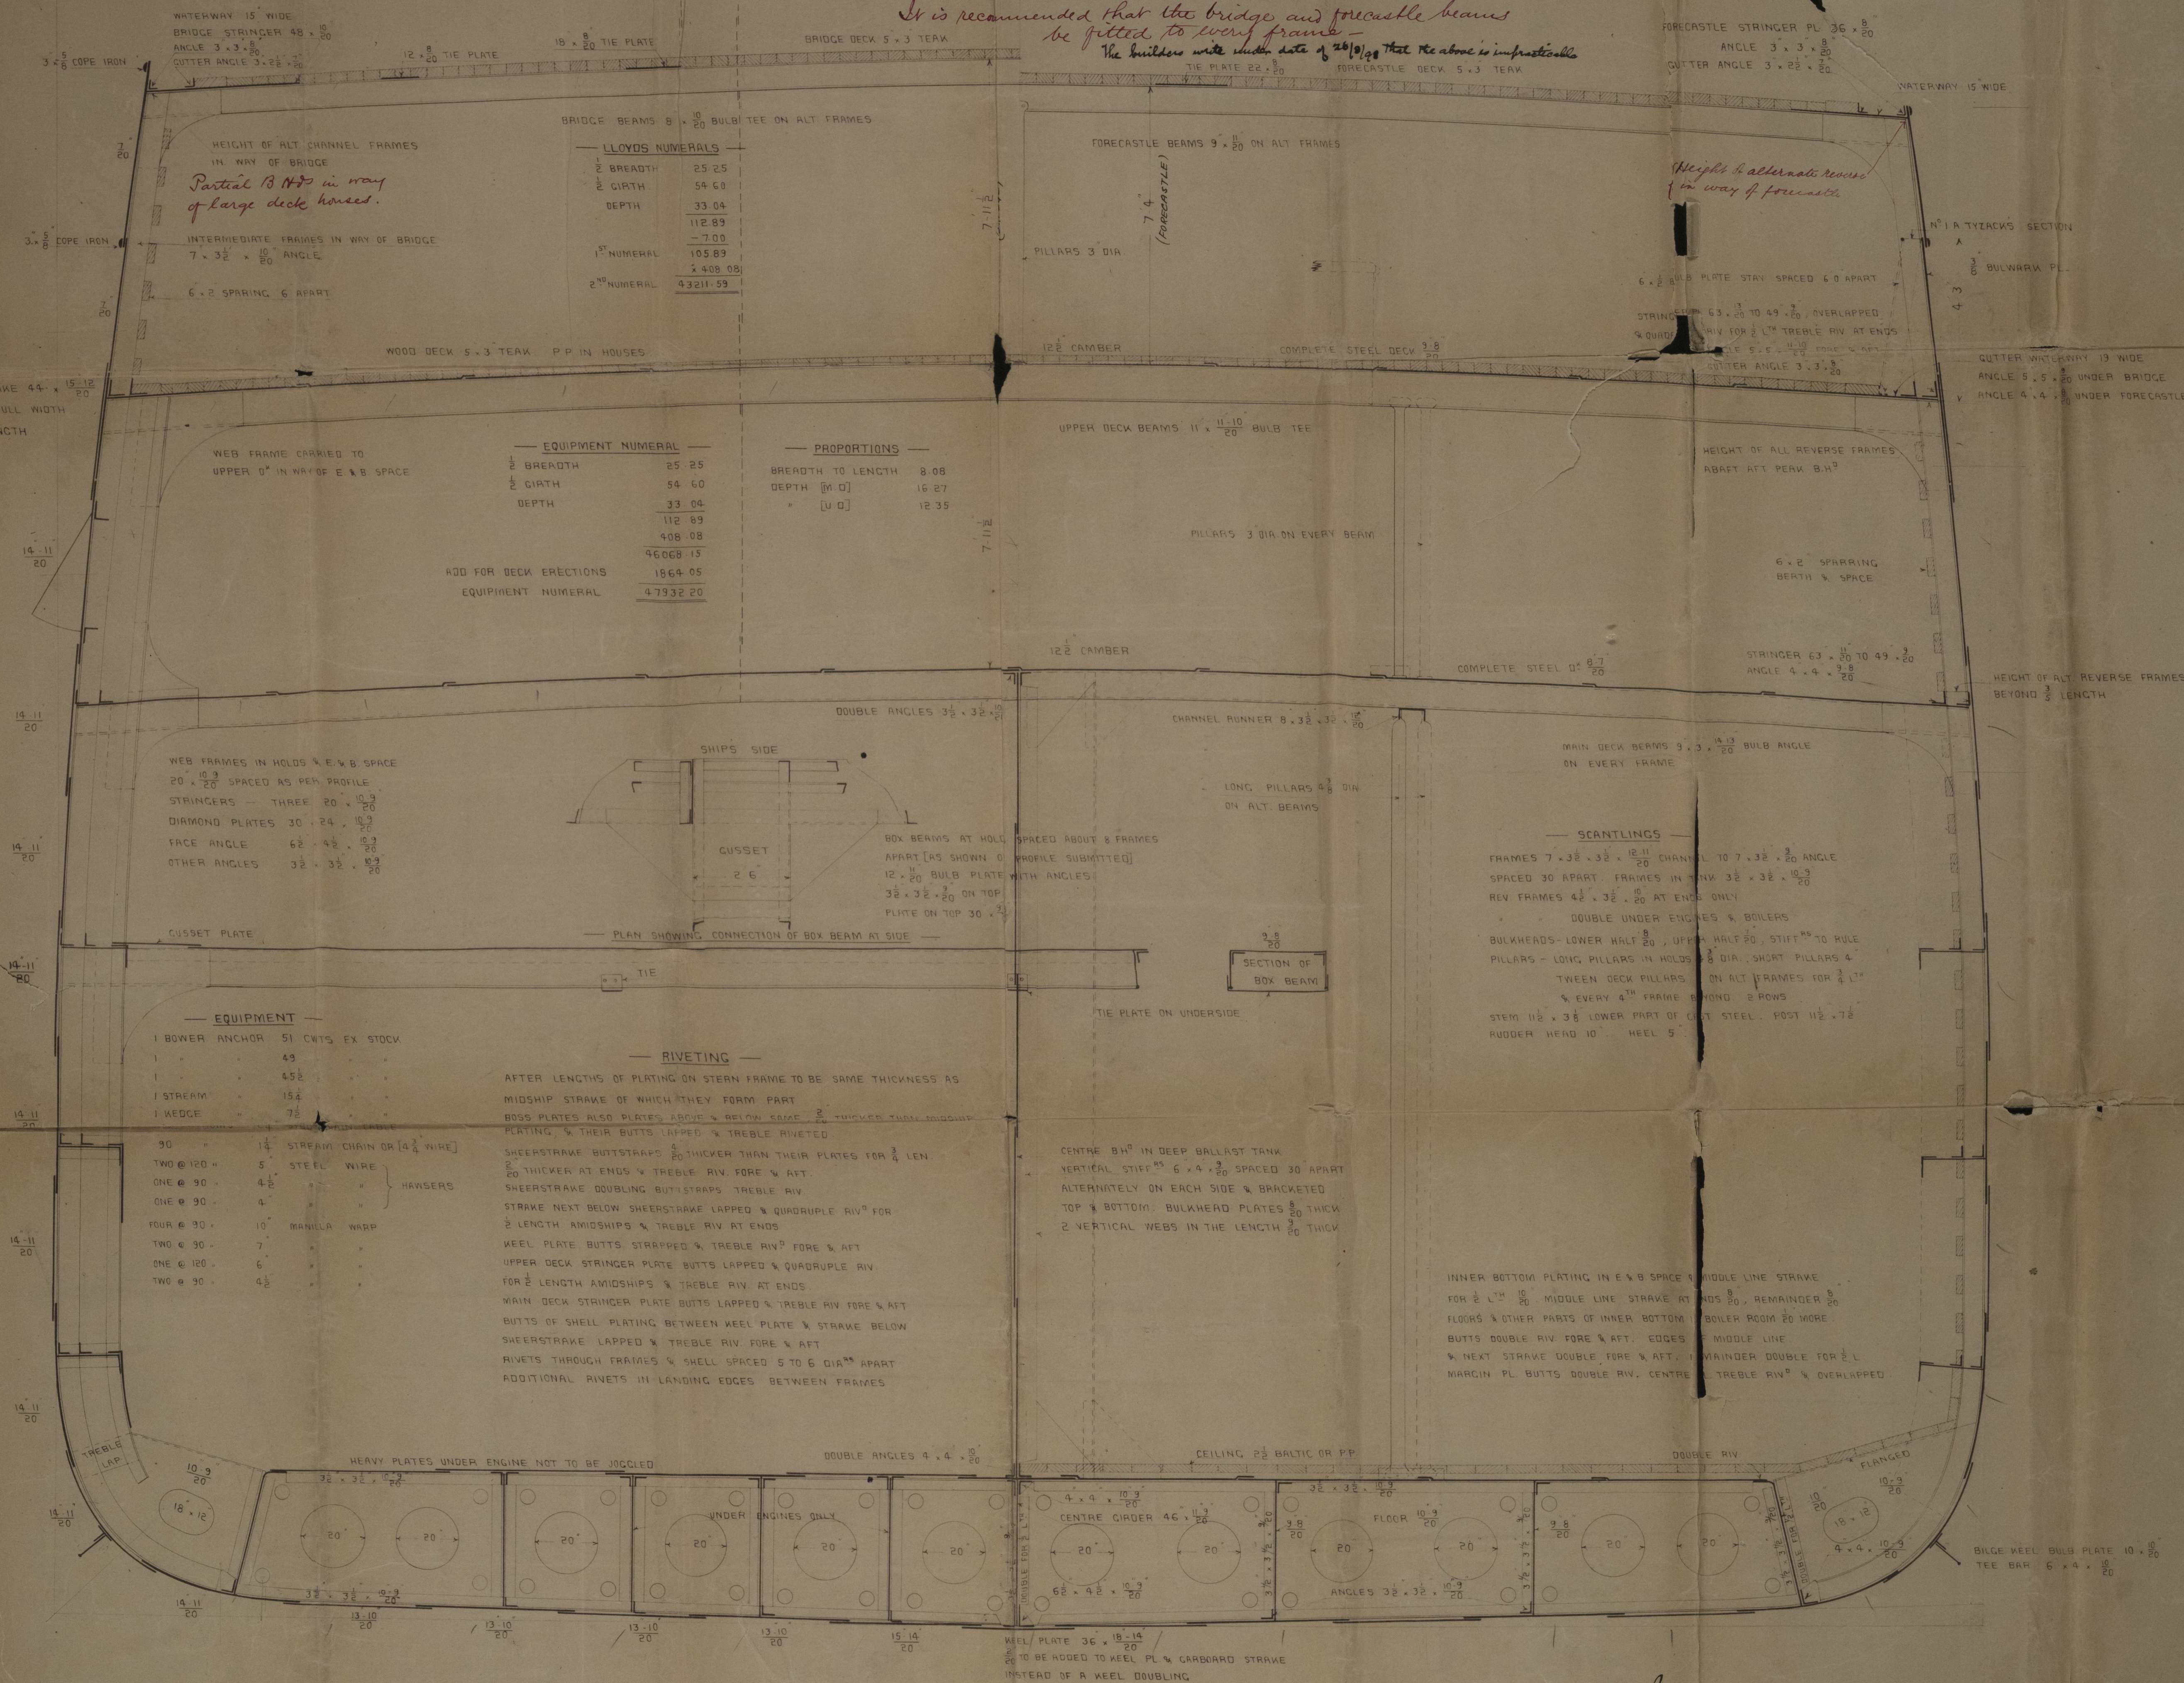

*14/6  
24/8/98*



Middle Section

W. Denny Bros & Co. 614, 15 & 16

No. 614

of "Taura"

Gl. Rept. 17617

No. 615


of "Tunda"

Gl. Rept. 17847

No. 616


of "Tola"

Gl. Rept. 18113

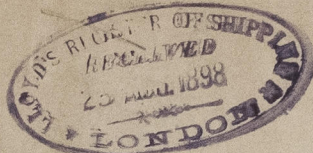


Denny Bros 614-5-6

Middle Section

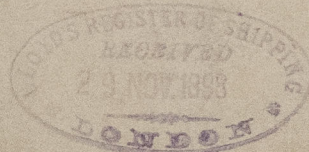

S. H. Haurani  
Gl. 17617.

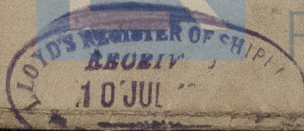

© 2021

Lloyd's Register  
Foundation

GLS28

0019



6100-482579

Mid Dec  
—



© 2021

GLS284-0019

Lloyd's Register  
Foundation



