

Lloyd's Register of British and Foreign Shipping.

(Report on Vessel No. 17617 Port Gls)

No. 6600 SHIP FORGINGS OR CASTINGS.

I have to report that the undermentioned ~~Iron or Steel Forgings or Castings~~,
 manufactured by The Humberston Forge Co.
 of Humberston for the Vessel No. 614, being built
 by Messrs. Wm. Henry & Sons of Humberston.
 have been inspected by me as set forth below, and found to be, so far as can be seen,
Sound.

Mark on Forgings.

Lloyd's

No. 6600


F.C.

Frank Cook.

Glasgow, 28/2/99

	STERN FRAME.	RUDDER FRAME.	STEM.
Material*	Scrap steel.		
How made	Forged.		
Dimensions	11 1/2" x 4 1/2"		
Progress on Inspection	Forged & omitted		
Date when Inspected	9/9/98 to 10/2/99.		

SKETCHES OF FRAMES SHOWING POSITION AND DESCRIPTION OF WELDS OF FORGINGS, OR PARTICULARS OF TESTS APPLIED TO CASTINGS.

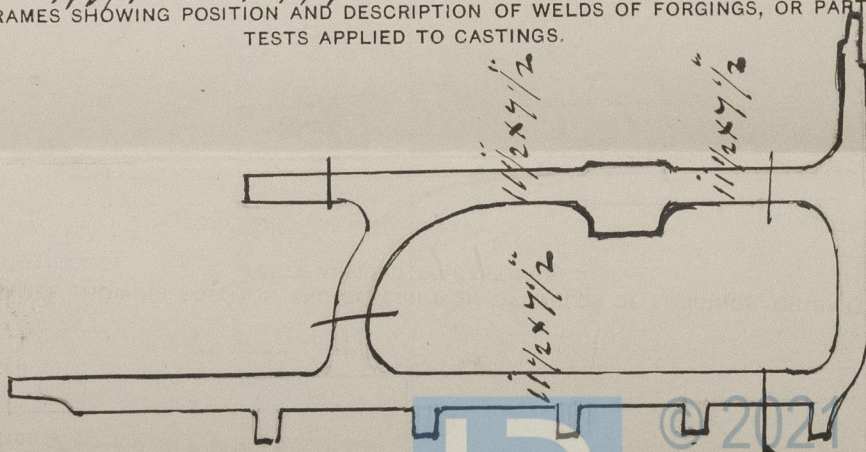

Fee (if any chargeable) £

To be paid at

Glasgow, 28/2/99

Lloyd's Register
Foundation

614



© 2021

Lloyd's Register
Foundation