
 


19. 24.8.98
2. 12.98

260

Cancelled

PROFILE
S.S. N^{os} 614-15-16
SCALE 1/8 INCH = 1 FOOT.

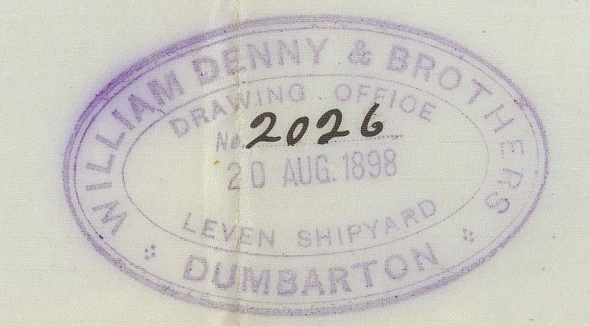

*alter arrangement of
strong beams in hull
as approved for last higher
who need 150
and required by owner
9/8/98*

FORECASTLE

CARGO FOR

W.T. PLAT

KNED

PLATE

LEV. UPPER

Whenny Bros'
No 614 S/S Staura
Gps Rpt No. 17617

No 615
S/S "Stinda"
Gps Rpt. No. 17852

No 616 "
S/S Stola
Gps Rpt. 18113







© 2021
Lloyd's Register
Foundation

72026