
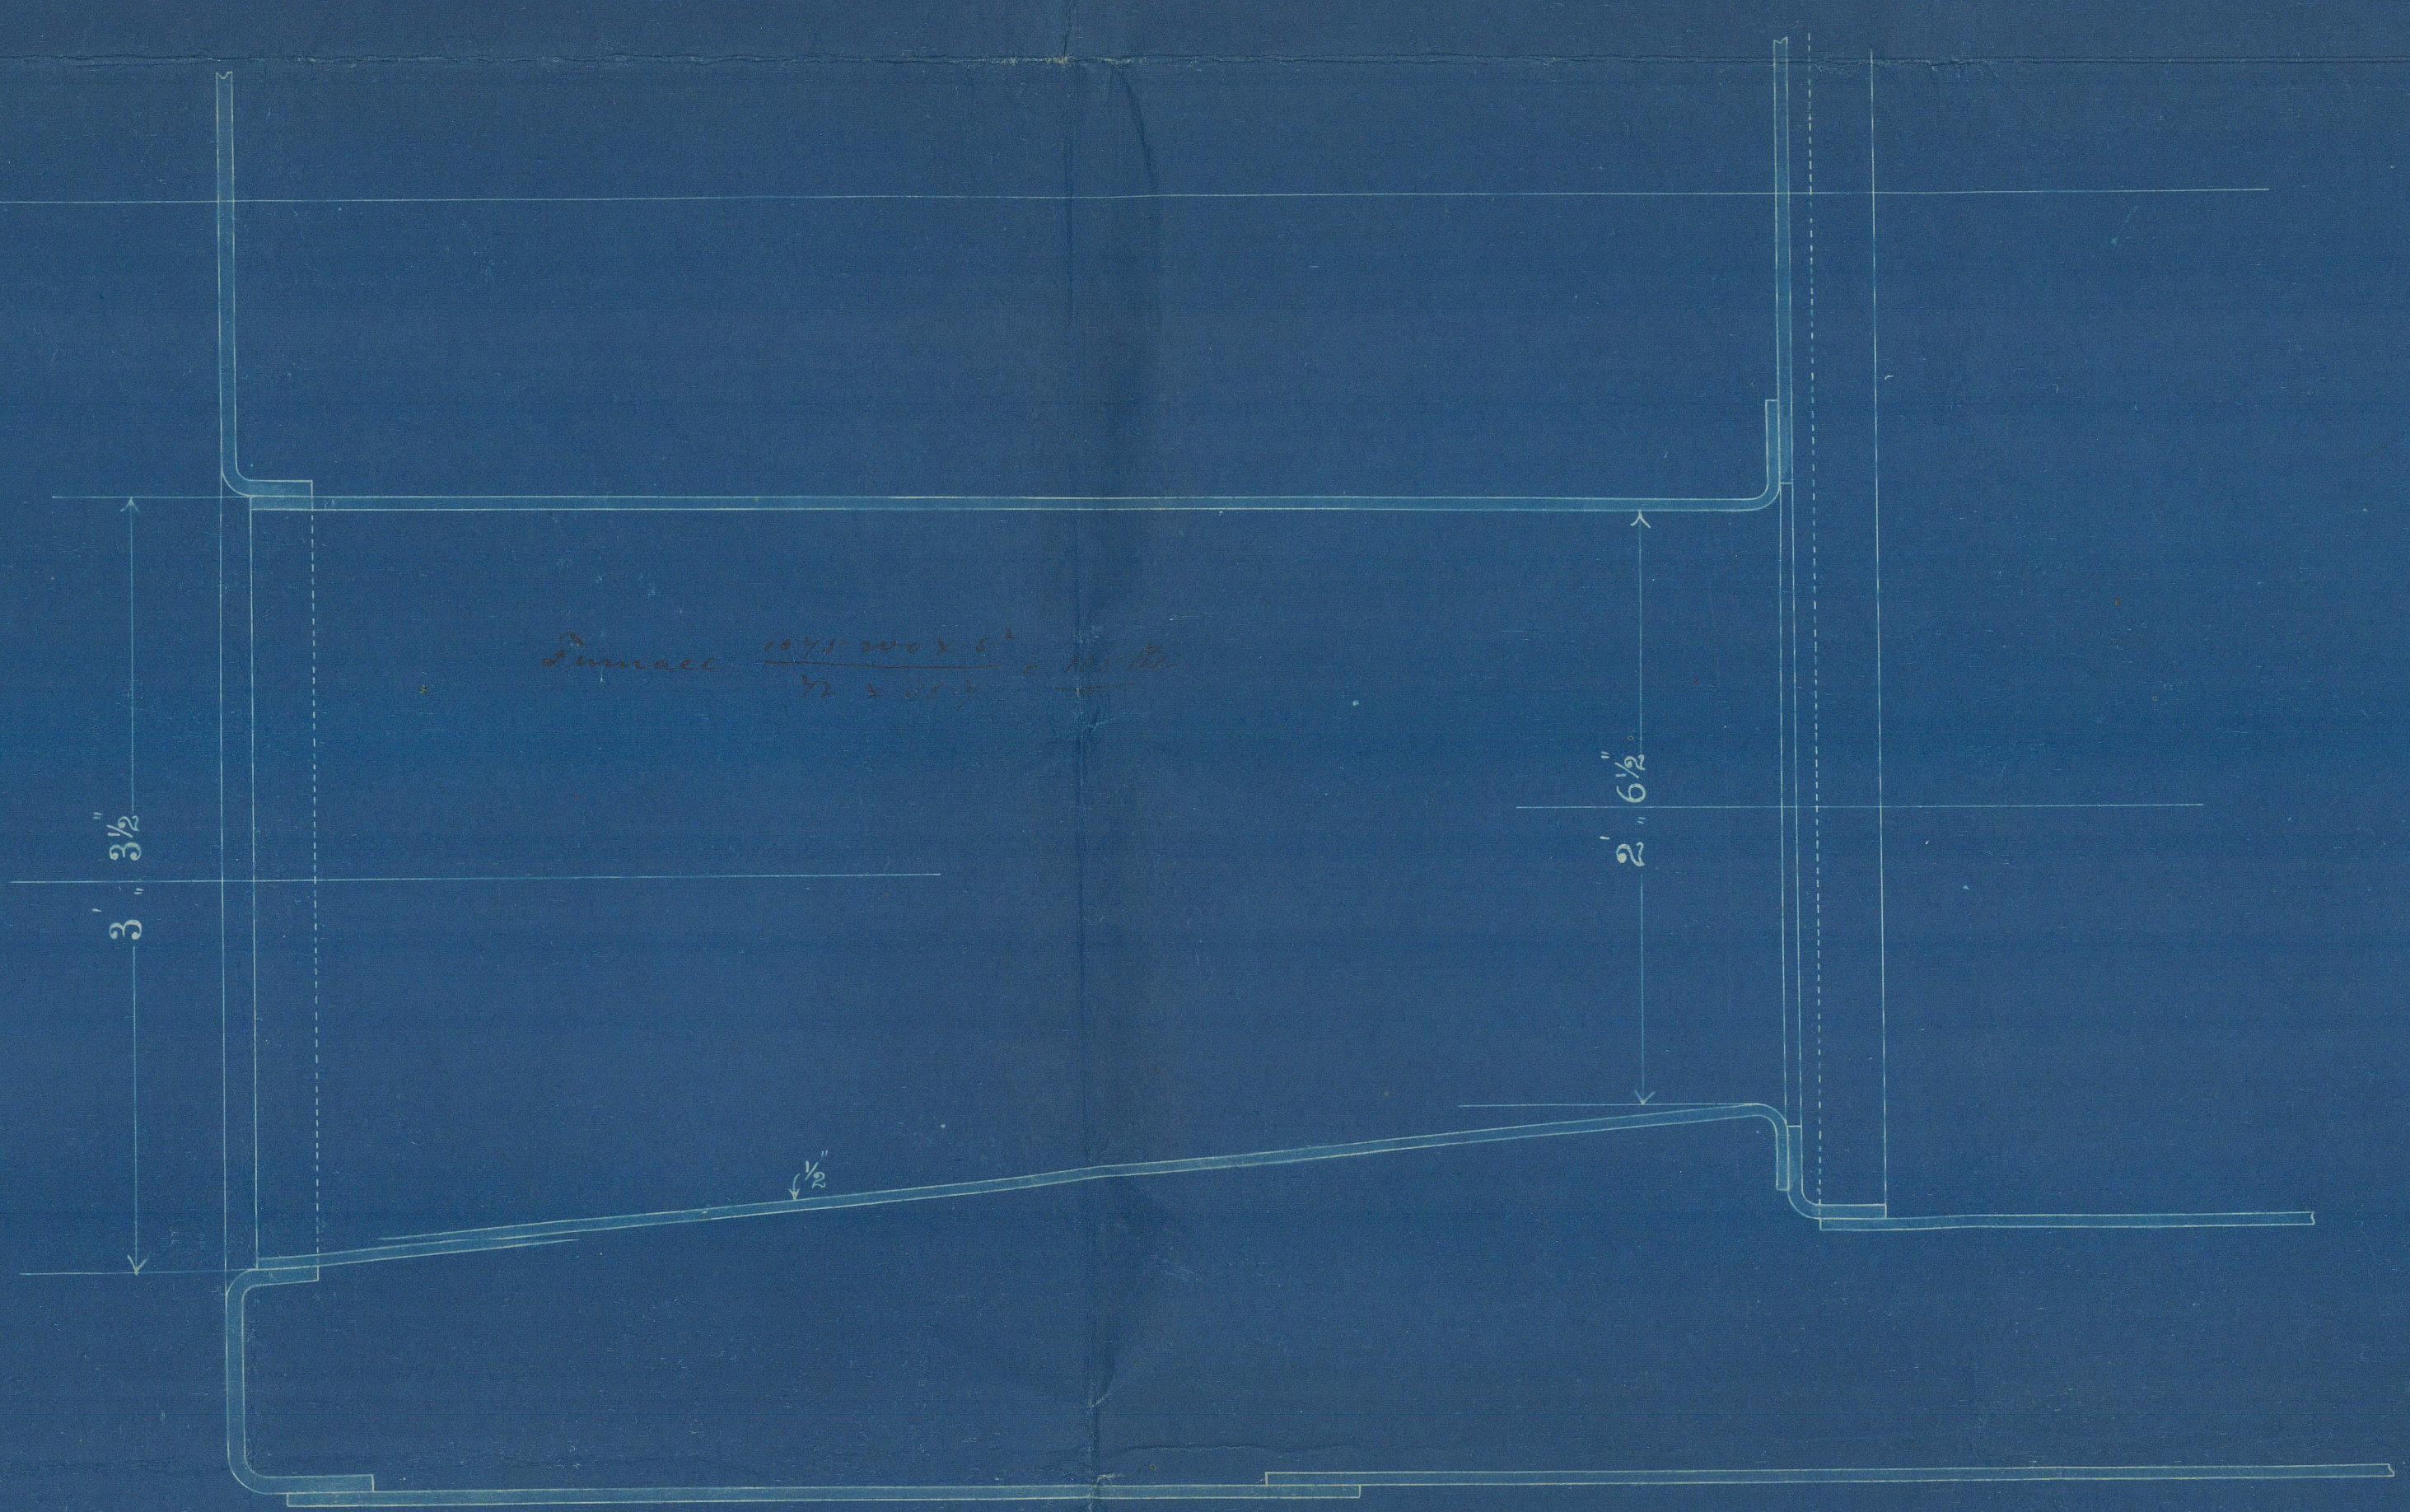


119  
2998

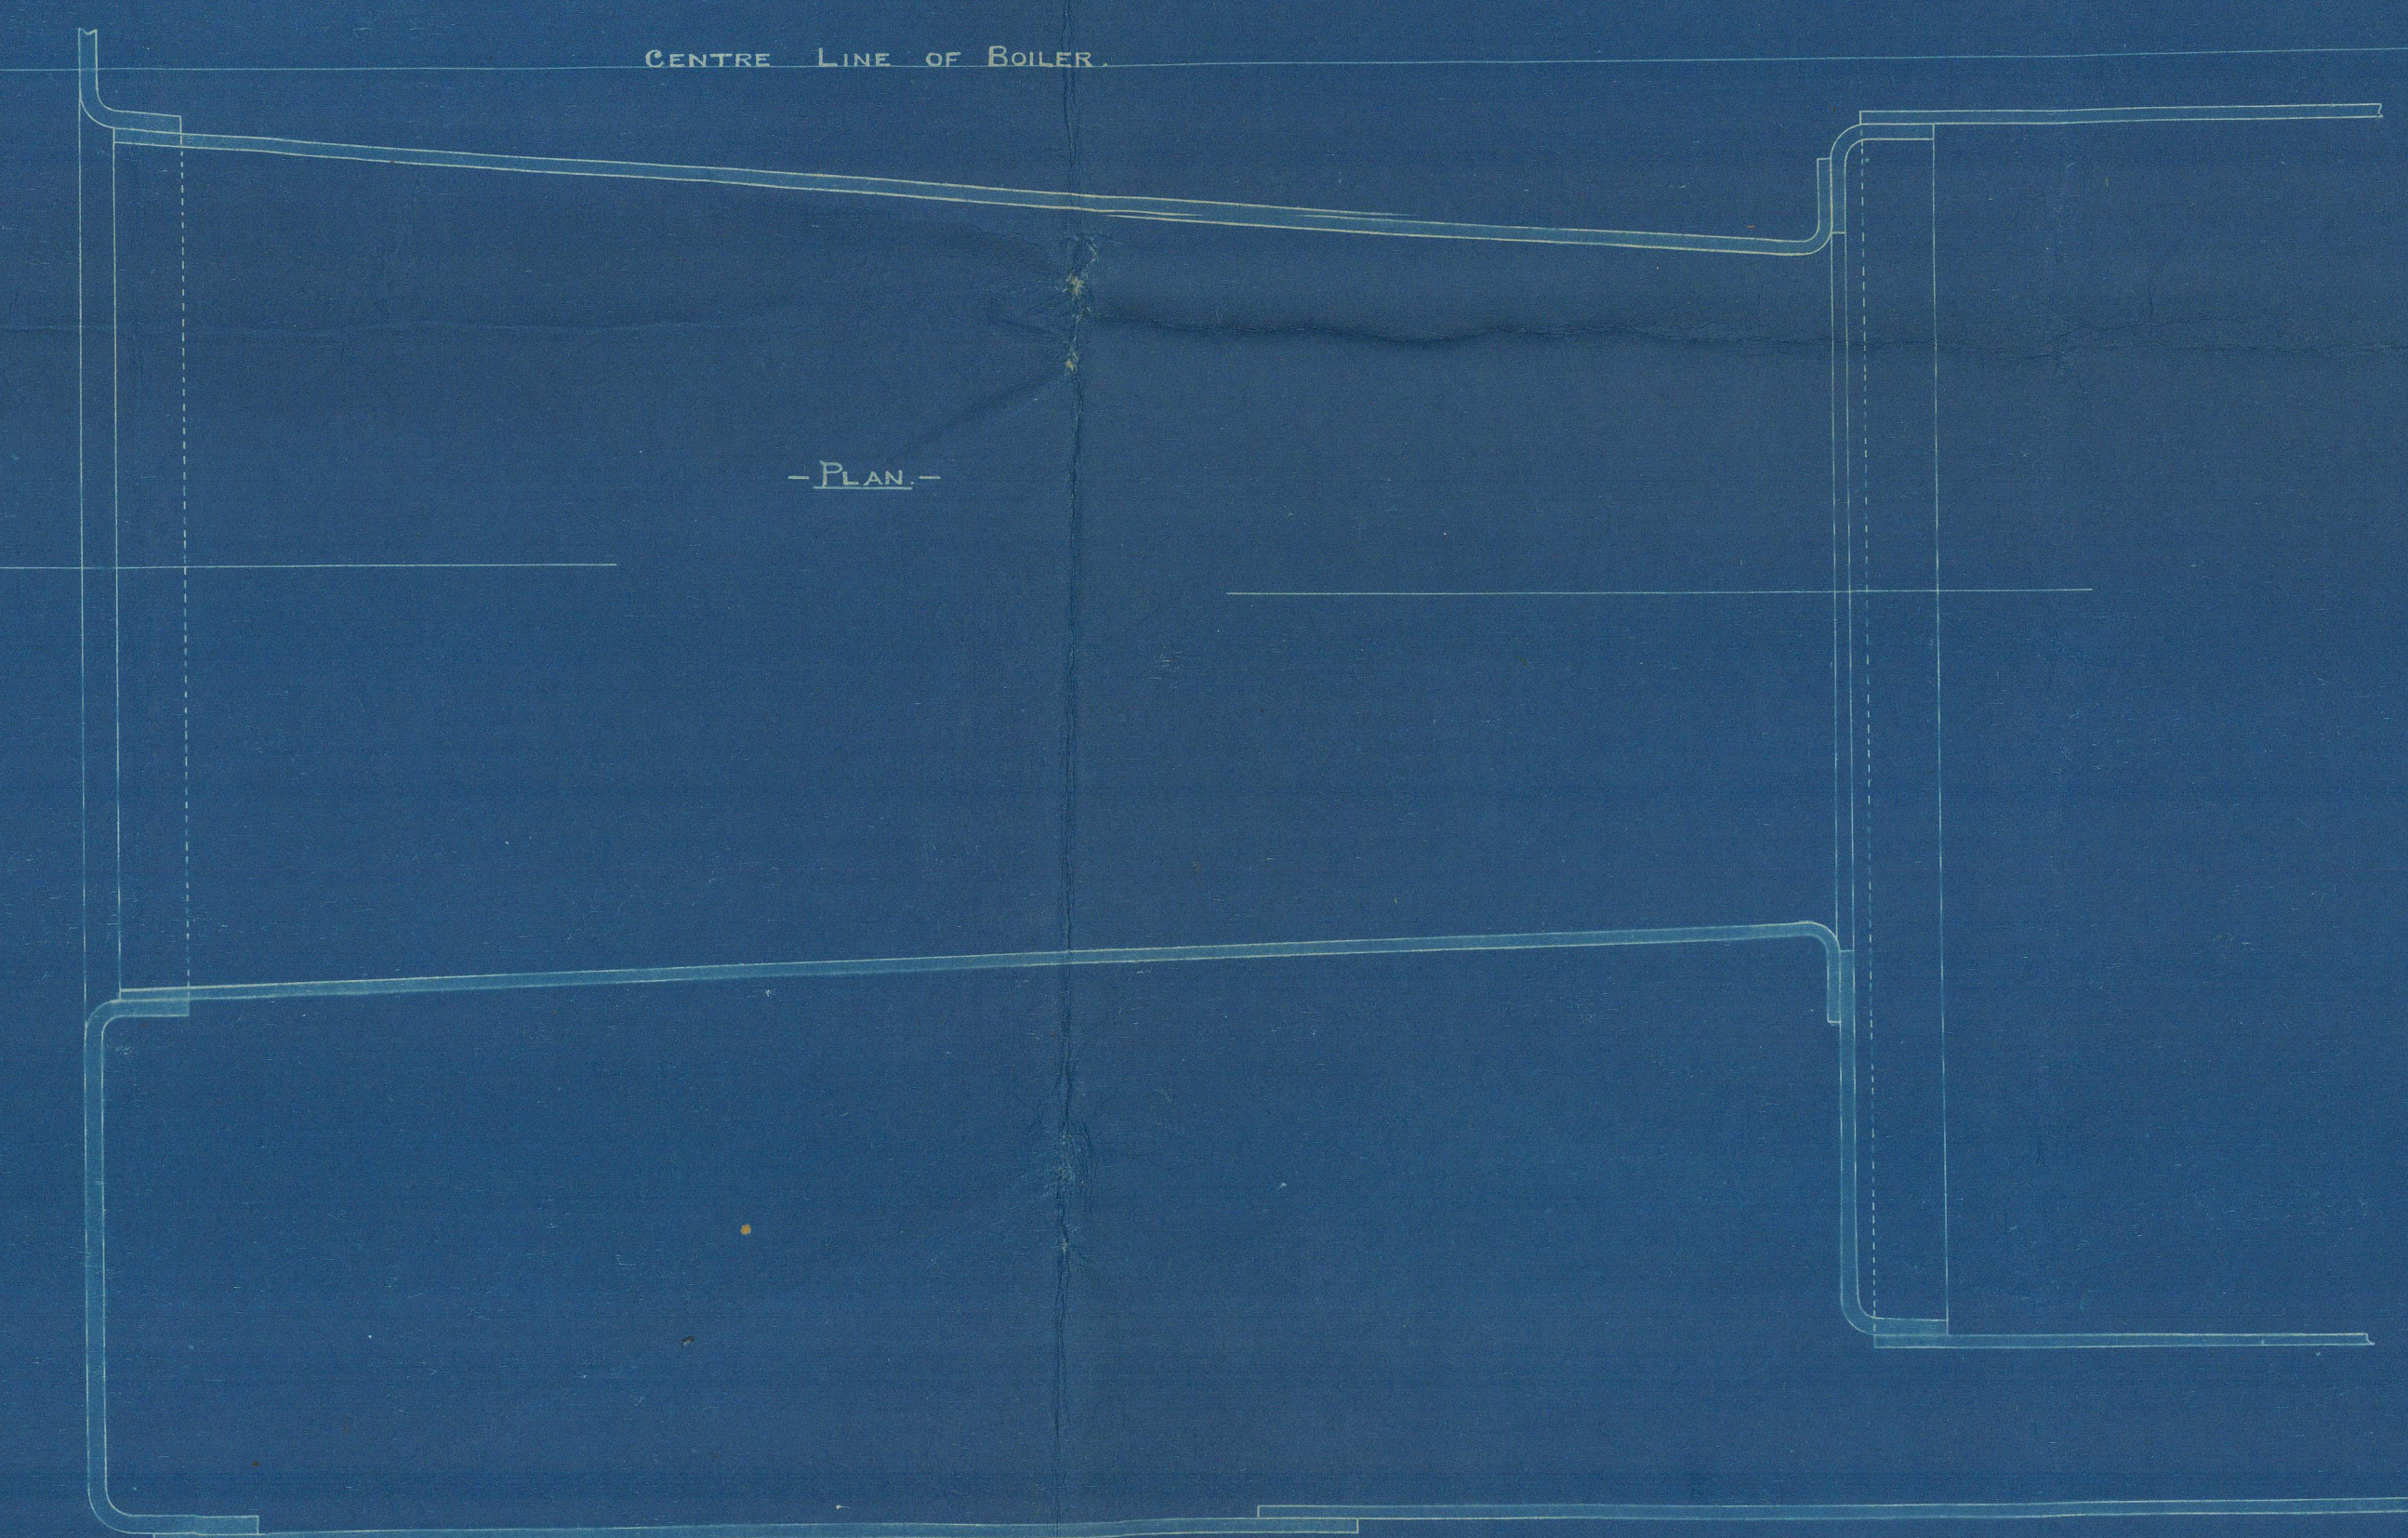

DONKEY BOILER,  
N<sup>OS</sup> 488-9-90.

1 1/2" SCALE

*Proposed alteration of furnaces*  
*Working pressure 80 lbs per sq in.*

*KLH*  
*29*



Amendment in Furnaces of

Donkey Boilers for

Messrs Denny & Co. n° 614-5-6-7

Messrs Denny & Co. n° 614-8-9-10



S.S. "Itola" n° 616

Glasgow Report

No. 18113

S/S. Laura (n° 614) n° 17617

S/S. Maude (615) n° 17847



© 2021

Lloyd's Register  
Foundation