


R. Napier & Sons

N^o 466 + 4

St. ^{Lagus} ^{GLS 17426}
St. Trent

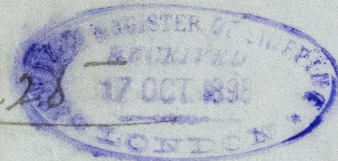

Amended ^{GLS Rpt No 17664}

Pumping Plan.

GLS 288-0064



© 2019

Lloyd's Register
Foundation