

Es. Hunt
For the information of Surveyors and the Committee only.

Received at _____ Office _____ 189

Lloyd's Register of British and Foreign Shipping.

(Report on Vessel No. 17664 Port Glo)

Glasgow

No. 3949.a. SHIP FORGINGS OR CASTINGS.

The words FORGINGS or CASTINGS, IRON or STEEL, should be struck out as may be required.

I have to report that the undermentioned Iron or ~~Steel~~ Forgings or Castings, manufactured by The Dalington Forge Co. of Dalington for the Vessel No. 467, being built by Messrs R Napier Sons of Glasgow have been inspected by me as set forth below, and found to be, so far as can be seen, sound.

Mark on Forgings.

Lloyd's
No. 3949a
No. 6.


Wugh Cameron

*Sunderland
14/10/99.*

	STERN FRAME.	RUDDER FRAME.	STEM.
Material*	<i>Scrap Iron</i>	<i>Scrap Iron</i>	<i>Scrap Iron</i>
How made	<i>Forged</i>	<i>Forged</i>	<i>Forged</i>
Dimensions	<i>as per plan attached</i>	<i>11 1/2 - 5 1/4</i>	<i>11 1/2 x 3 1/8</i>
Progress on Inspection	<i>Forged & Smithed</i>	<i>Forged & Smithed</i>	<i>Forged</i>
Date when Inspected	<i>Oct 7th 1898 to Jan 13/99</i>	<i>June 5th to Sept 14/99</i>	<i>Sept 16/98</i>

SKETCHES OF FRAMES SHOWING POSITION AND DESCRIPTION OF WELDS OF FORGINGS, OR PARTICULARS OF TESTS APPLIED TO CASTINGS.


Welds

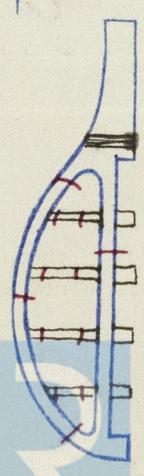

Fee (if any chargeable) £ : :

To be paid at _____

* If of Iron, state whether scrap or puddled Iron.