


GLS285 0080

Messrs S. McFinght & Co
No. 58. 5/5 Val de Traverso

Glo. pr. No. 17666

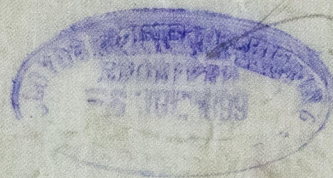

© 2019

Lloyd's Register
Foundation

7.4.99


S. S. 1/2 58.

Midship Section

To Class 100. R.I. at Lloyds (Steel)

Length 200'-0" - Breadth 36'-6" - Depth 14'-0"

Scale 1/2 Inch = one foot.

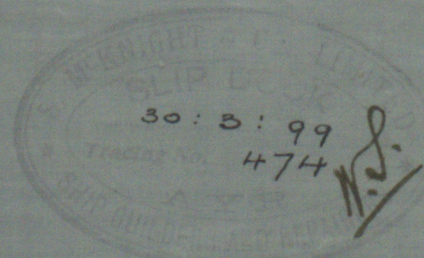

Proportions
Depth to Length (M.D.) 13.60
Depth to Length (L.D.D.) 10.68
Breadth to Length 6.52

Numeral
1/2 Girth 27.00
1/2 Breadth 15.25
Depth 14.625
56.875 - 1st Numeral
198.84
11309.025 - 2nd Numeral

Equipment Numeral.


11309.025 x 8 x .72 = 1017.81 + 11309.025 = 12326.835 Eqa H

Erections.

2. Deck + Roping 116.0
Forecastle 27.0
148.0

Riveting.

Butts of all strakes below sheerstrake, except keel, to be lapped and treble riveted for full length double at ends. Butts of keel, treble riveted, straps 3/4" thicker than the plates they connect for 3' length. Butts of sheerstrake, treble riveted with straps 3/4" thicker than the plates they connect for 3' length amidships, double at ends. Butts of deck stringer plate, lapped and treble riveted for 3' length amidships, double at ends. Butts of deck plating, lapped and double riveted for 3' length amidships, double at ends. Butts of side plating above sheerstrake, shopped and double riveted, 3' in way of break as for top side plate submitted. Butts of bulwark, shopped and single riveted. Butts of lower side strake, lapped and double riveted, remains lapped and single riveted. Butts of margin plate, lapped & double riveted.

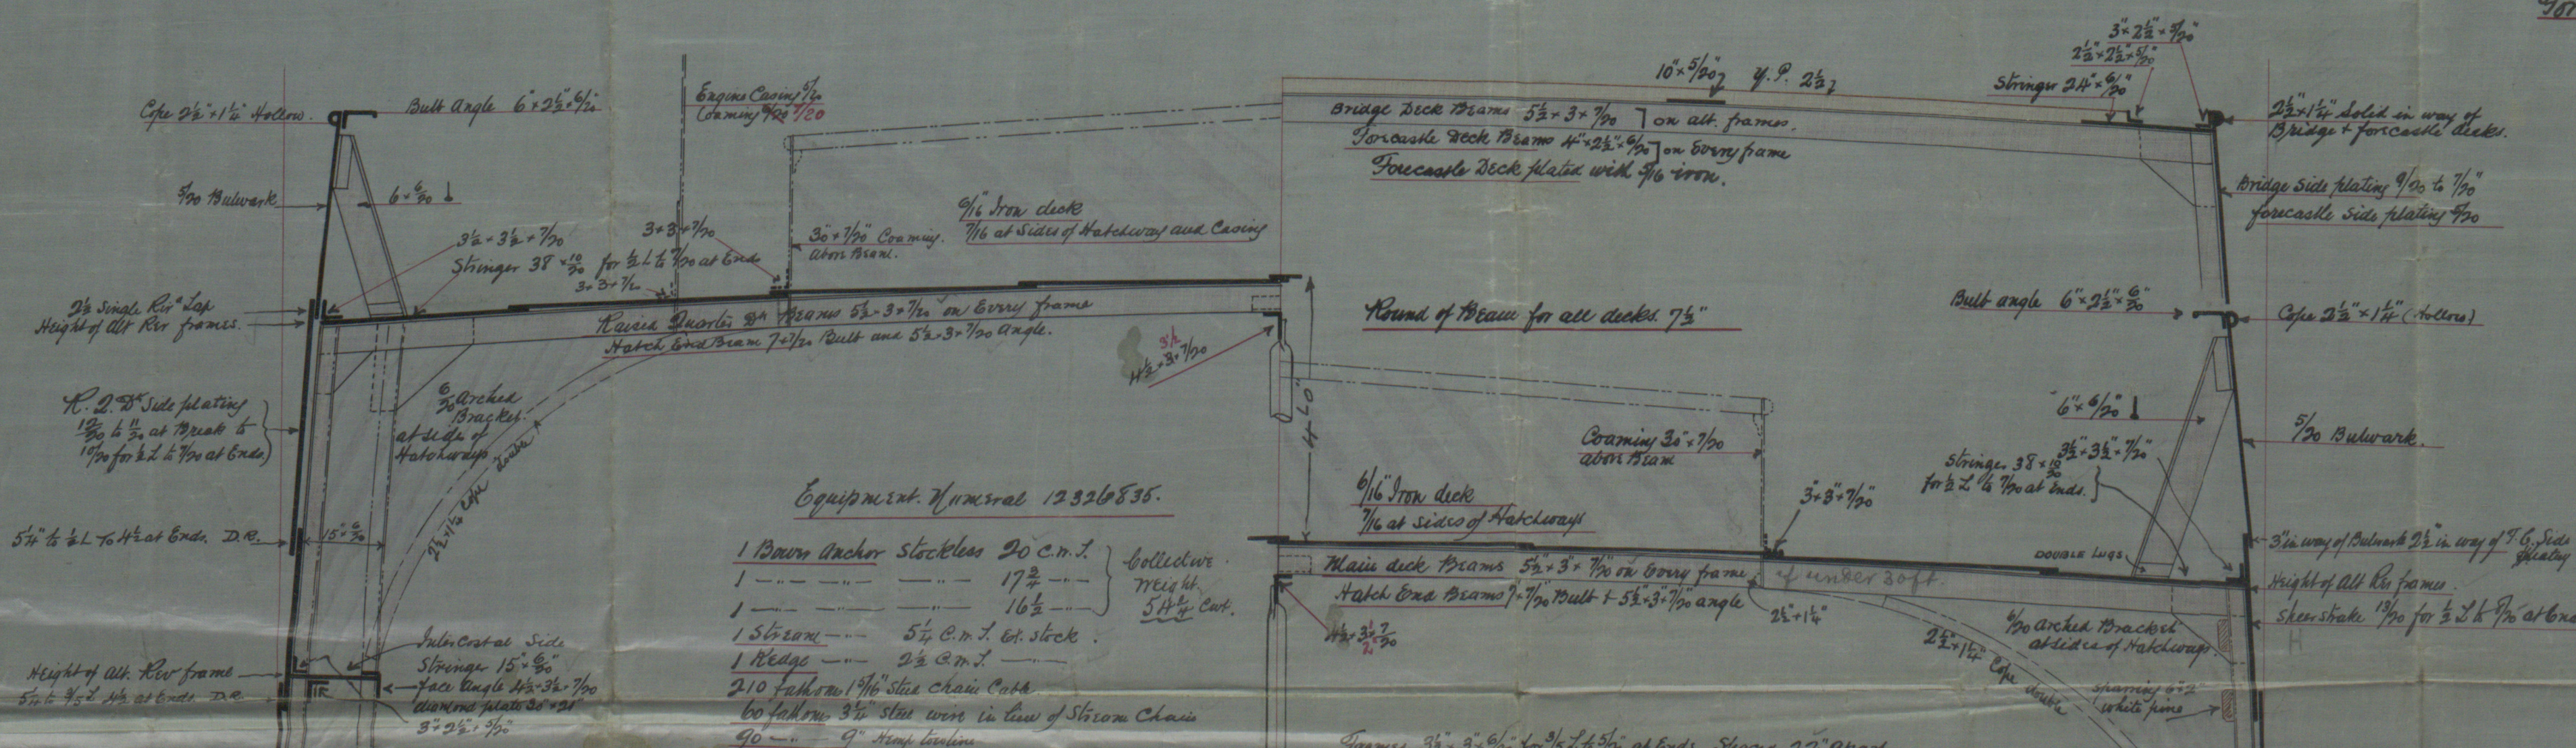

Equipment Numeral 13326835.

1 Bow Anchor Stockless 20 c.m.t. 17 1/2
1 --- 16 1/2
1 --- 5 1/2 c.m.t. 6t stock
1 --- 2 1/2 c.m.t.
210 fathoms 1 1/2 inch steel chain cable
60 fathoms 3/4 inch steel wire in line of stream chain
40 --- 9' Hemp line