




S. McKnight to Messrs  
 Ed. Valde Travers  
 Glasgow No. 1766



GLS285-0081

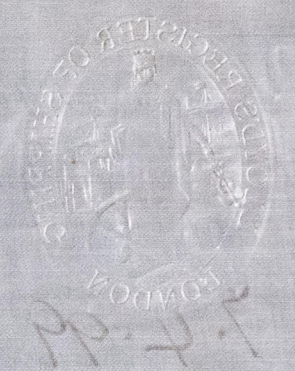

© 2019  
 Lloyd's Register  
 Foundation




7.4.99


- / Single Riveted Butt
- // Double
- /// Triple

S.S.N° 58

SKETCH SHEWING ARRANGEMENT OF SHEER STRAKE ETC, PLATING - SCALE 1/8" - 1 FT.

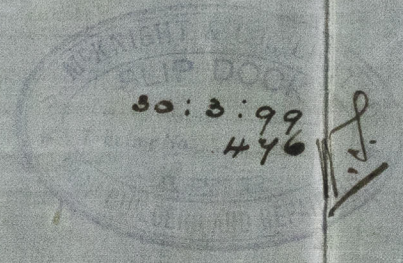

*Over the main deck  
remains to be  
done at the present*

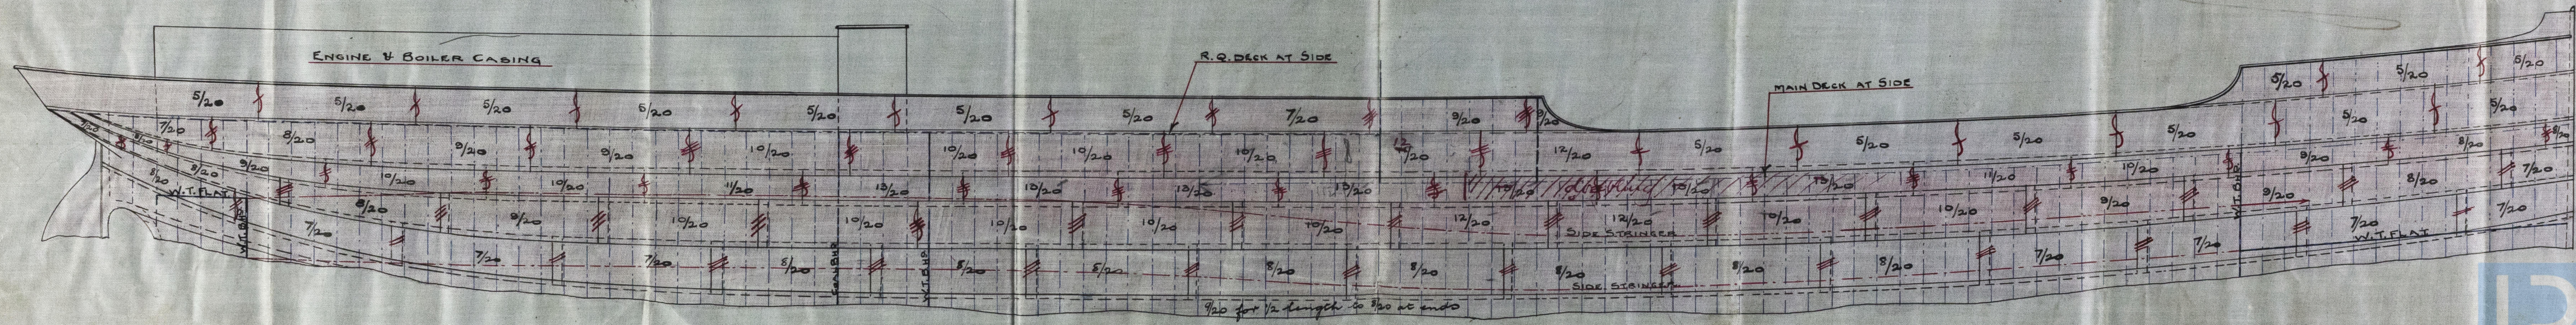


*doubling to beyond large hatchway*