

Mills' Steel Main Bolt
No. 798
- 490 Supers

by
Ross & Duncan
for
Smith & Co. 168th St. N.Y.C.

160 lbs. working press.



5/5 "Val de Travers"

Glo rpt No. 14666.





GLS285-0083

© 2019

Lloyd's Register
Foundation



Mr. J. H. Knight
3:16

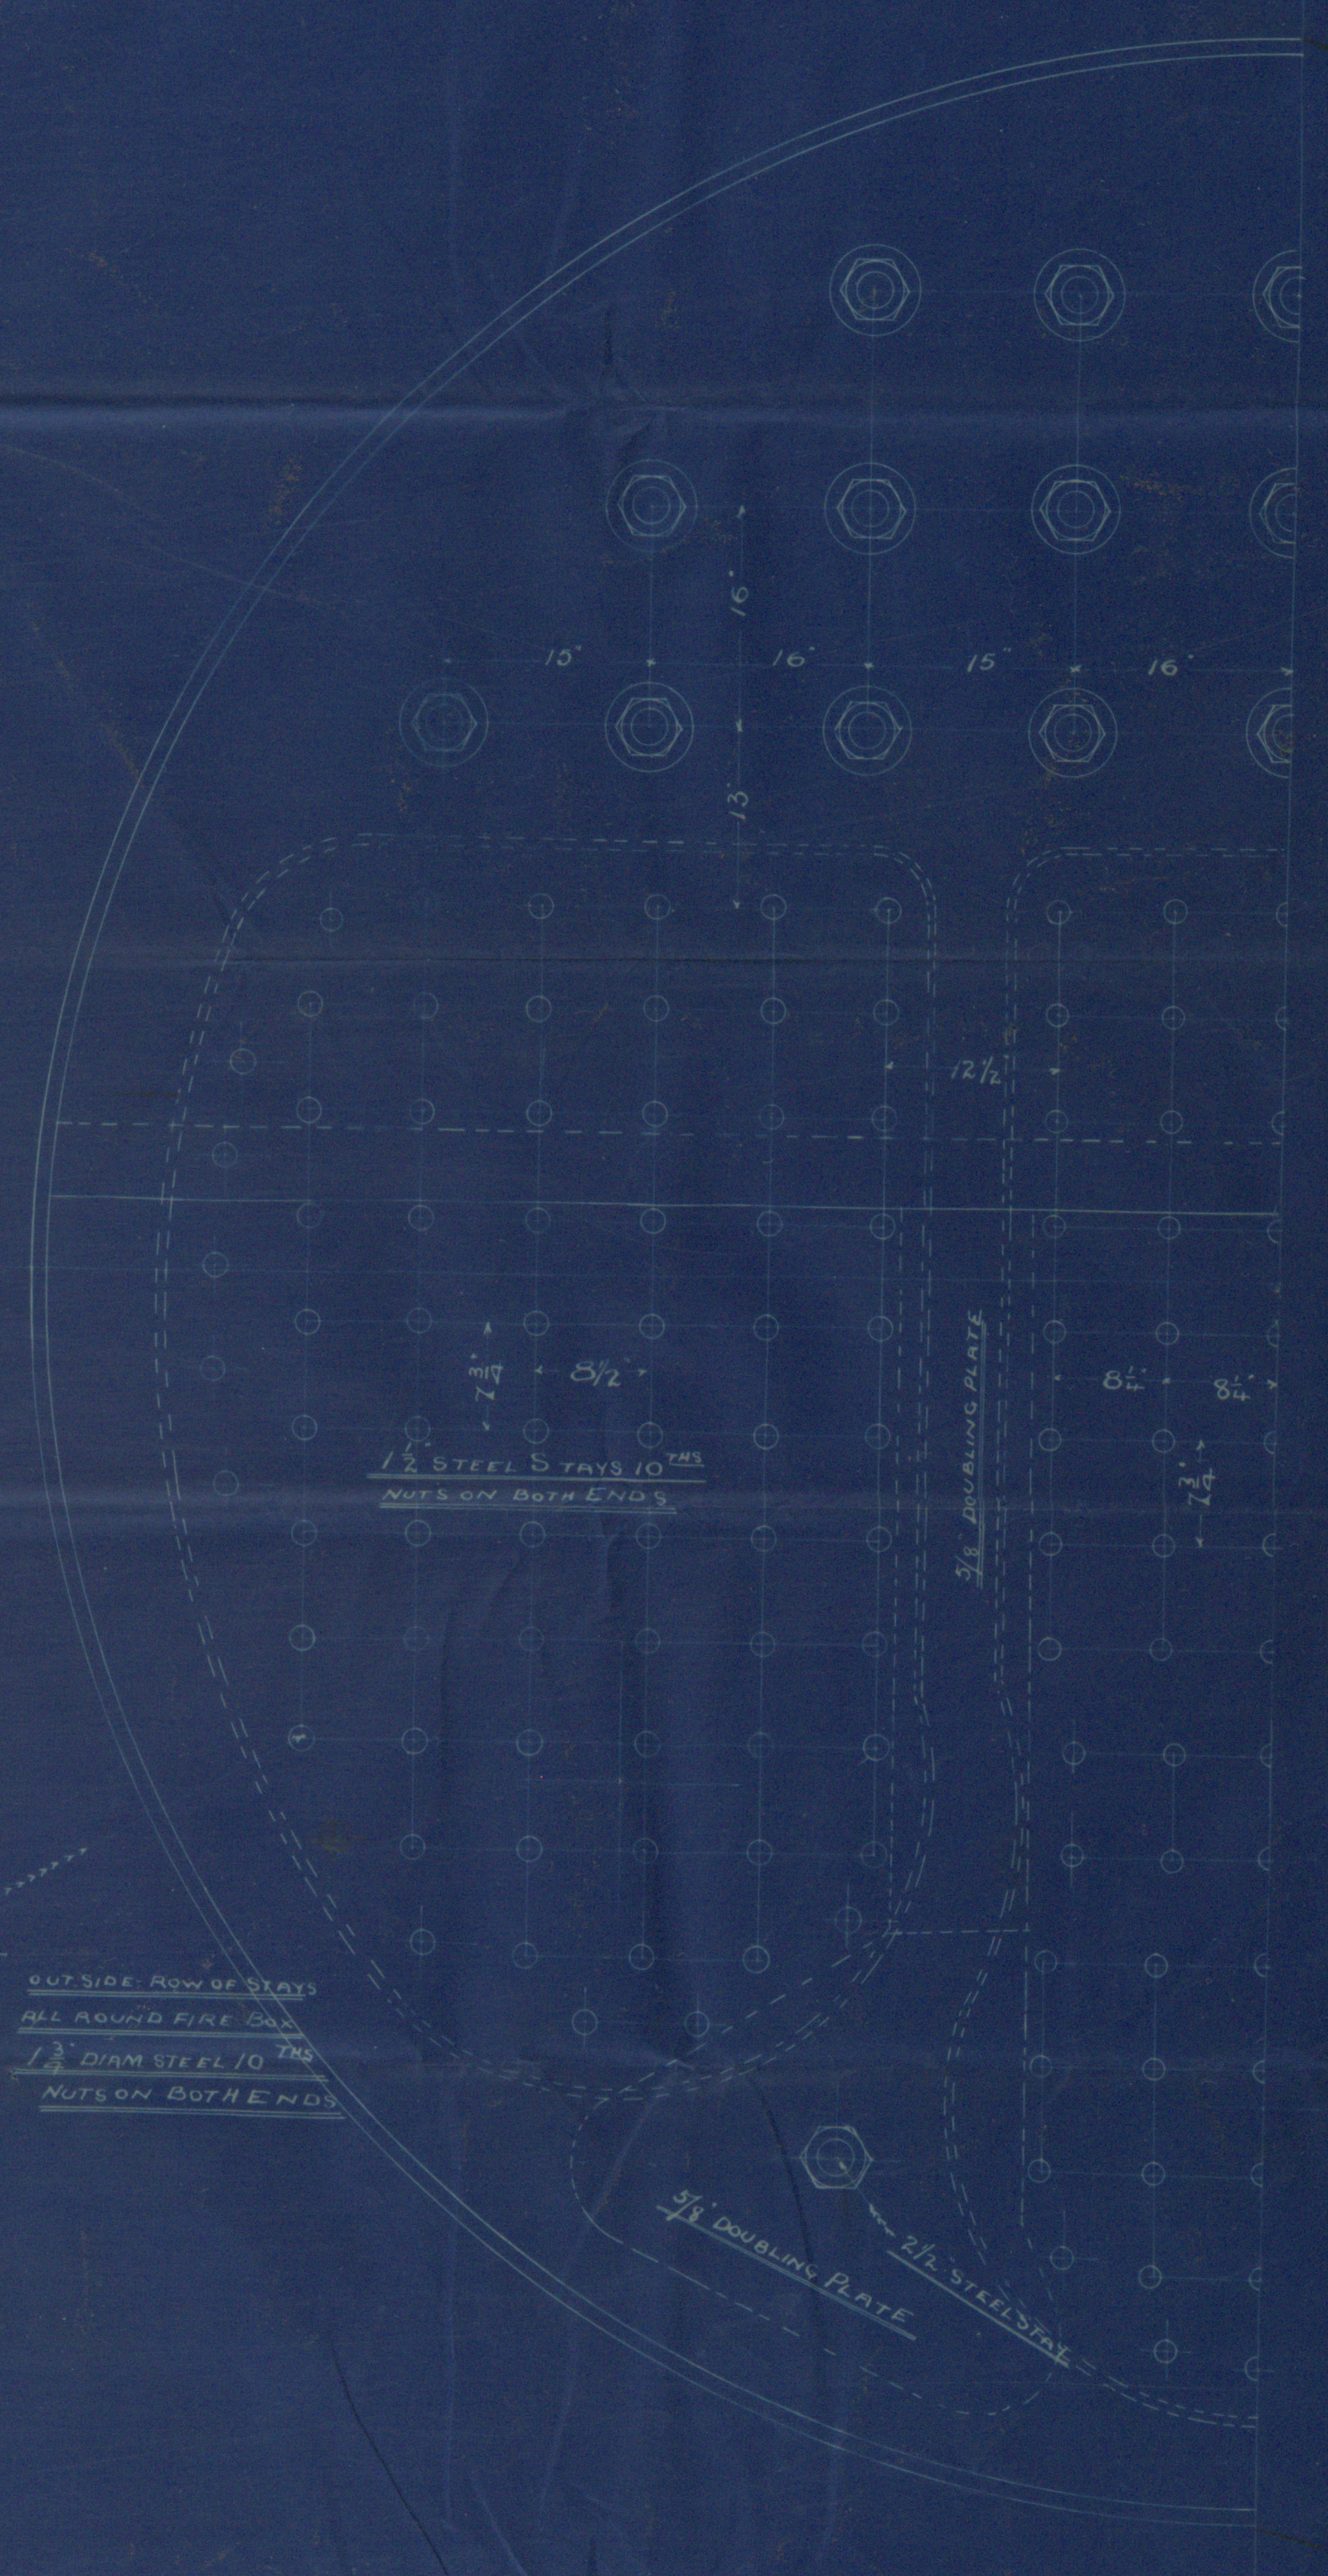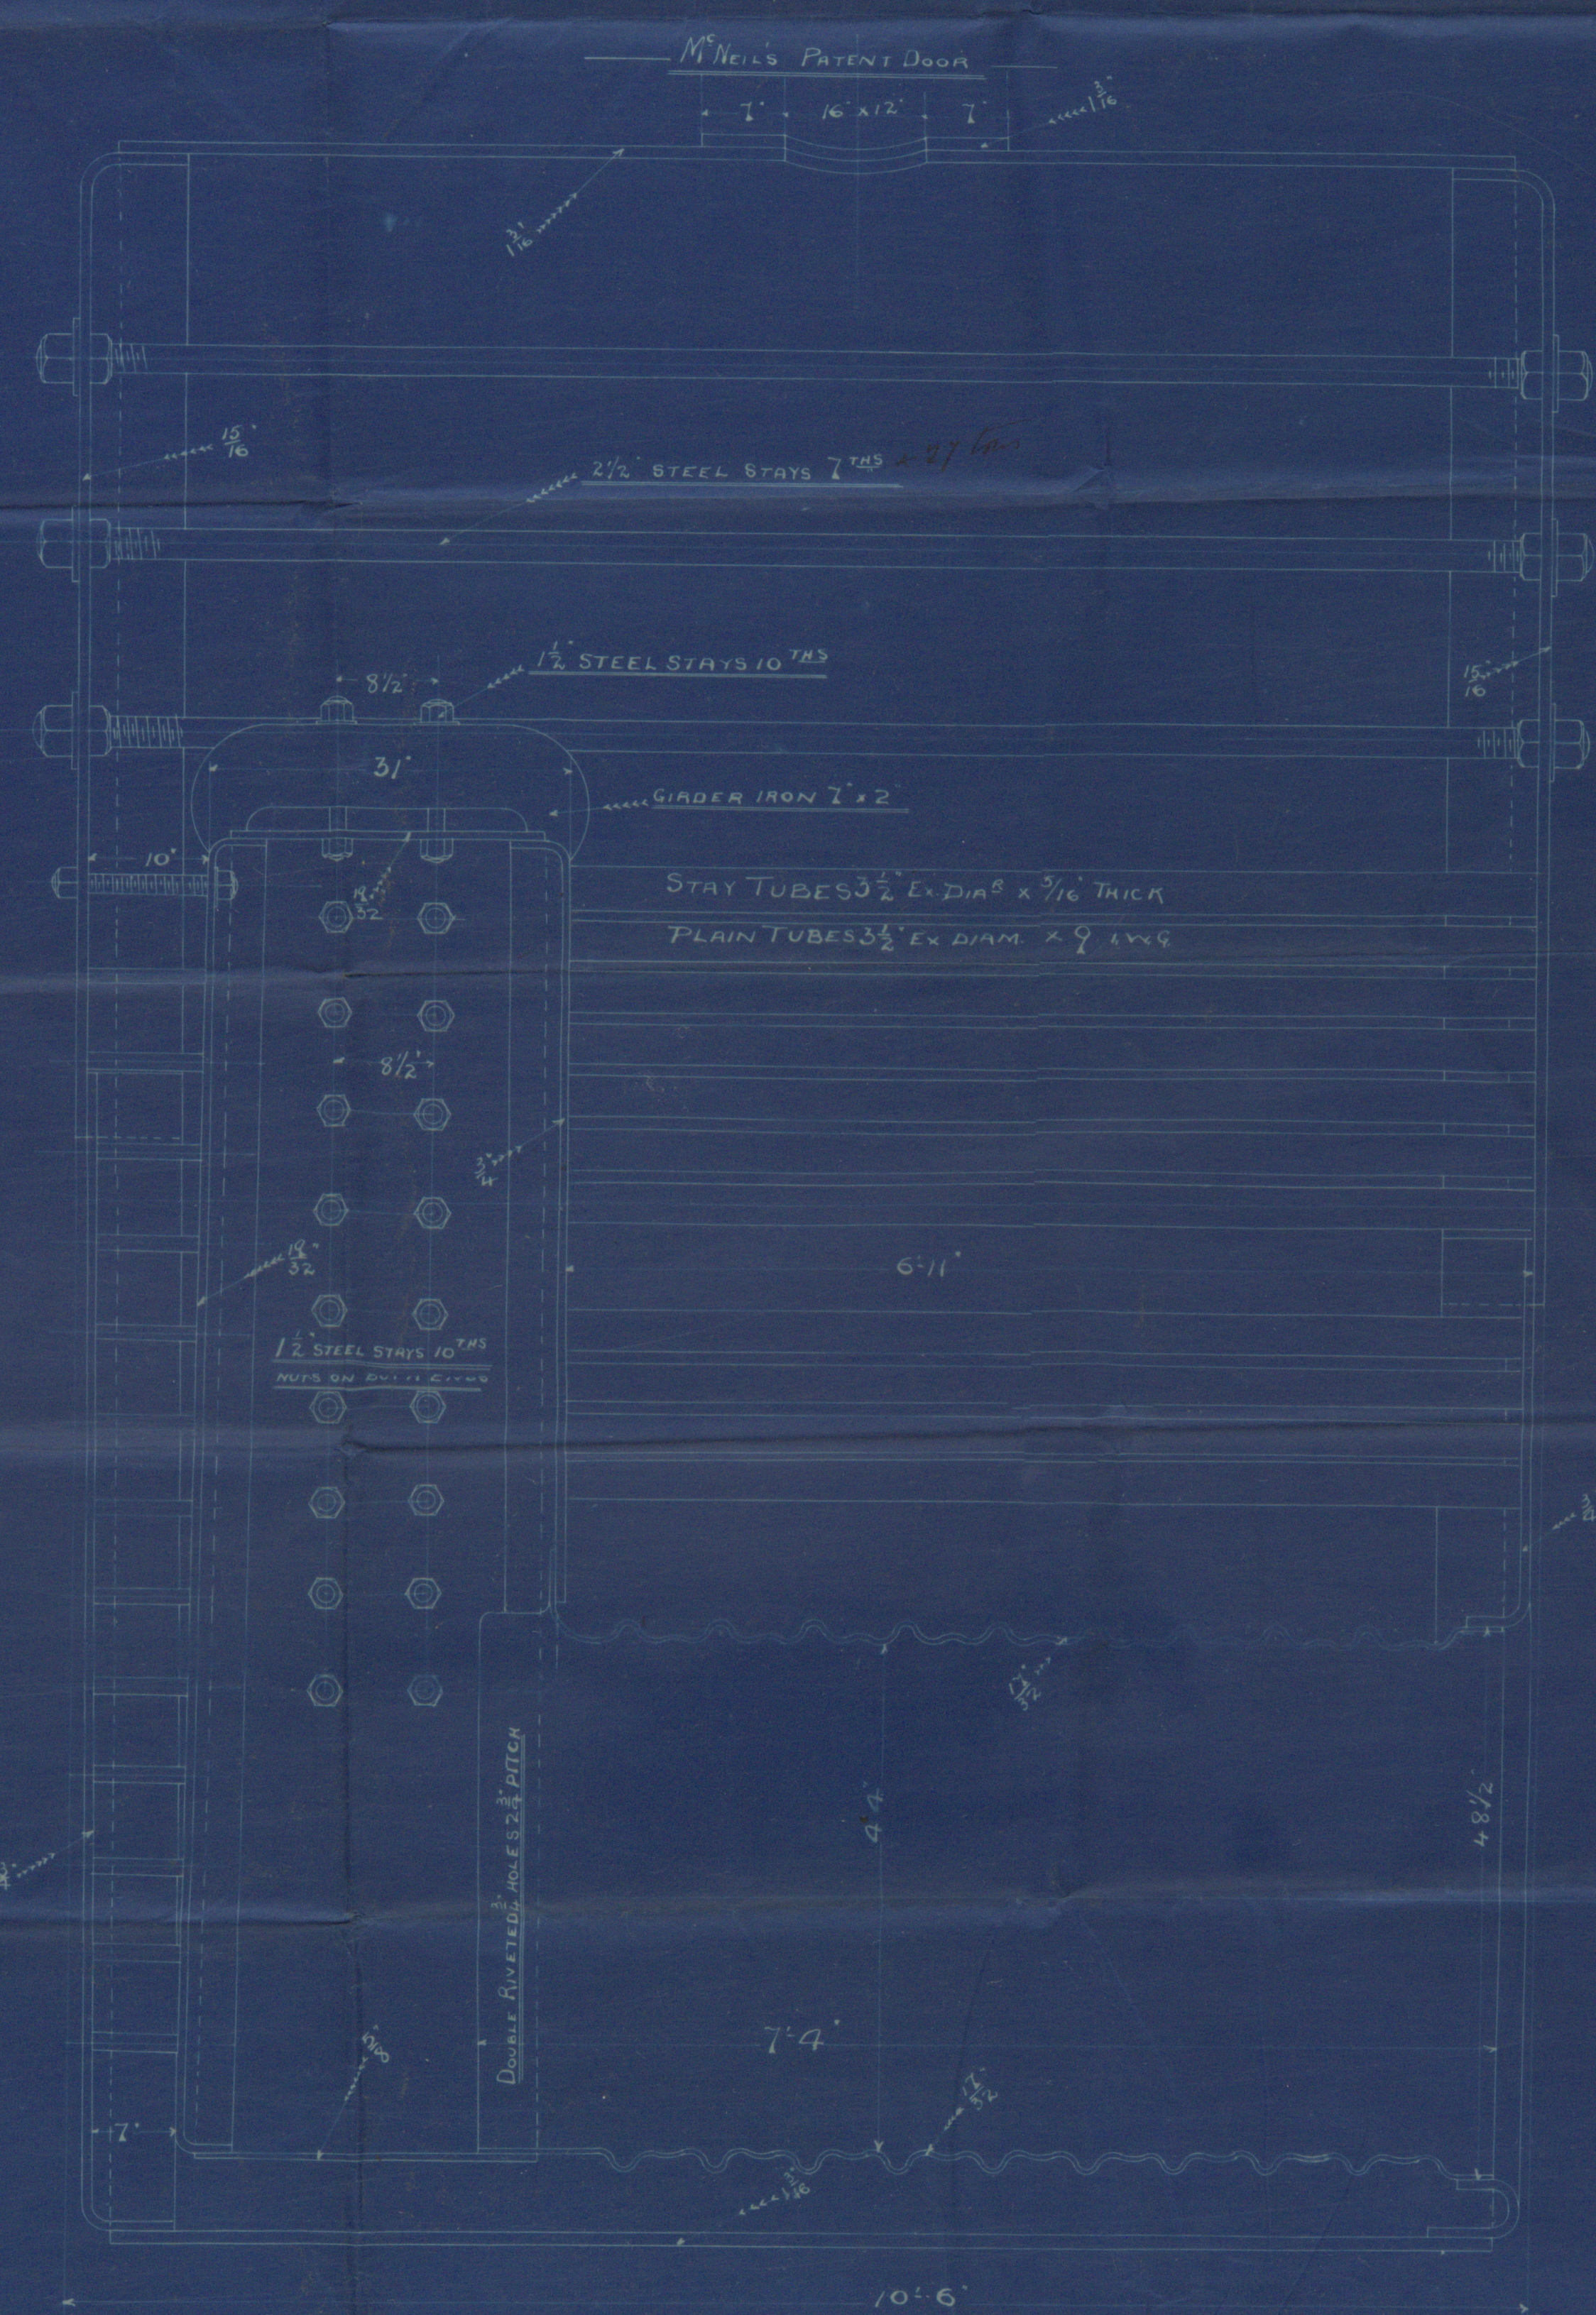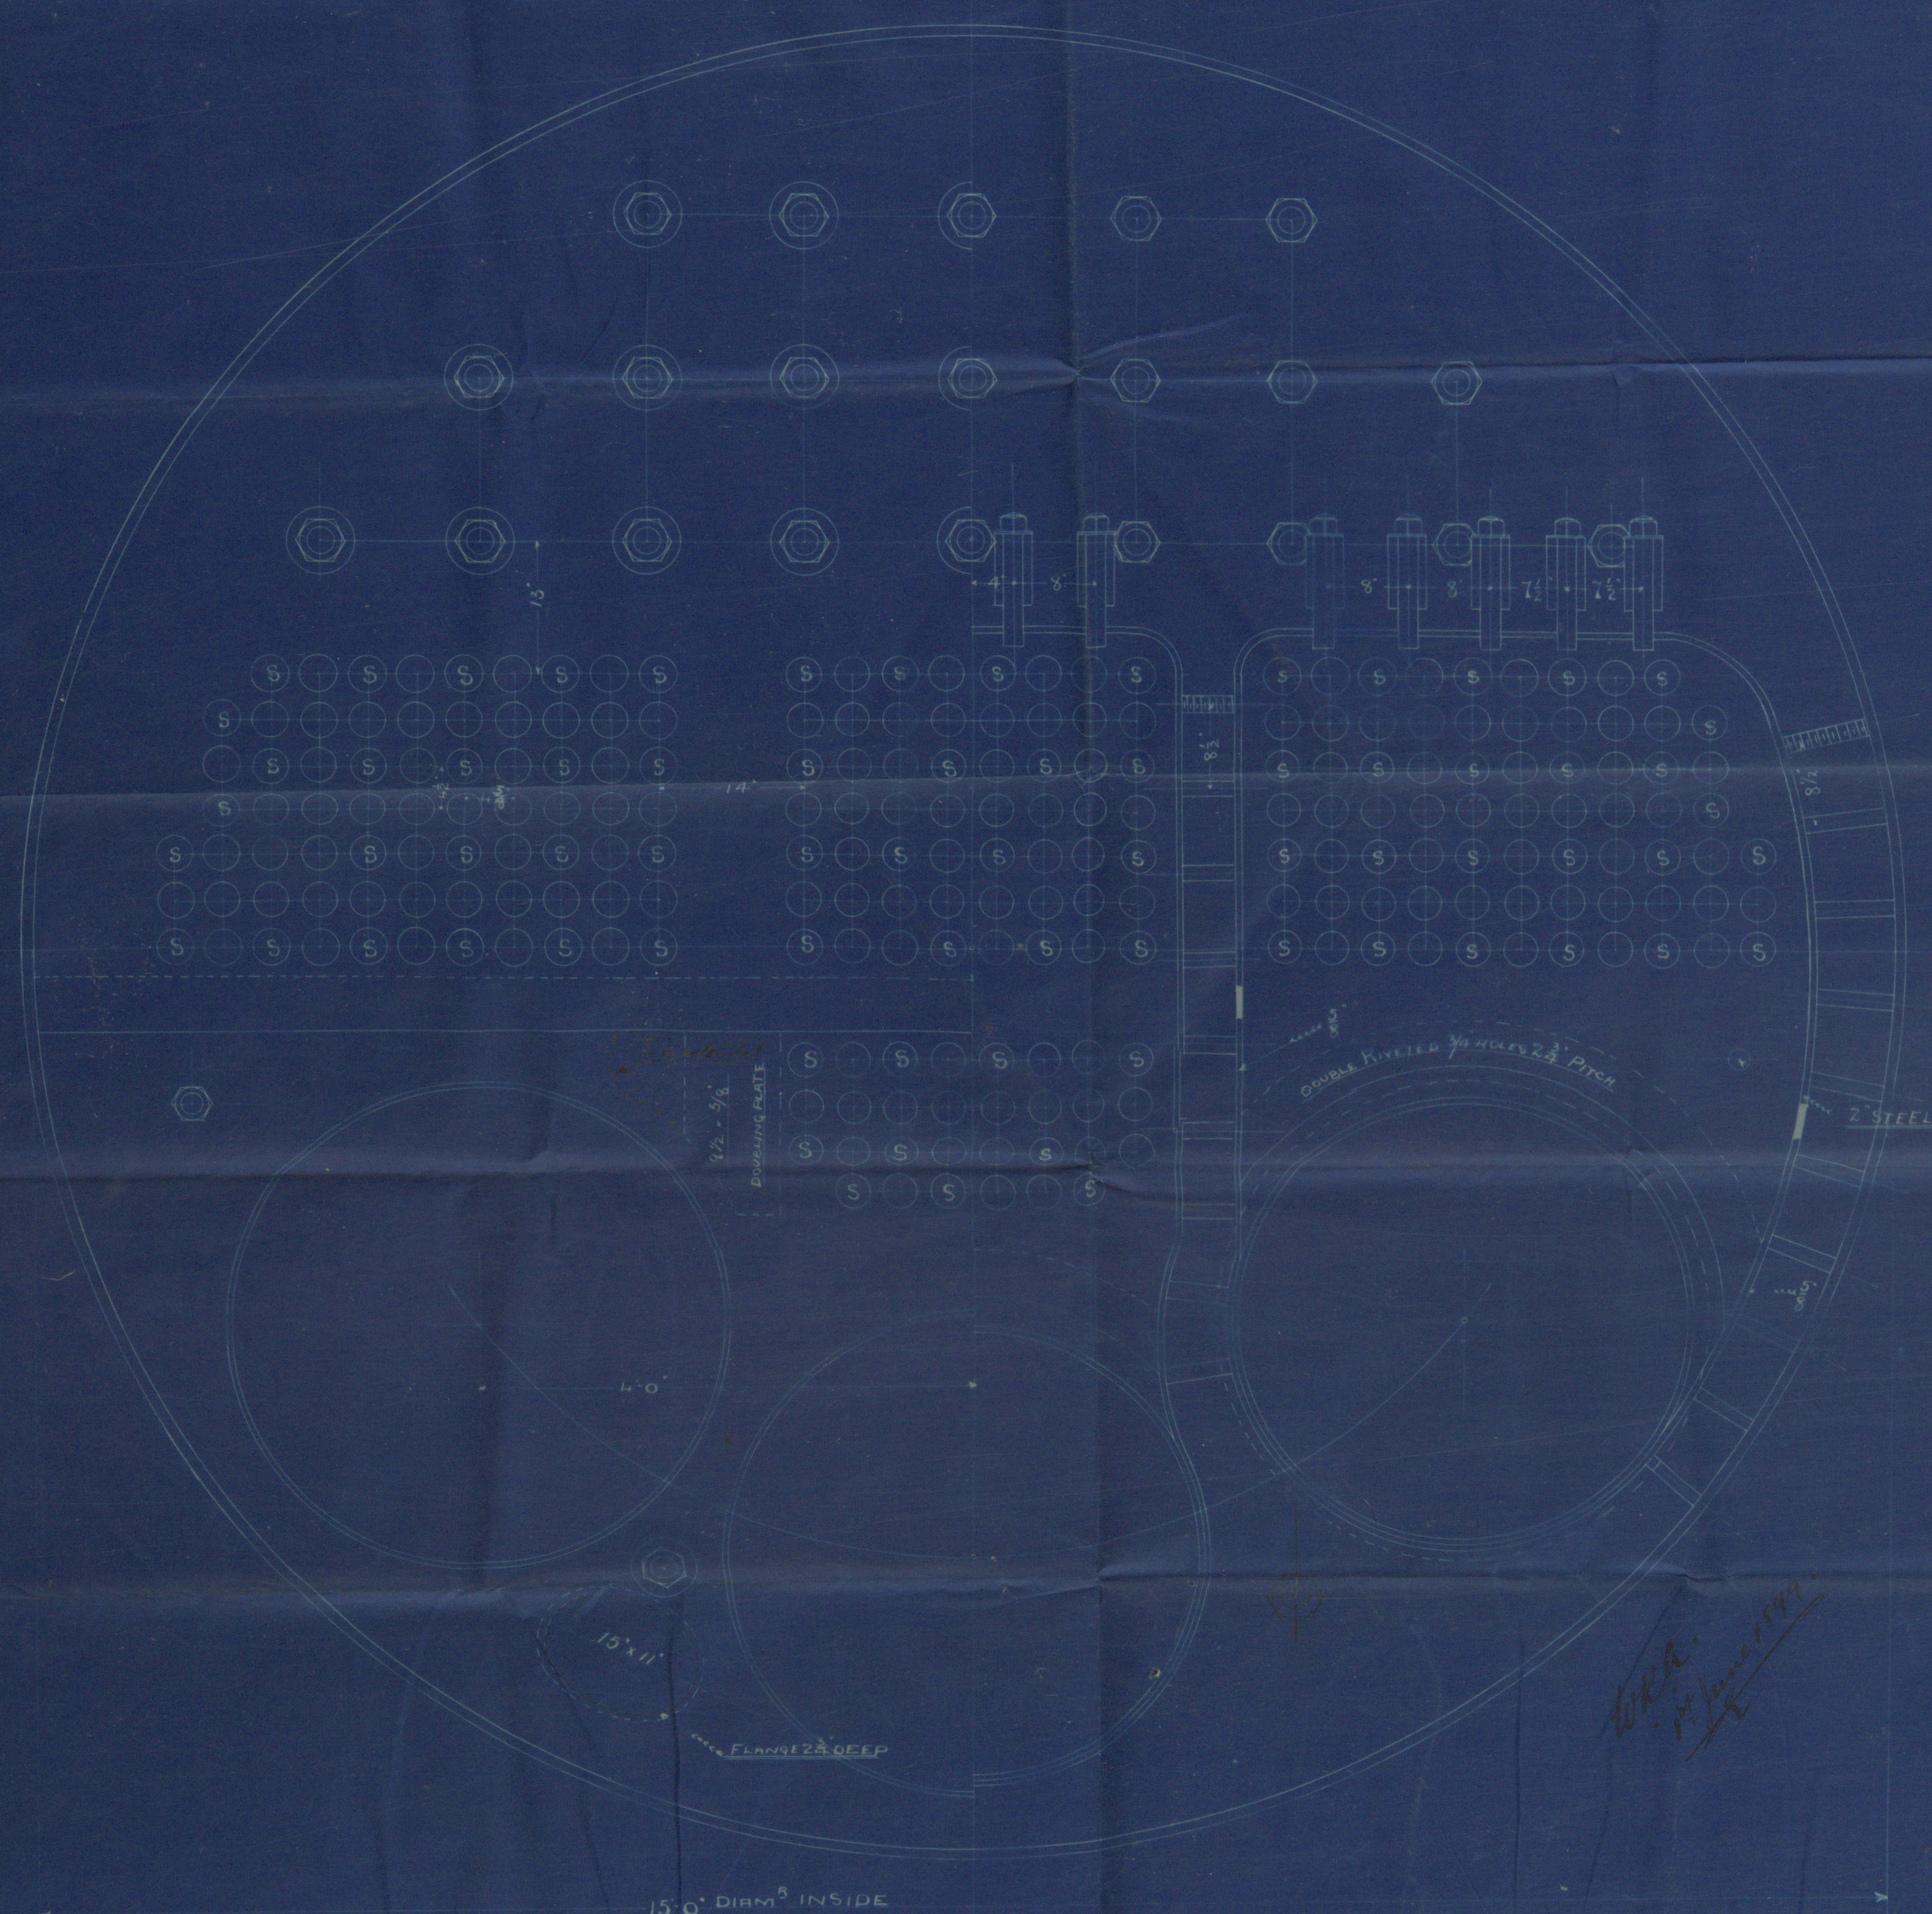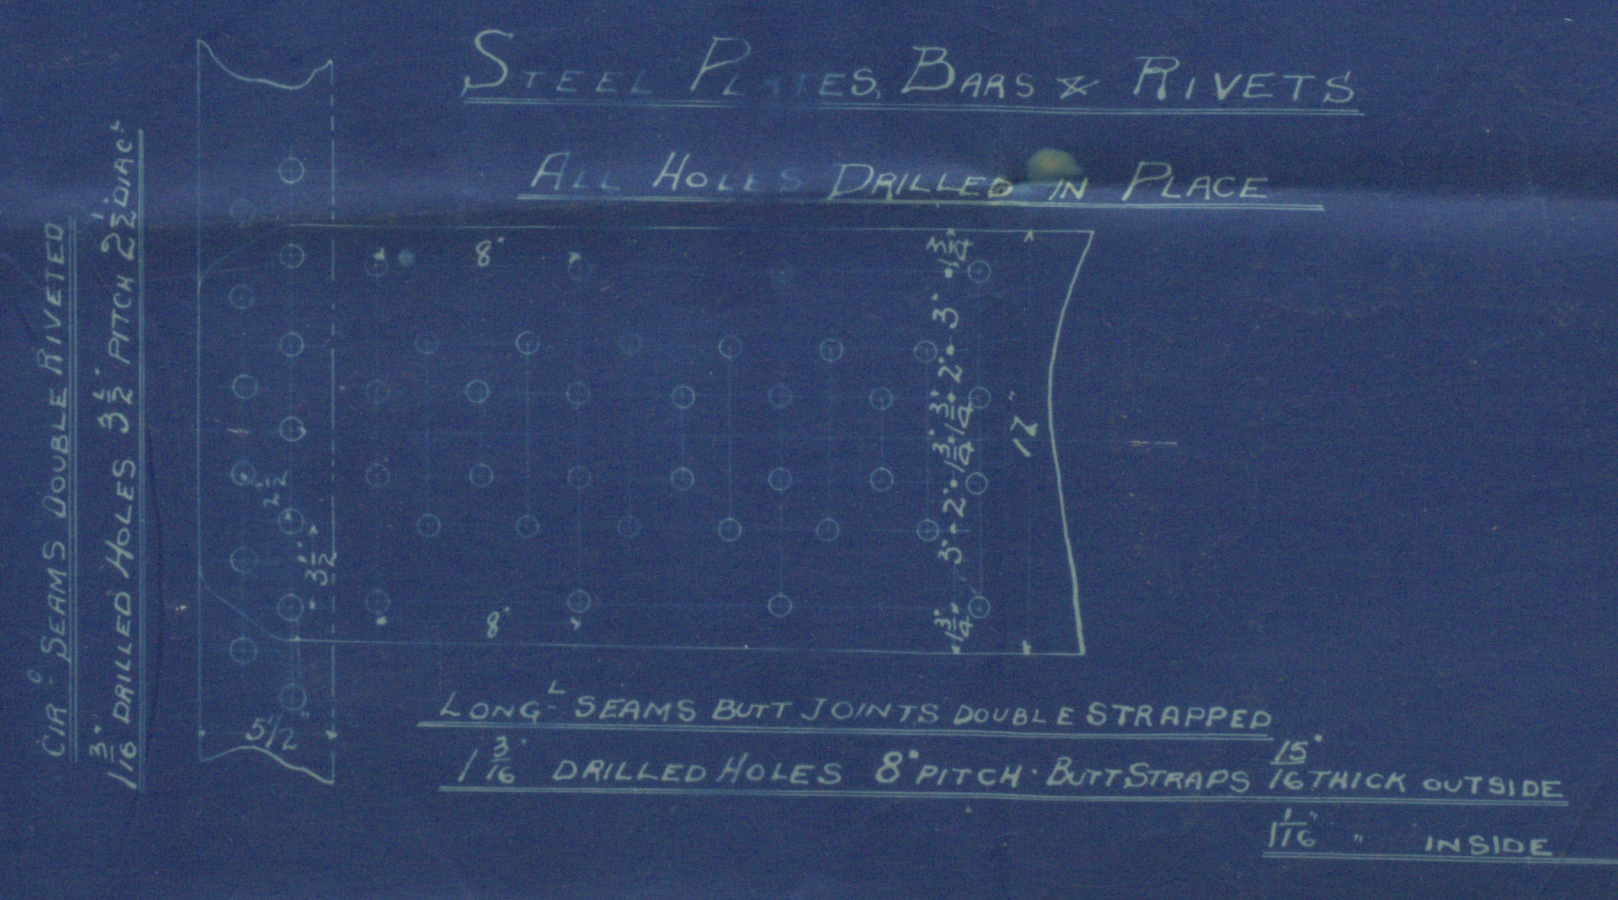

BOILER N° 148
WORKING PRESSURE 160 LBS
SCALE 1 INCH = ONE FOOT

TO HAVE LLOYD'S CERTIFICATE

Build Steel Boiler by Messrs. H. & J. Duncan
for Messrs. J. H. Knight & Co. 11.55 vessel.
160 lbs. working pressure.

