

# Lloyd's Register of British and Foreign Shipping.

(Report on Vessel No. 17666 Port Glasgow)

## No. 7072 SHIP FORGINGS OR CASTINGS.

I have to report that the undermentioned Iron or Steel Forgings or Castings, manufactured by The Irvine Forge Coy of Irvine for the Vessel No. 58, being built by Messrs McKnight & Co of Ayr have been inspected by me as set forth below, and found to be, so far as can be seen, Sound & efficient

Mark on Forgings.

Lloyd's


No. 7072

W.H.

William Hamilton  
Glasgow

	STERN FRAME.	RUDDER FRAME.	STEM.
Material*	...	<u>Scrap iron</u>	<u>9</u>
How made	...	<u>Forged</u>	
Dimensions	...	<u>4 3/4 to 3 3/8 x 3 7/8</u>	
Progress on Inspection		<u>Forging &amp; smithing</u>	
Date when Inspected		<u>22/8/99 to 24/10/99</u>	

SKETCHES OF FRAMES SHOWING POSITION AND DESCRIPTION OF WELDS OF FORGINGS, OR PARTICULARS OF TESTS APPLIED TO CASTINGS.

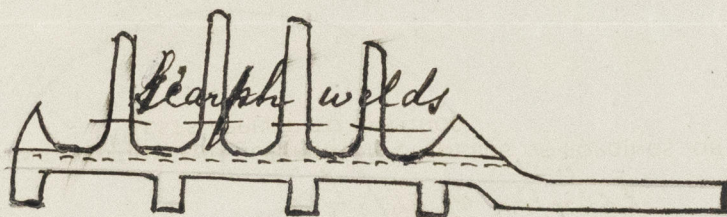

Fee (if any chargeable) £ : :

To be paid at



© 2019

Lloyd's Register  
Foundation  
GLS285-0085